

Per. - No 13371.


MIDSHIP SECTION N°169 SHIP

FOR 100A THREE DECK AT LLOYDS

Rec 23/10/76 & 27/10/76

2/11/76

Length (over)	284.0
Beam Moulded	33.6
Depth in Hold	24.4
Scale	$\frac{1}{2} = 1.0$

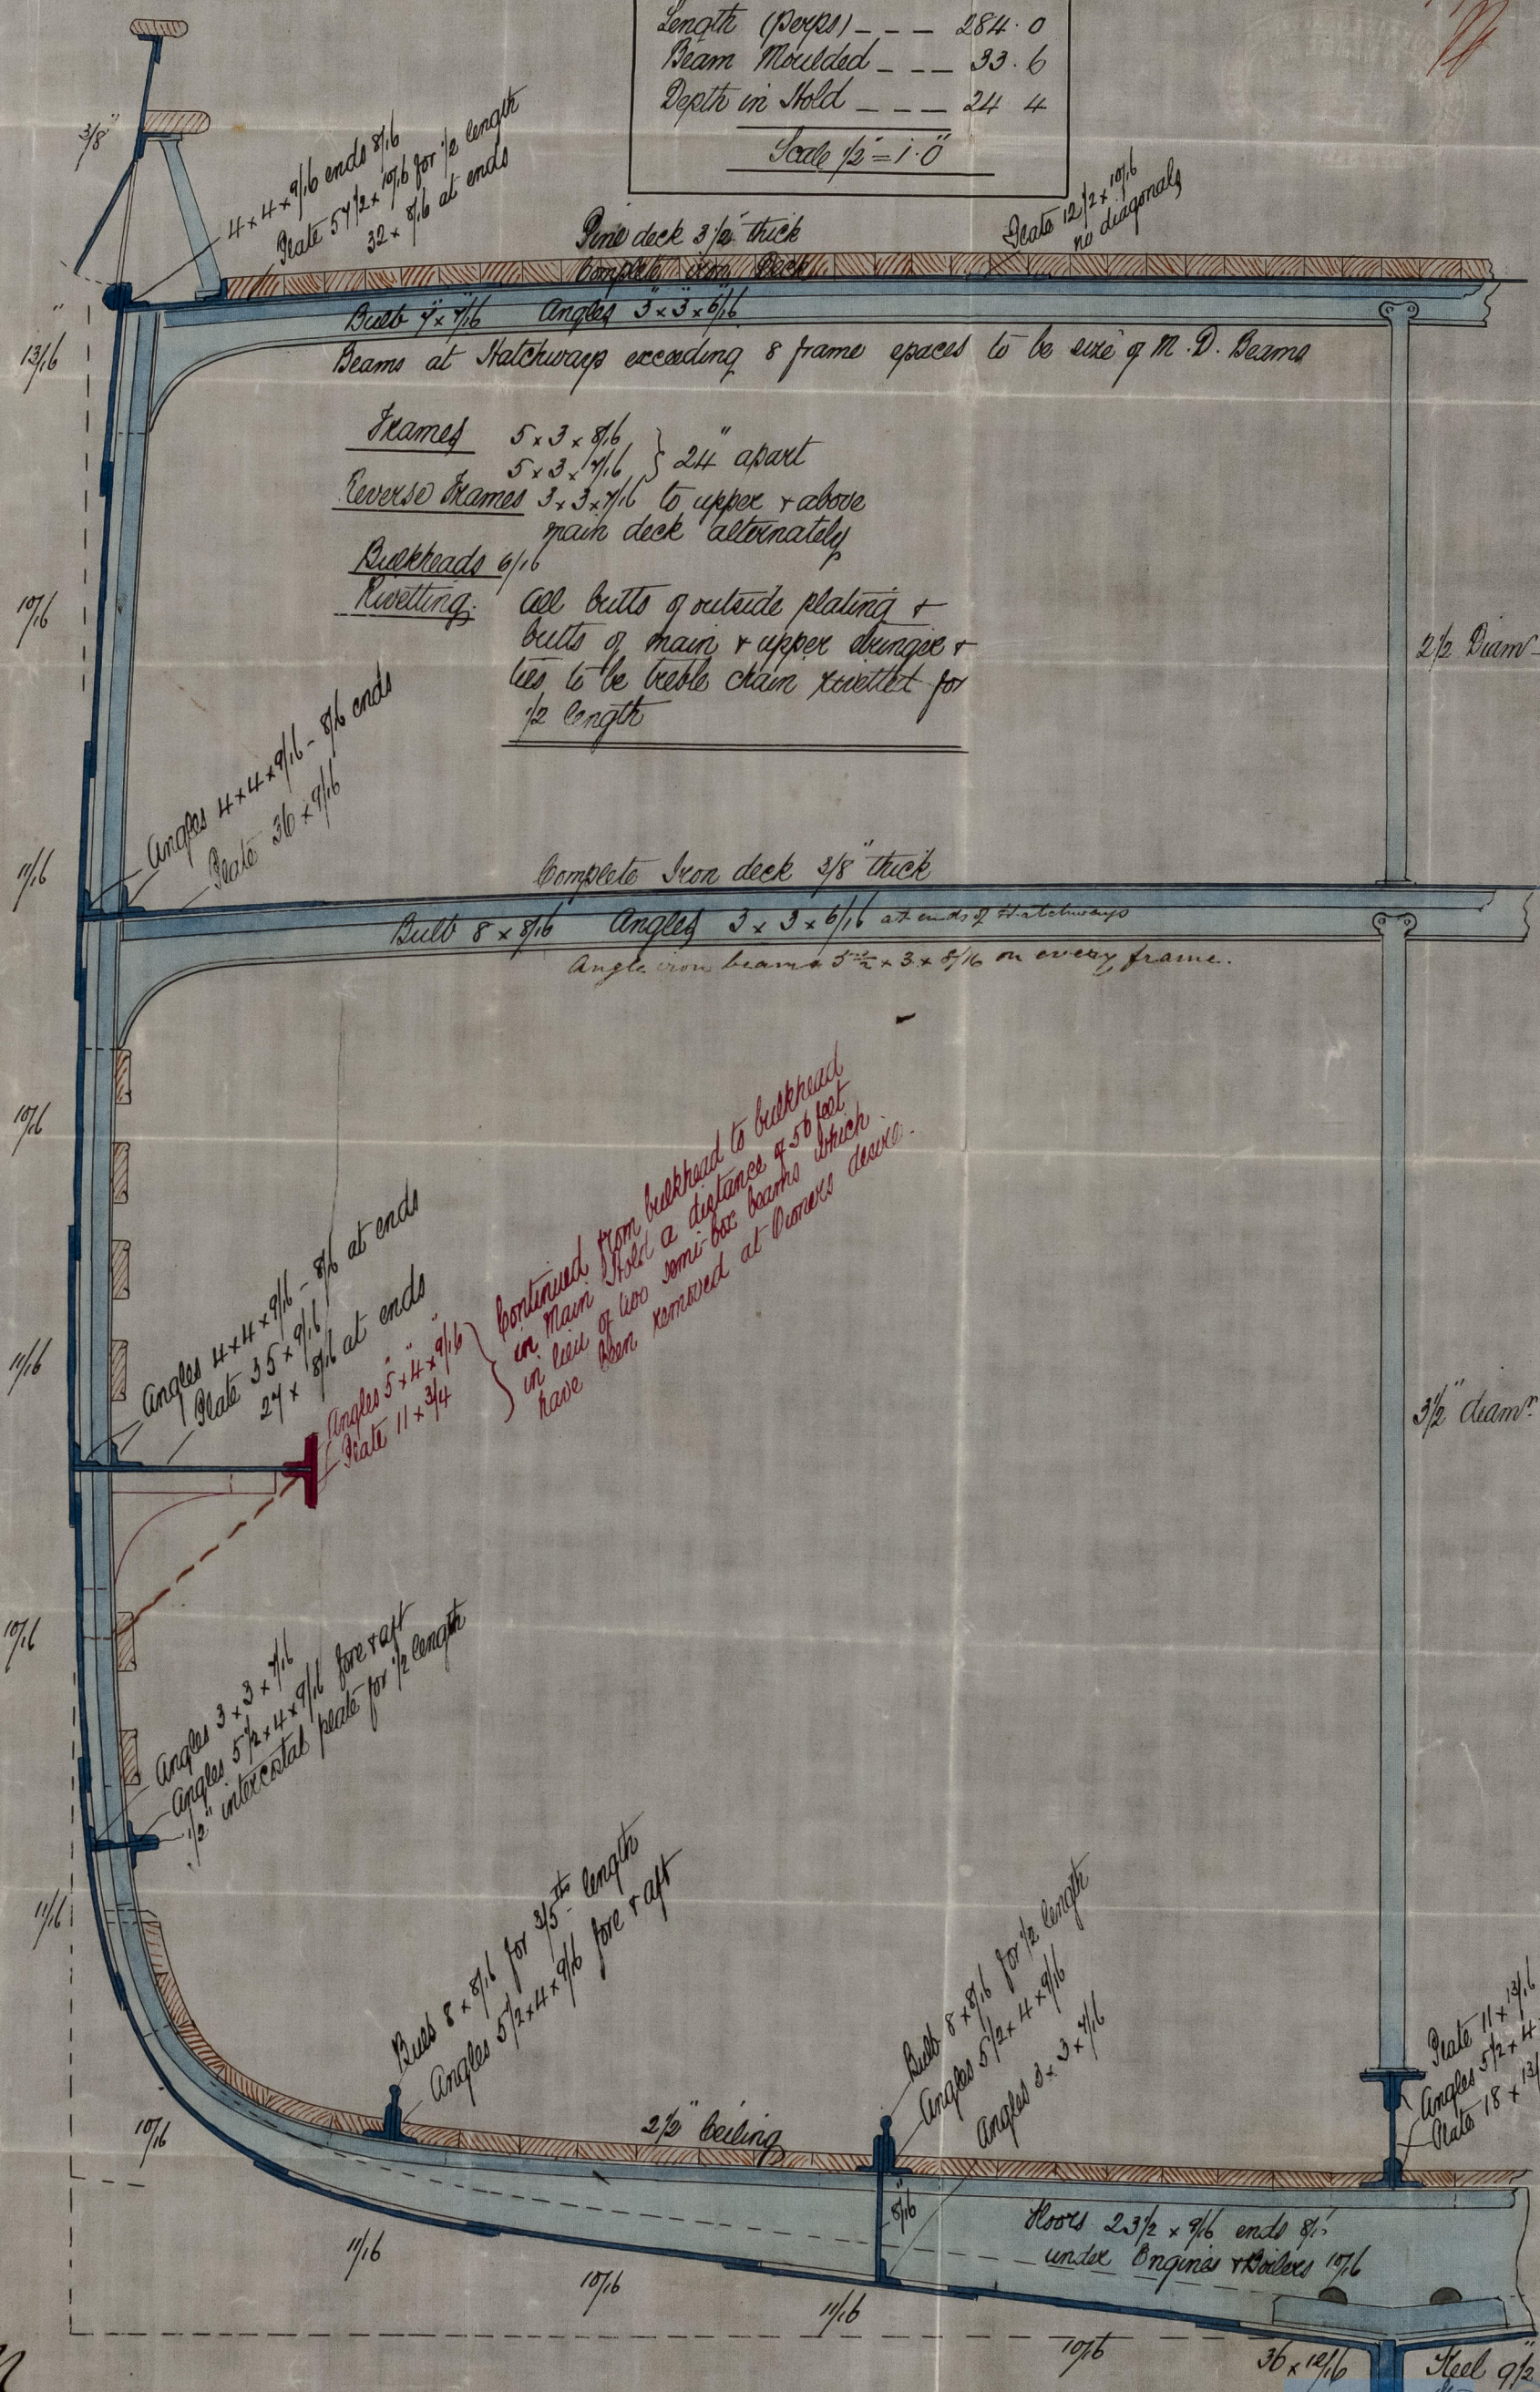

*B.M.
1/11/76*