


"Pera". - Report No. 13371.

Longitudinal Section for Iron Screw Steamer Pera N<sup>o</sup>. 169

Rev 27/10/76  
R

Scale 1/8" = 1.0 foot.

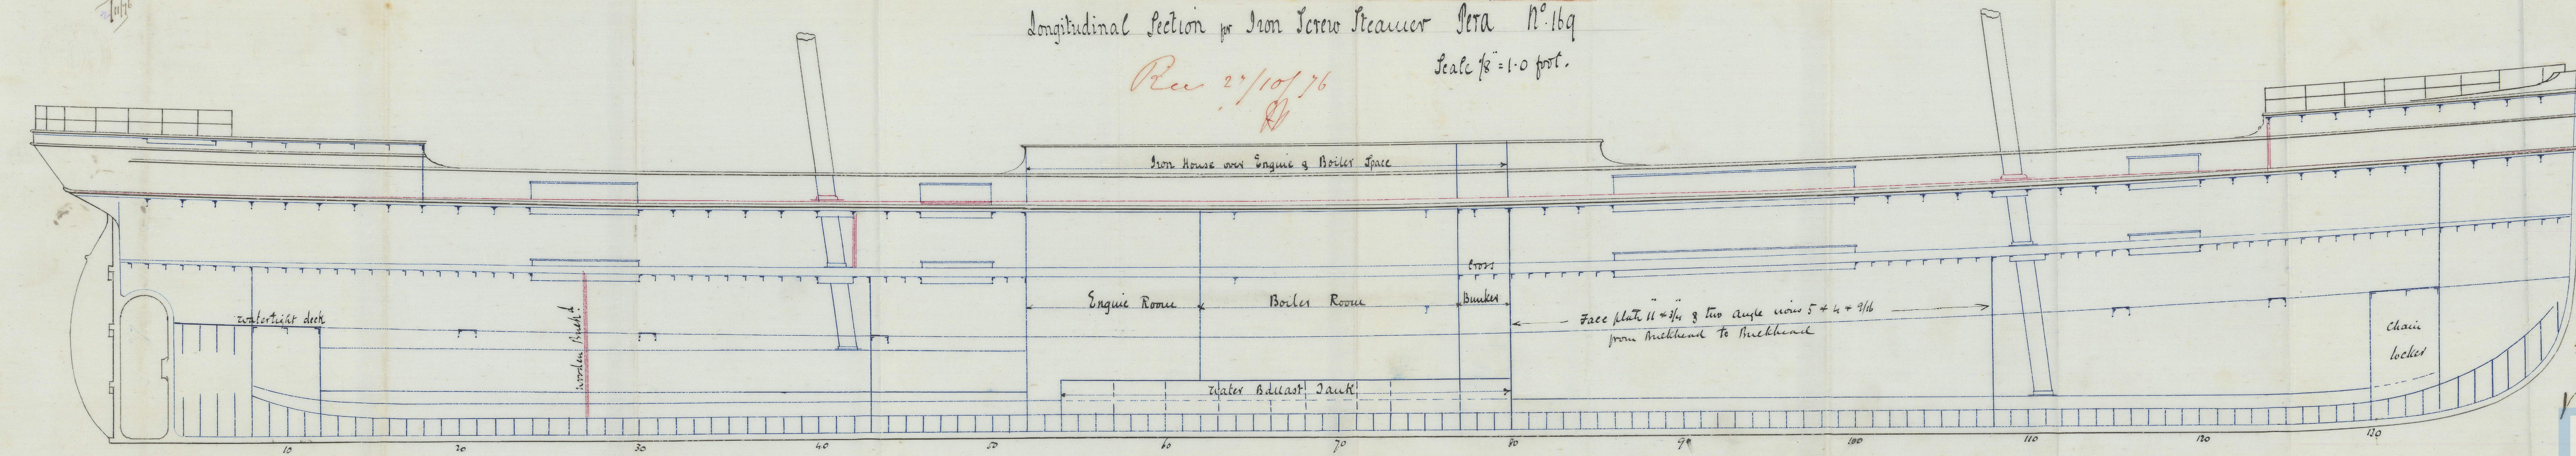

24/10/76

V.B.M.

1/11/76