


Scale 1/4 inch = foot. S.S. 54.

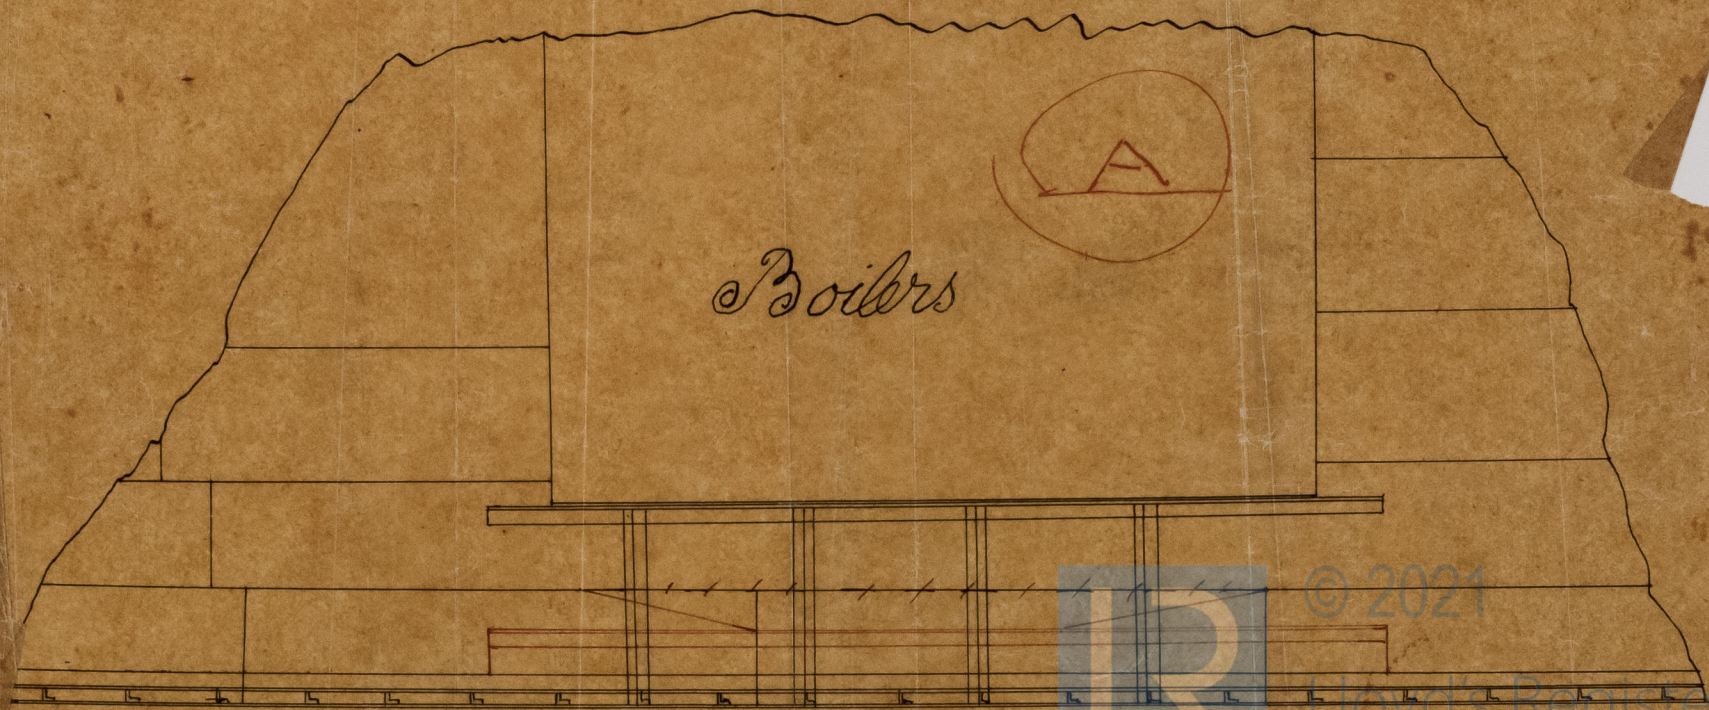

Boilers

IRON 518-0144



© 2021

Lloyd's Register  
Foundation