

28<sup>th</sup> Dec<sup>r</sup> 1845.


**COLE BROTHERS.**  
IRON SHIPBUILDERS  
WILLINGTON QUAY ON TYNE

**MIDSHIP SECTION OF N° 36**

Scale  $\frac{1}{2}$  inch = 1 Foot.

CLASS 100-A-1

Rec 30/12/45

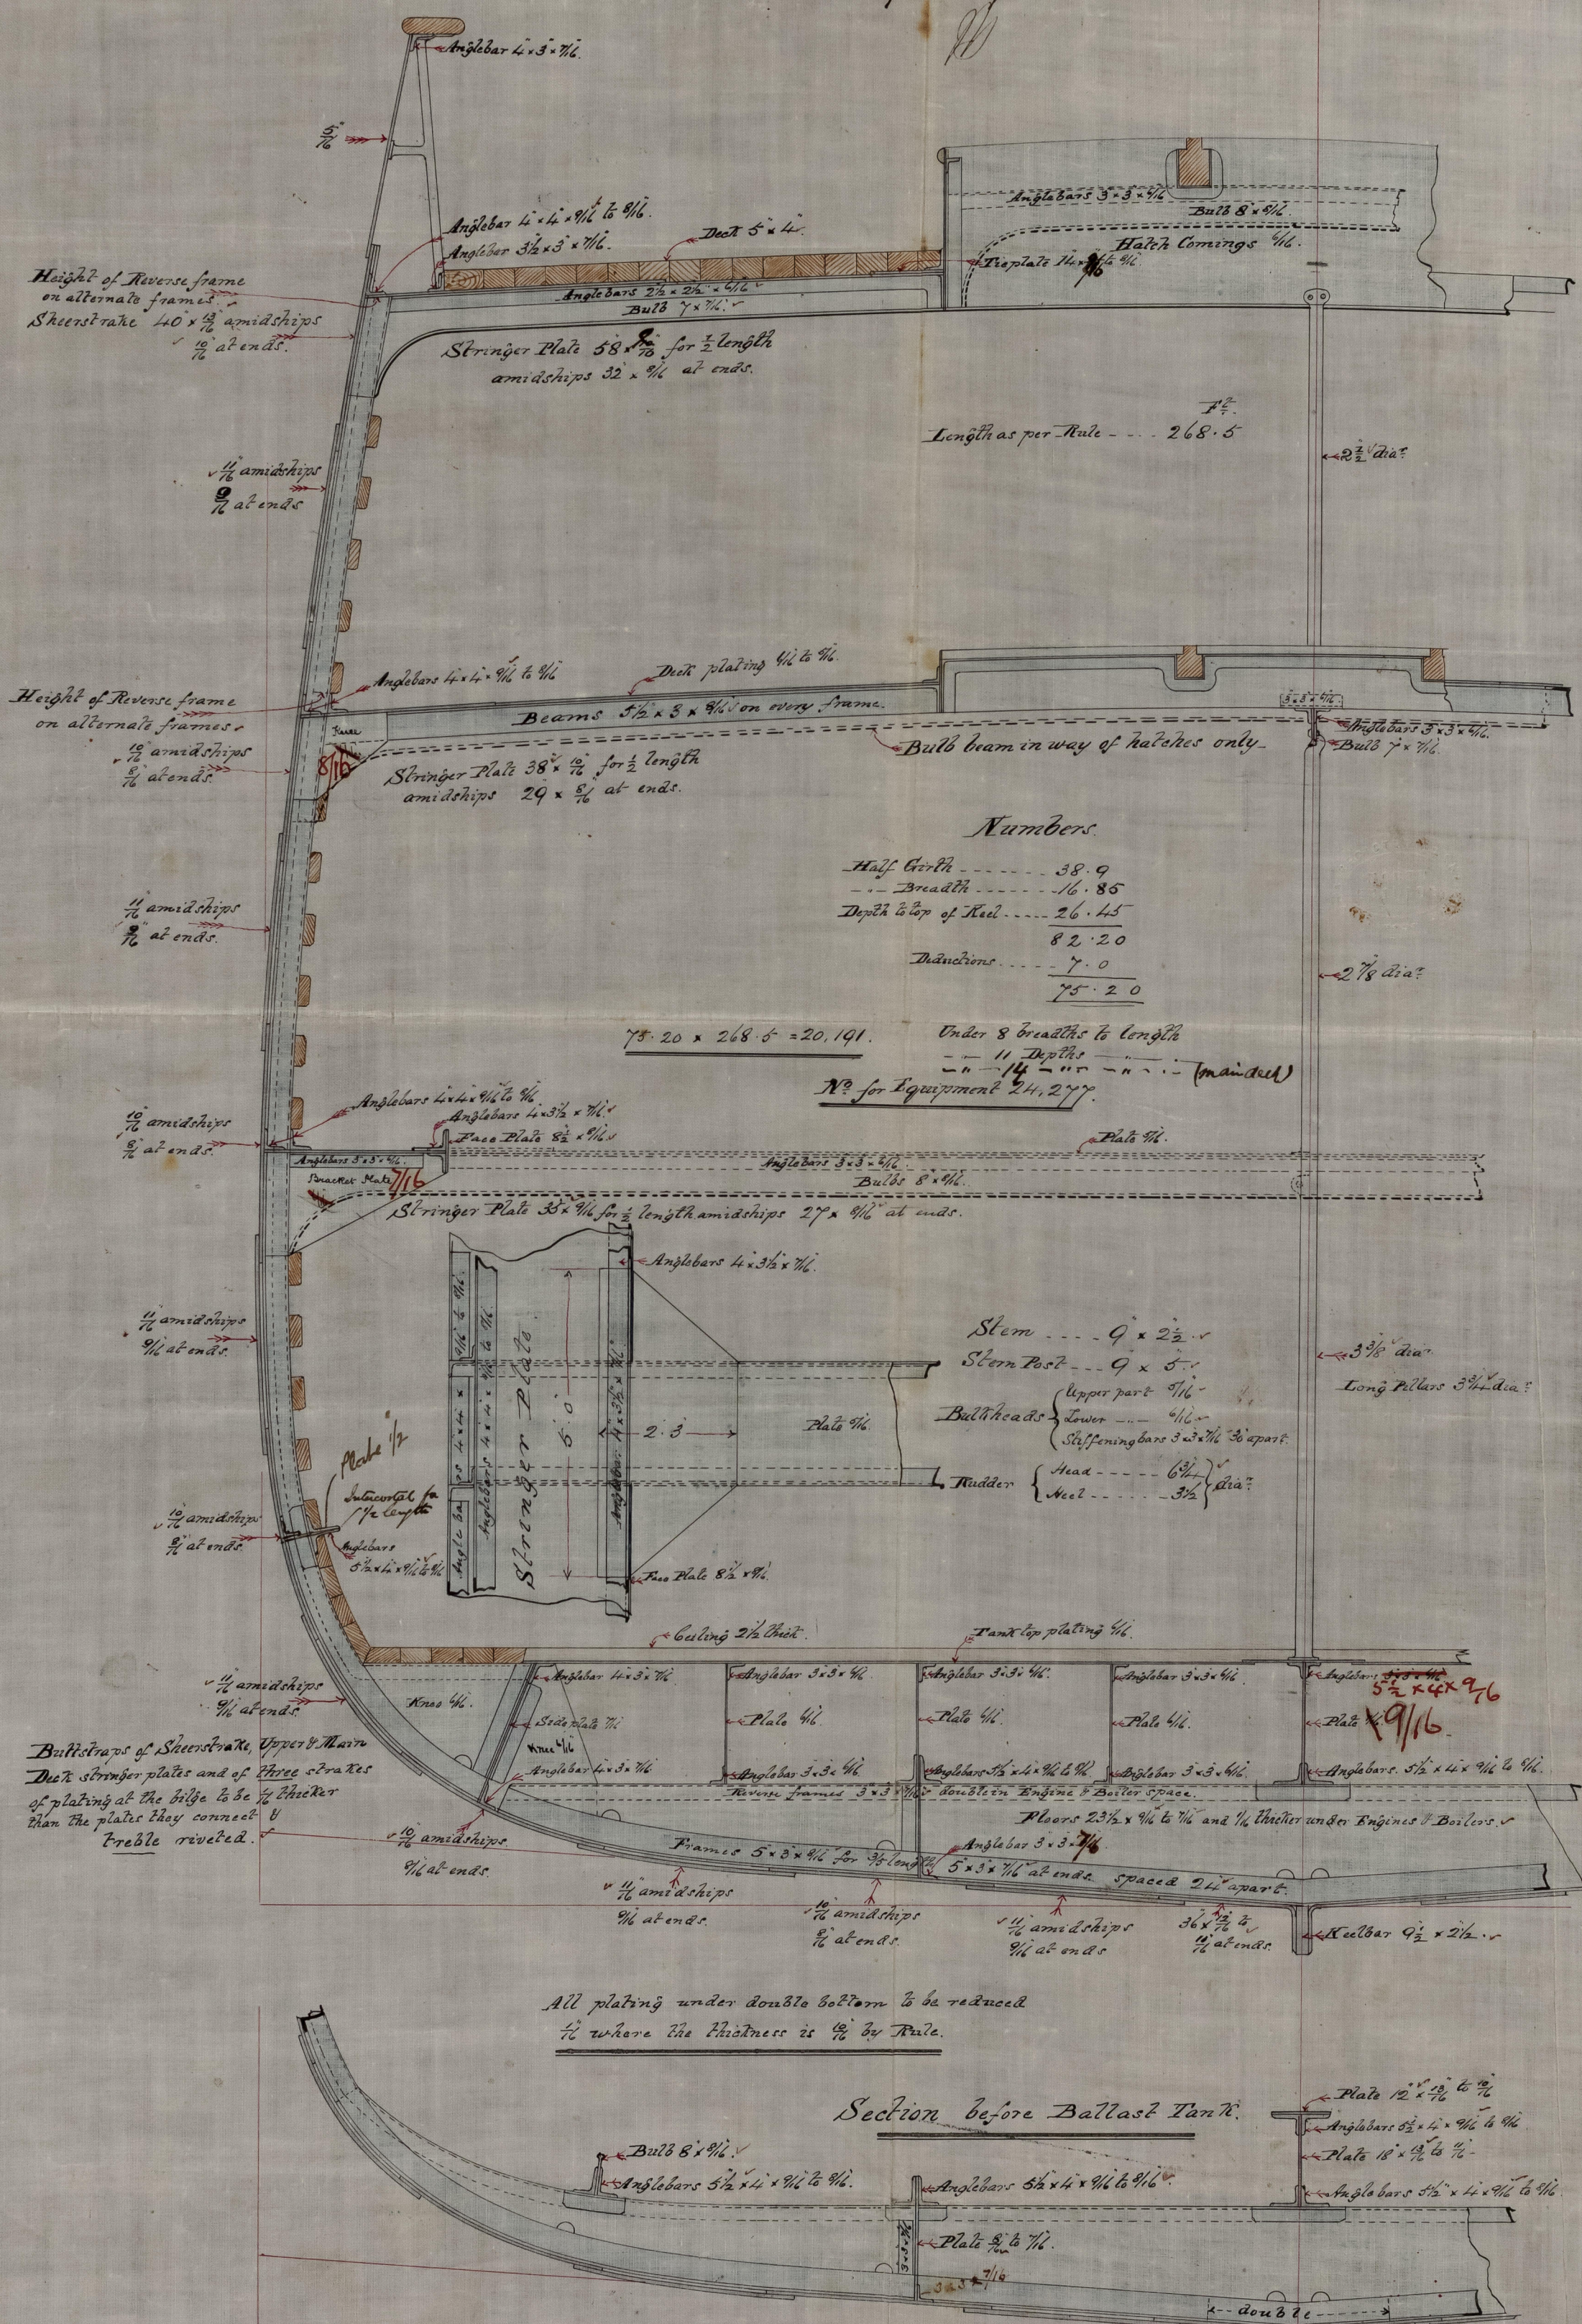

Water Ballast in After Hold also  
under Borters & Donkey Recess. see Profile.