
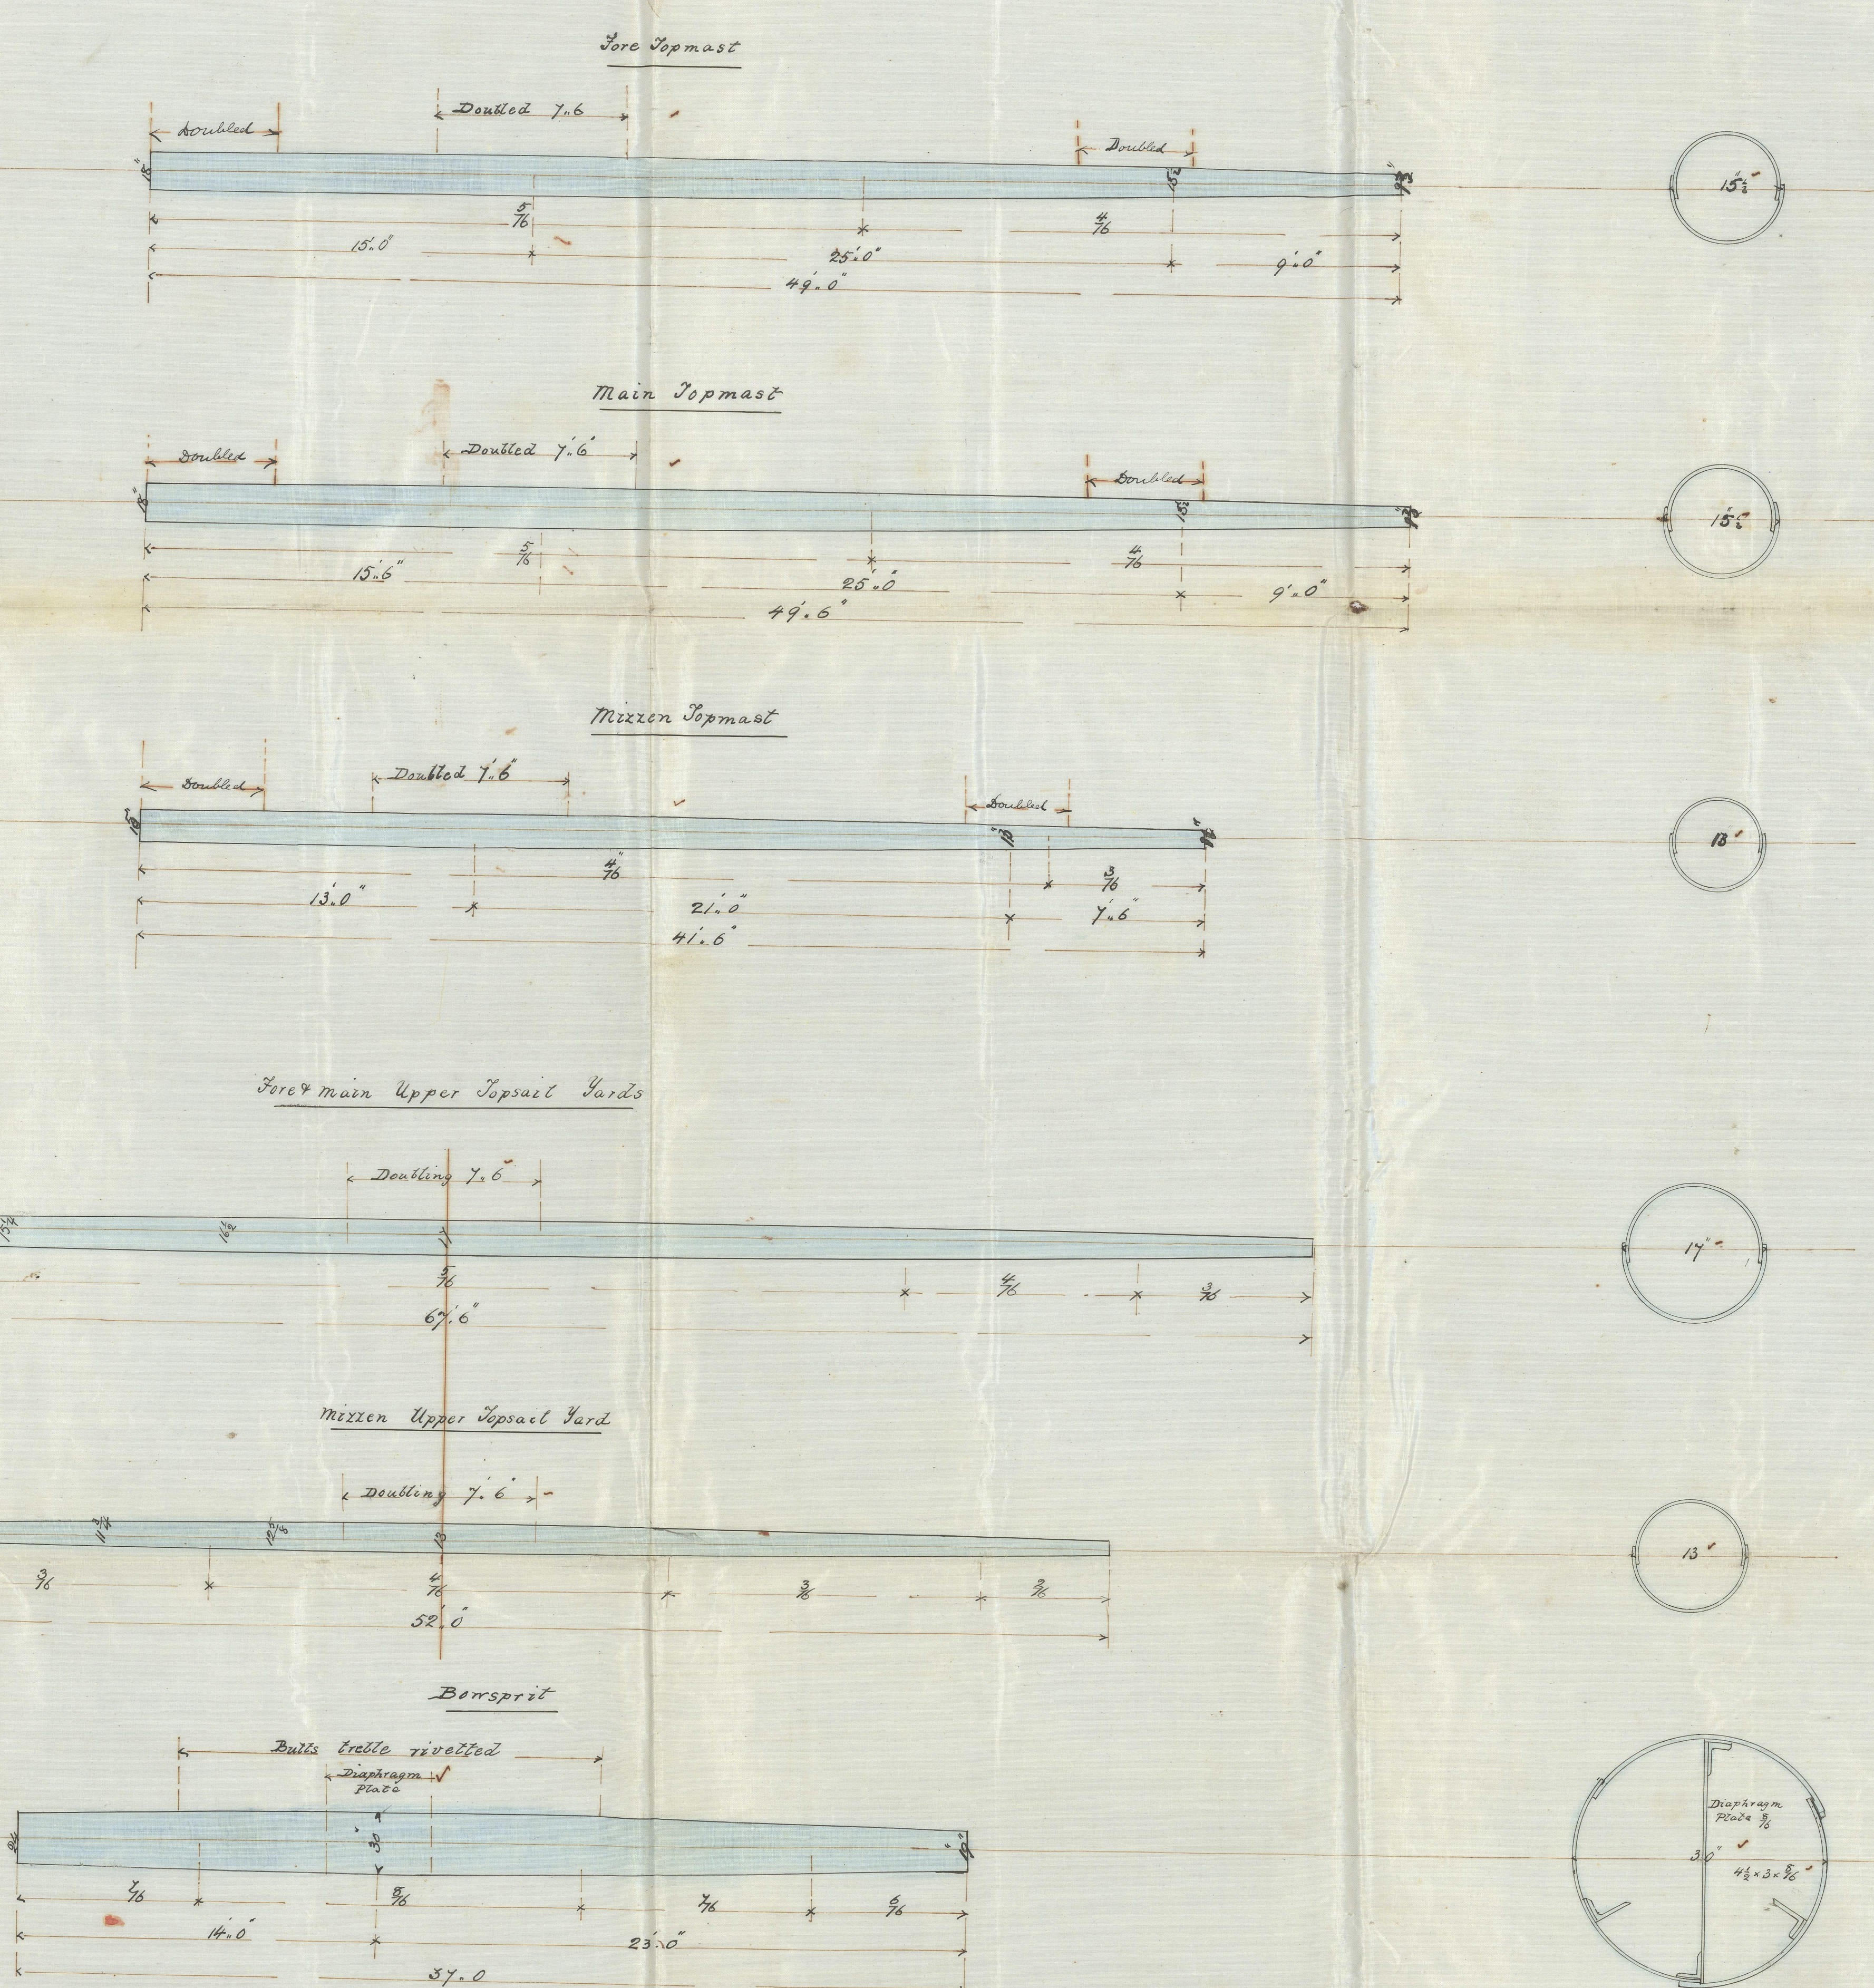
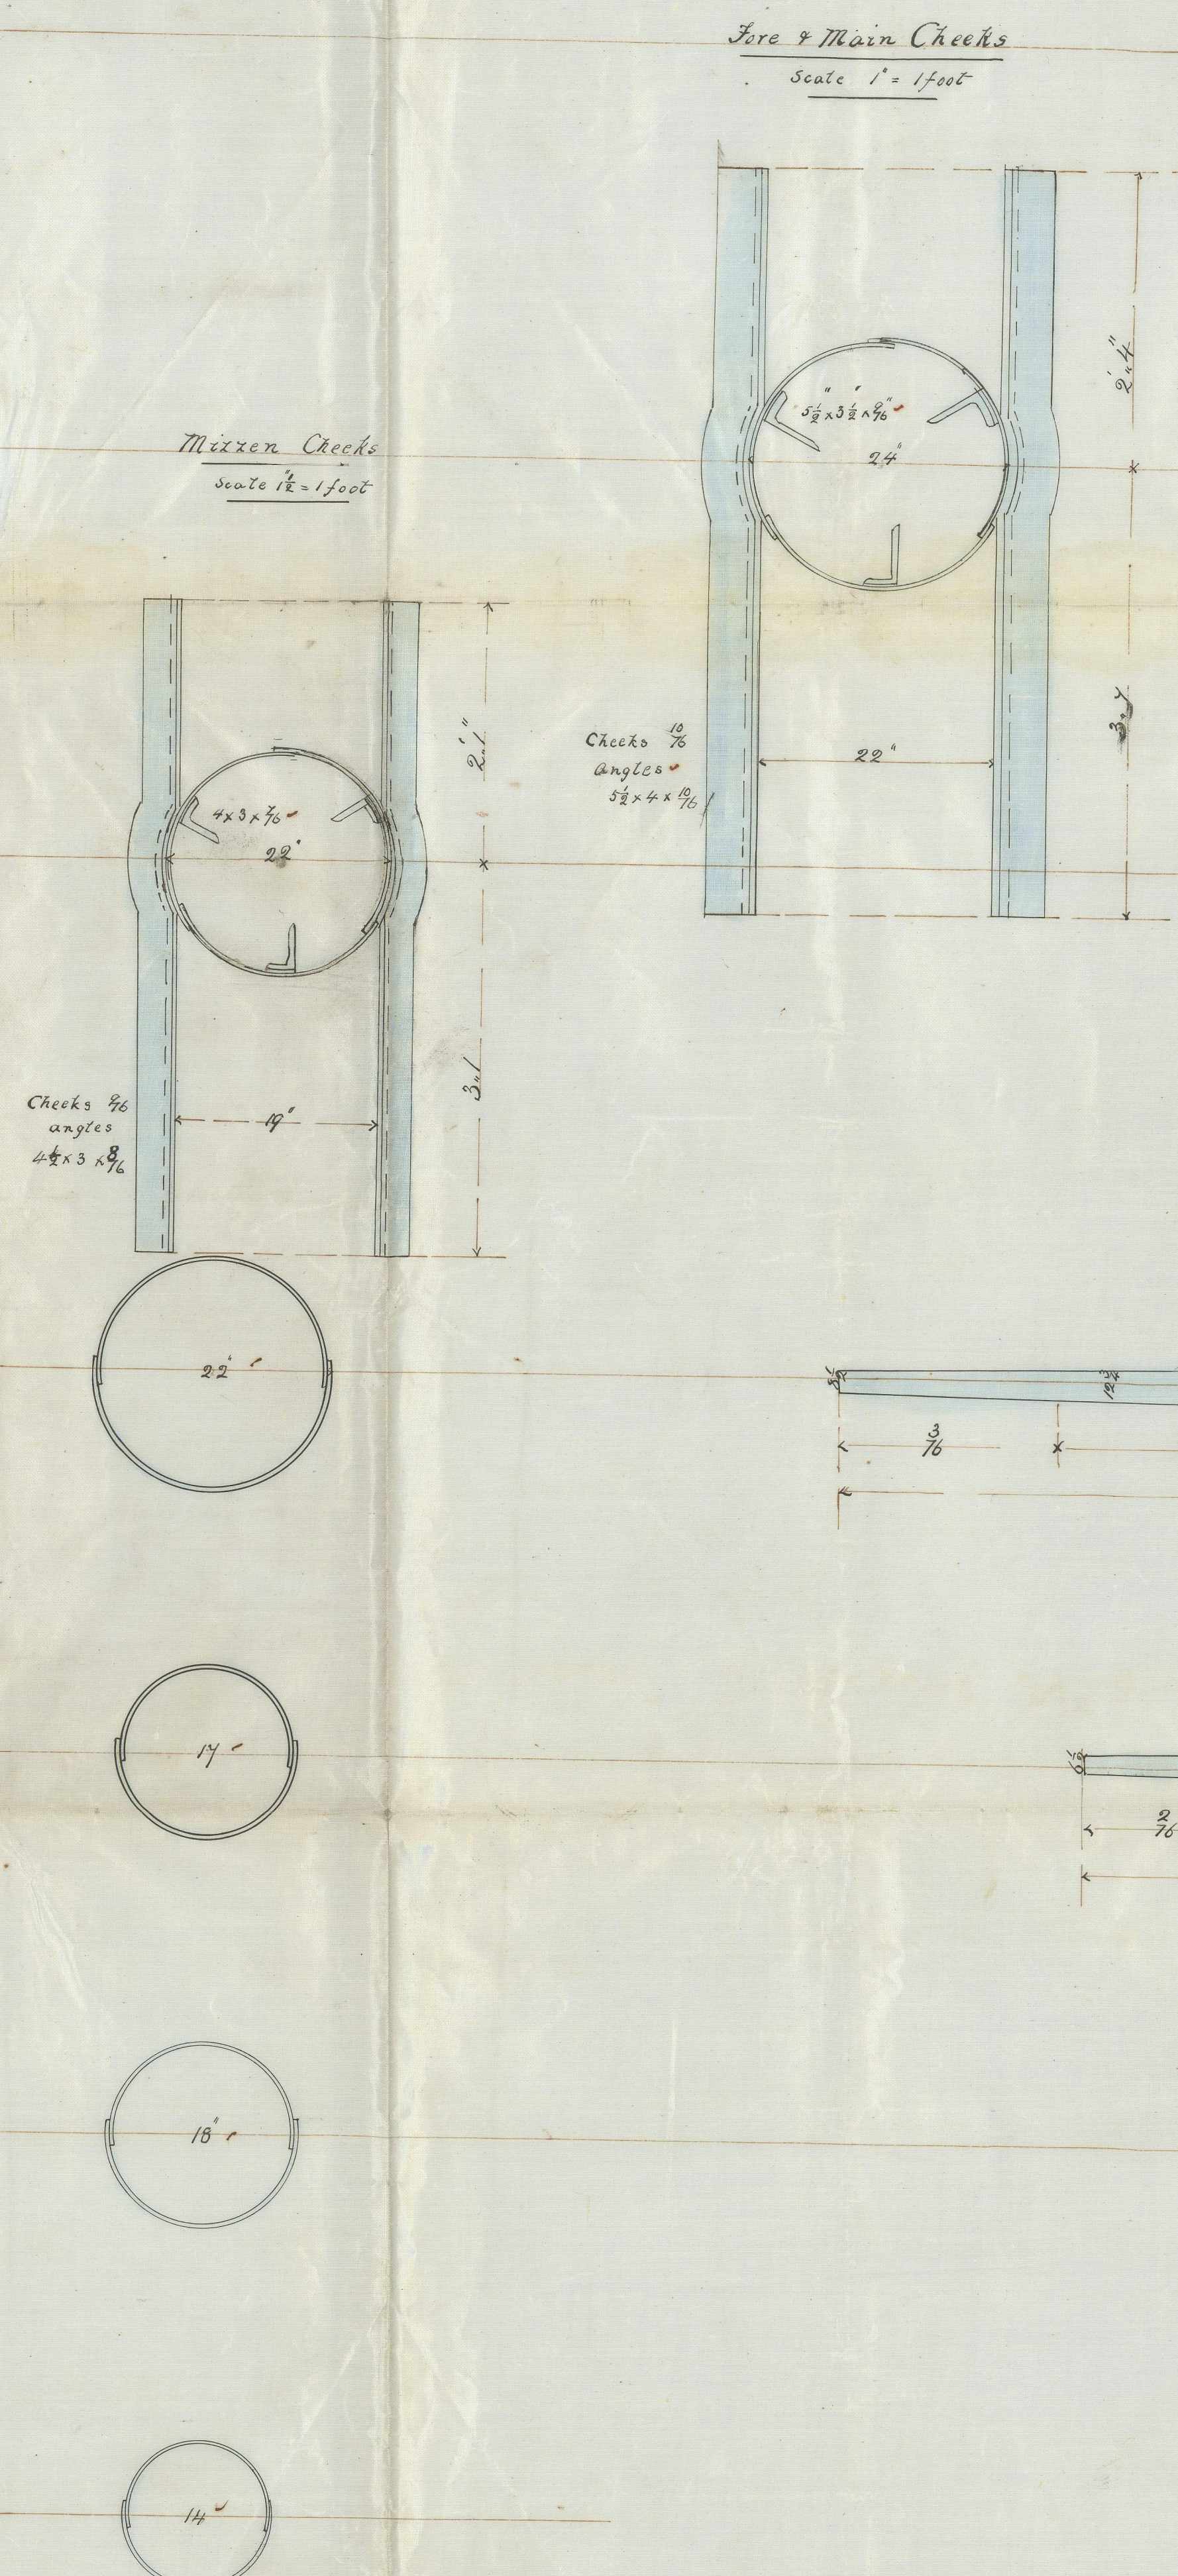


1874/76

Ship "British Enterprise" Report No. 2416.  
No. 2224 Ship  
Iron Masts Yards & Bomsprit  
Scale 1/4" = 1 foot.

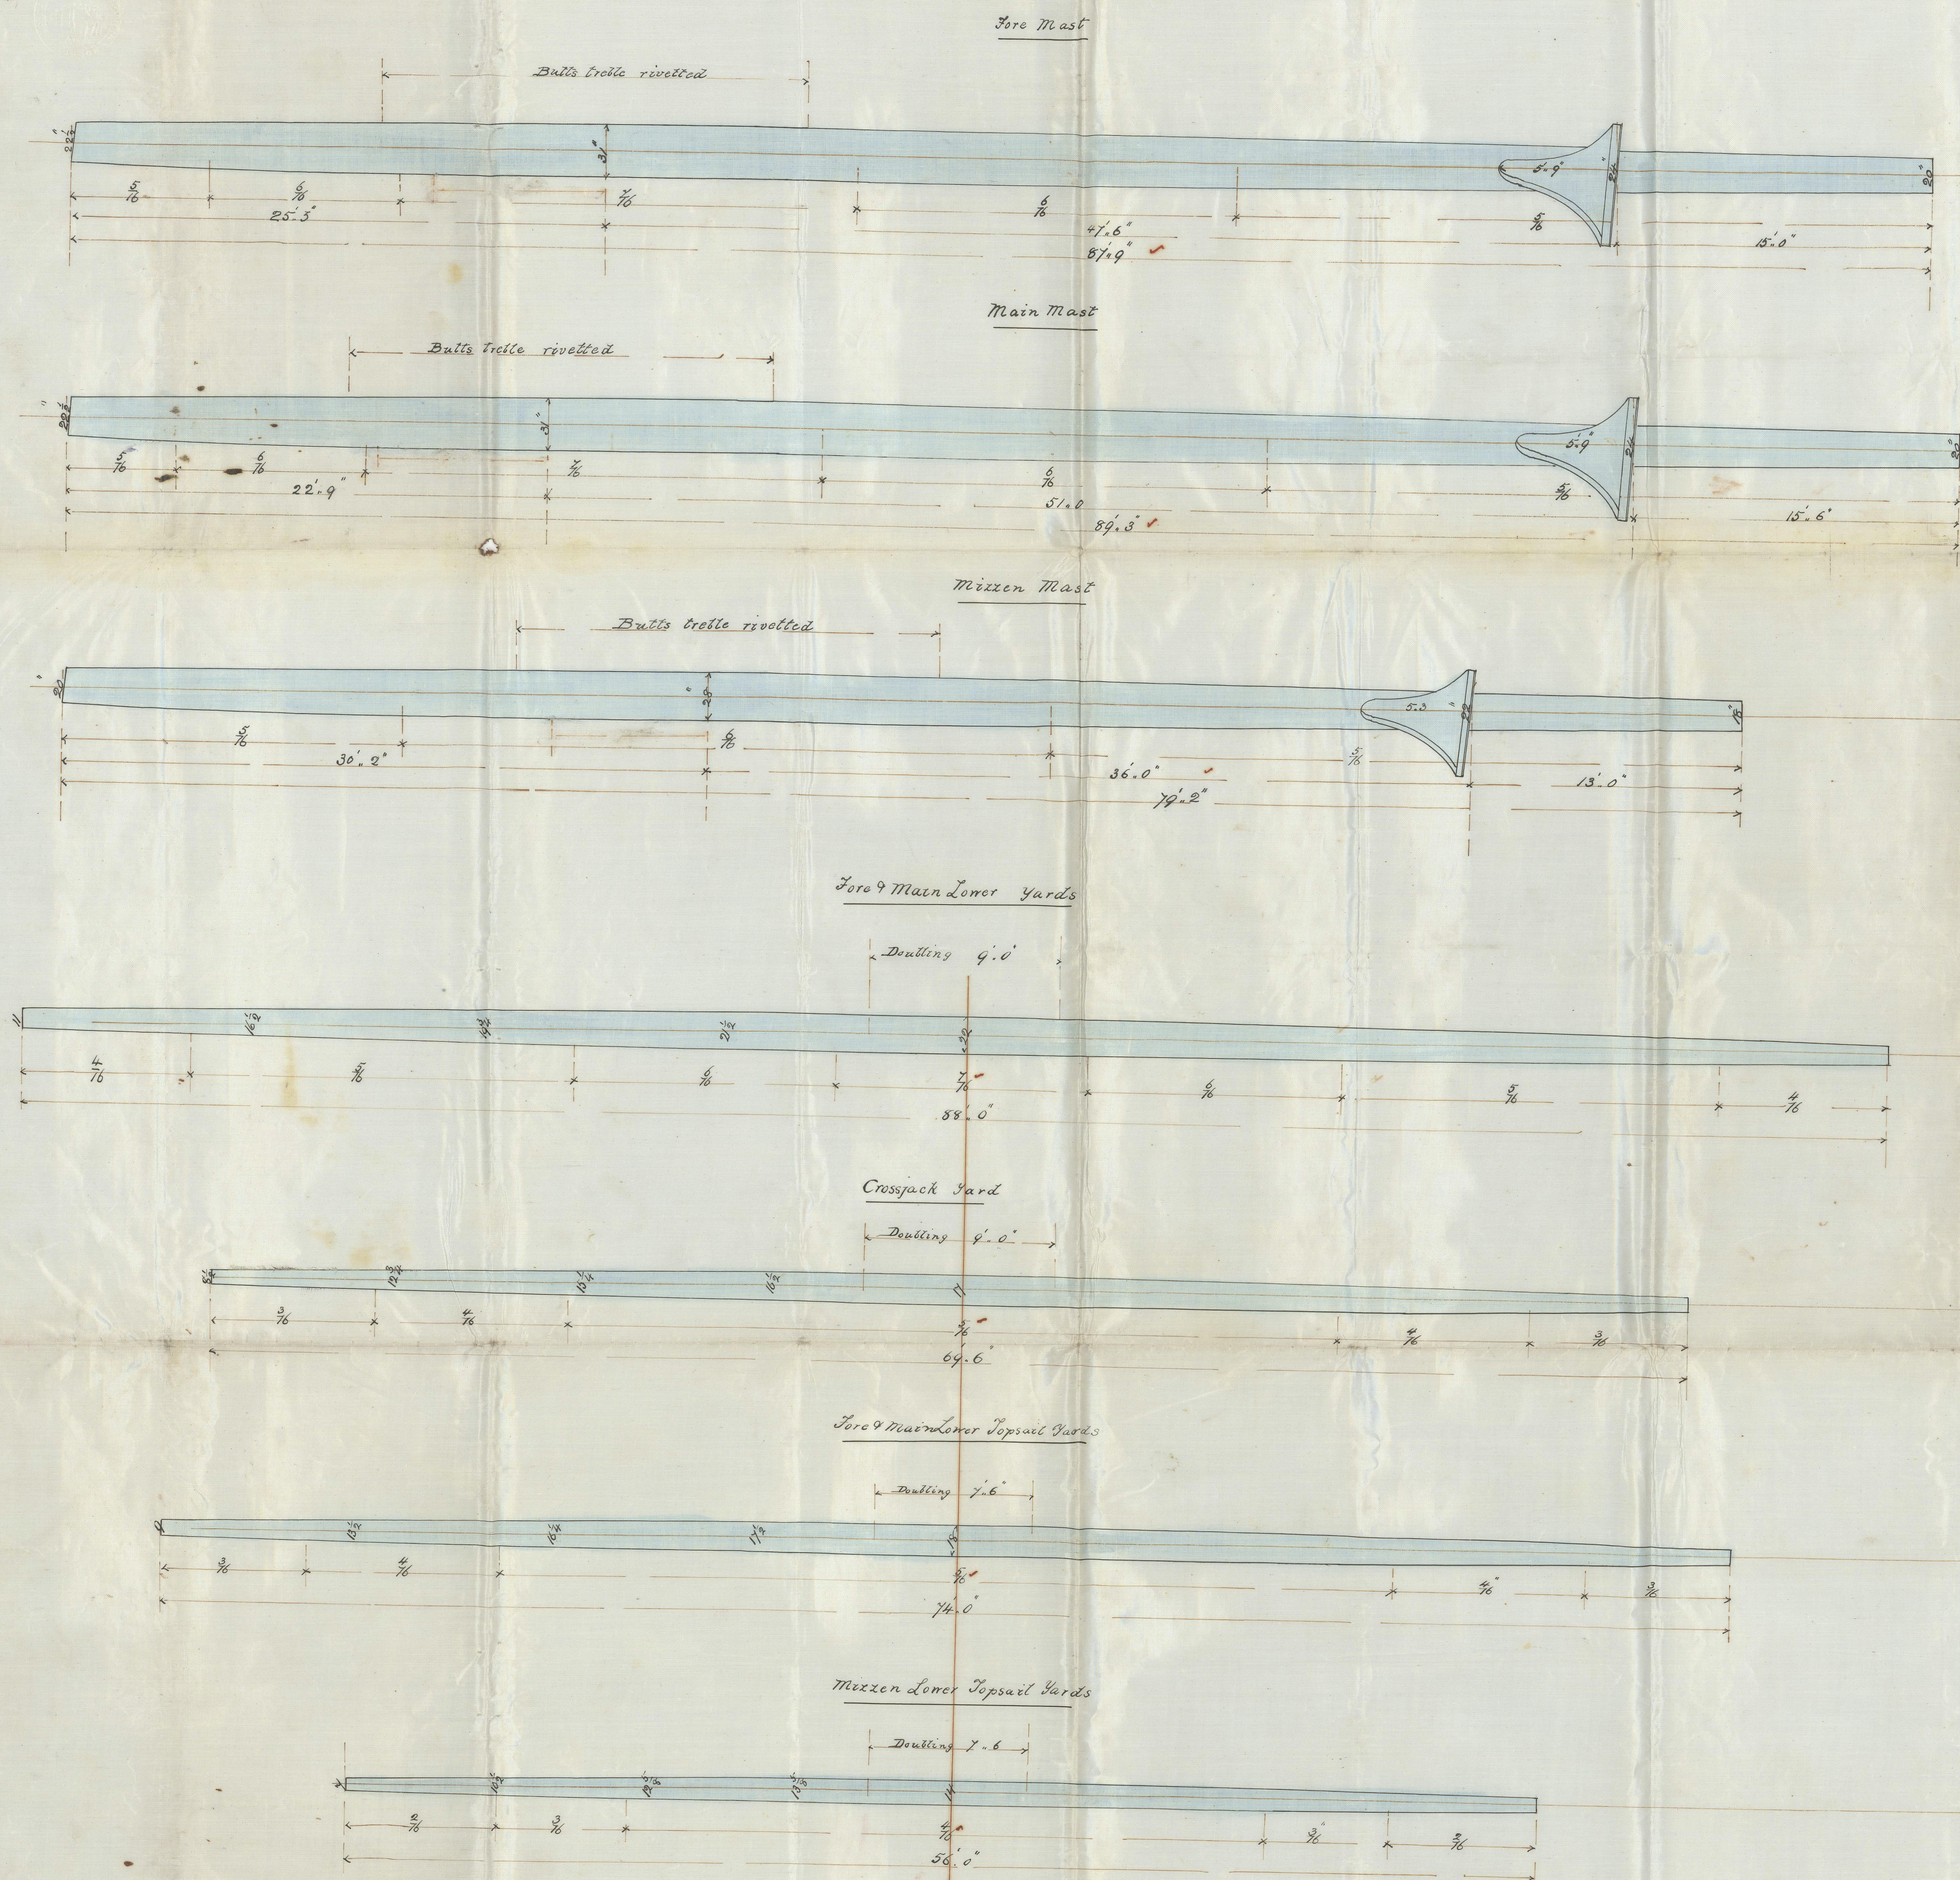

**Remarks.**

**Masts & Bomsprit**  
Plates 5/16" thick. Butts shifted 1/8".  
Seams single rivetted.  
Butts double rivetted, except where marked better.  
Ball straps inside.  
Angles 3 in each running the whole length.  
Butt straps for double rivetting 1/2" x 1/2" x 1/8".  
Rivets 5/16" all flush outside.

**Yards & Topmasts**  
Plates 5/16" thick. Butts shifted 1/8".  
Double where marked.  
Seams single & Butts double rivetted.  
Straps inside. 1/2" wide 1/8" thicker than plates.  
Rivets 5/16" all flush outside.

1874/76  
Richardson, Duck & Co.  
Iron Ship Builders,  
STOCKTON-ON-TEES.  
IRON 1518-0167