


11/4/76

LONGITUDINAL SECTION N° 213

Rec 10/4/76


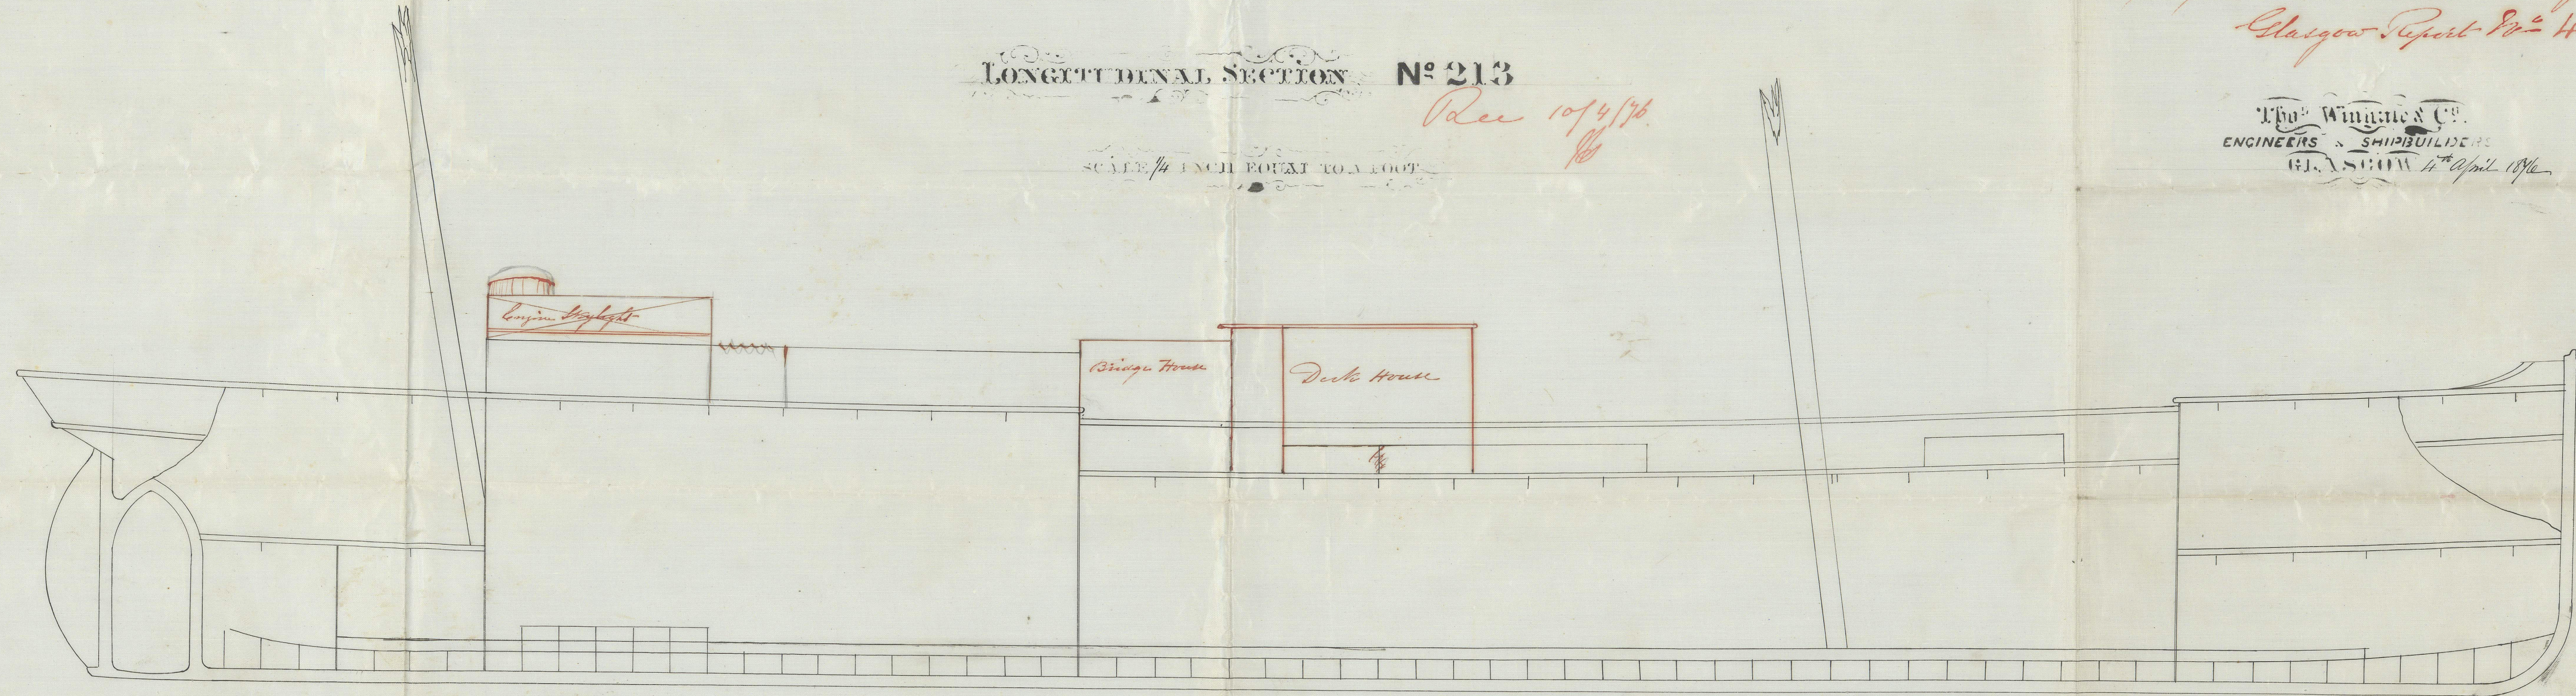

"S.S. Governor Albuquerque"
Glasgow Report No. 4338.

ENGINEERS & SHIPBUILDERS



© 2021
11/4/76
Lloyd's Register
Foundation

IRONS18-0174