


Nº 213

Nº 213

Rec 10/4/96
H

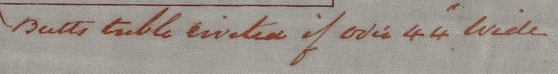

The "Winnipeg" Co.
ENGINEERS & SHIPBUILDERS
GLASGOW. 4th April 1876.