


Glasgow Rep. 3 x 2 1/2 x 5/16
To 4342.



SCALE 1/2 INCH TO A FOOT

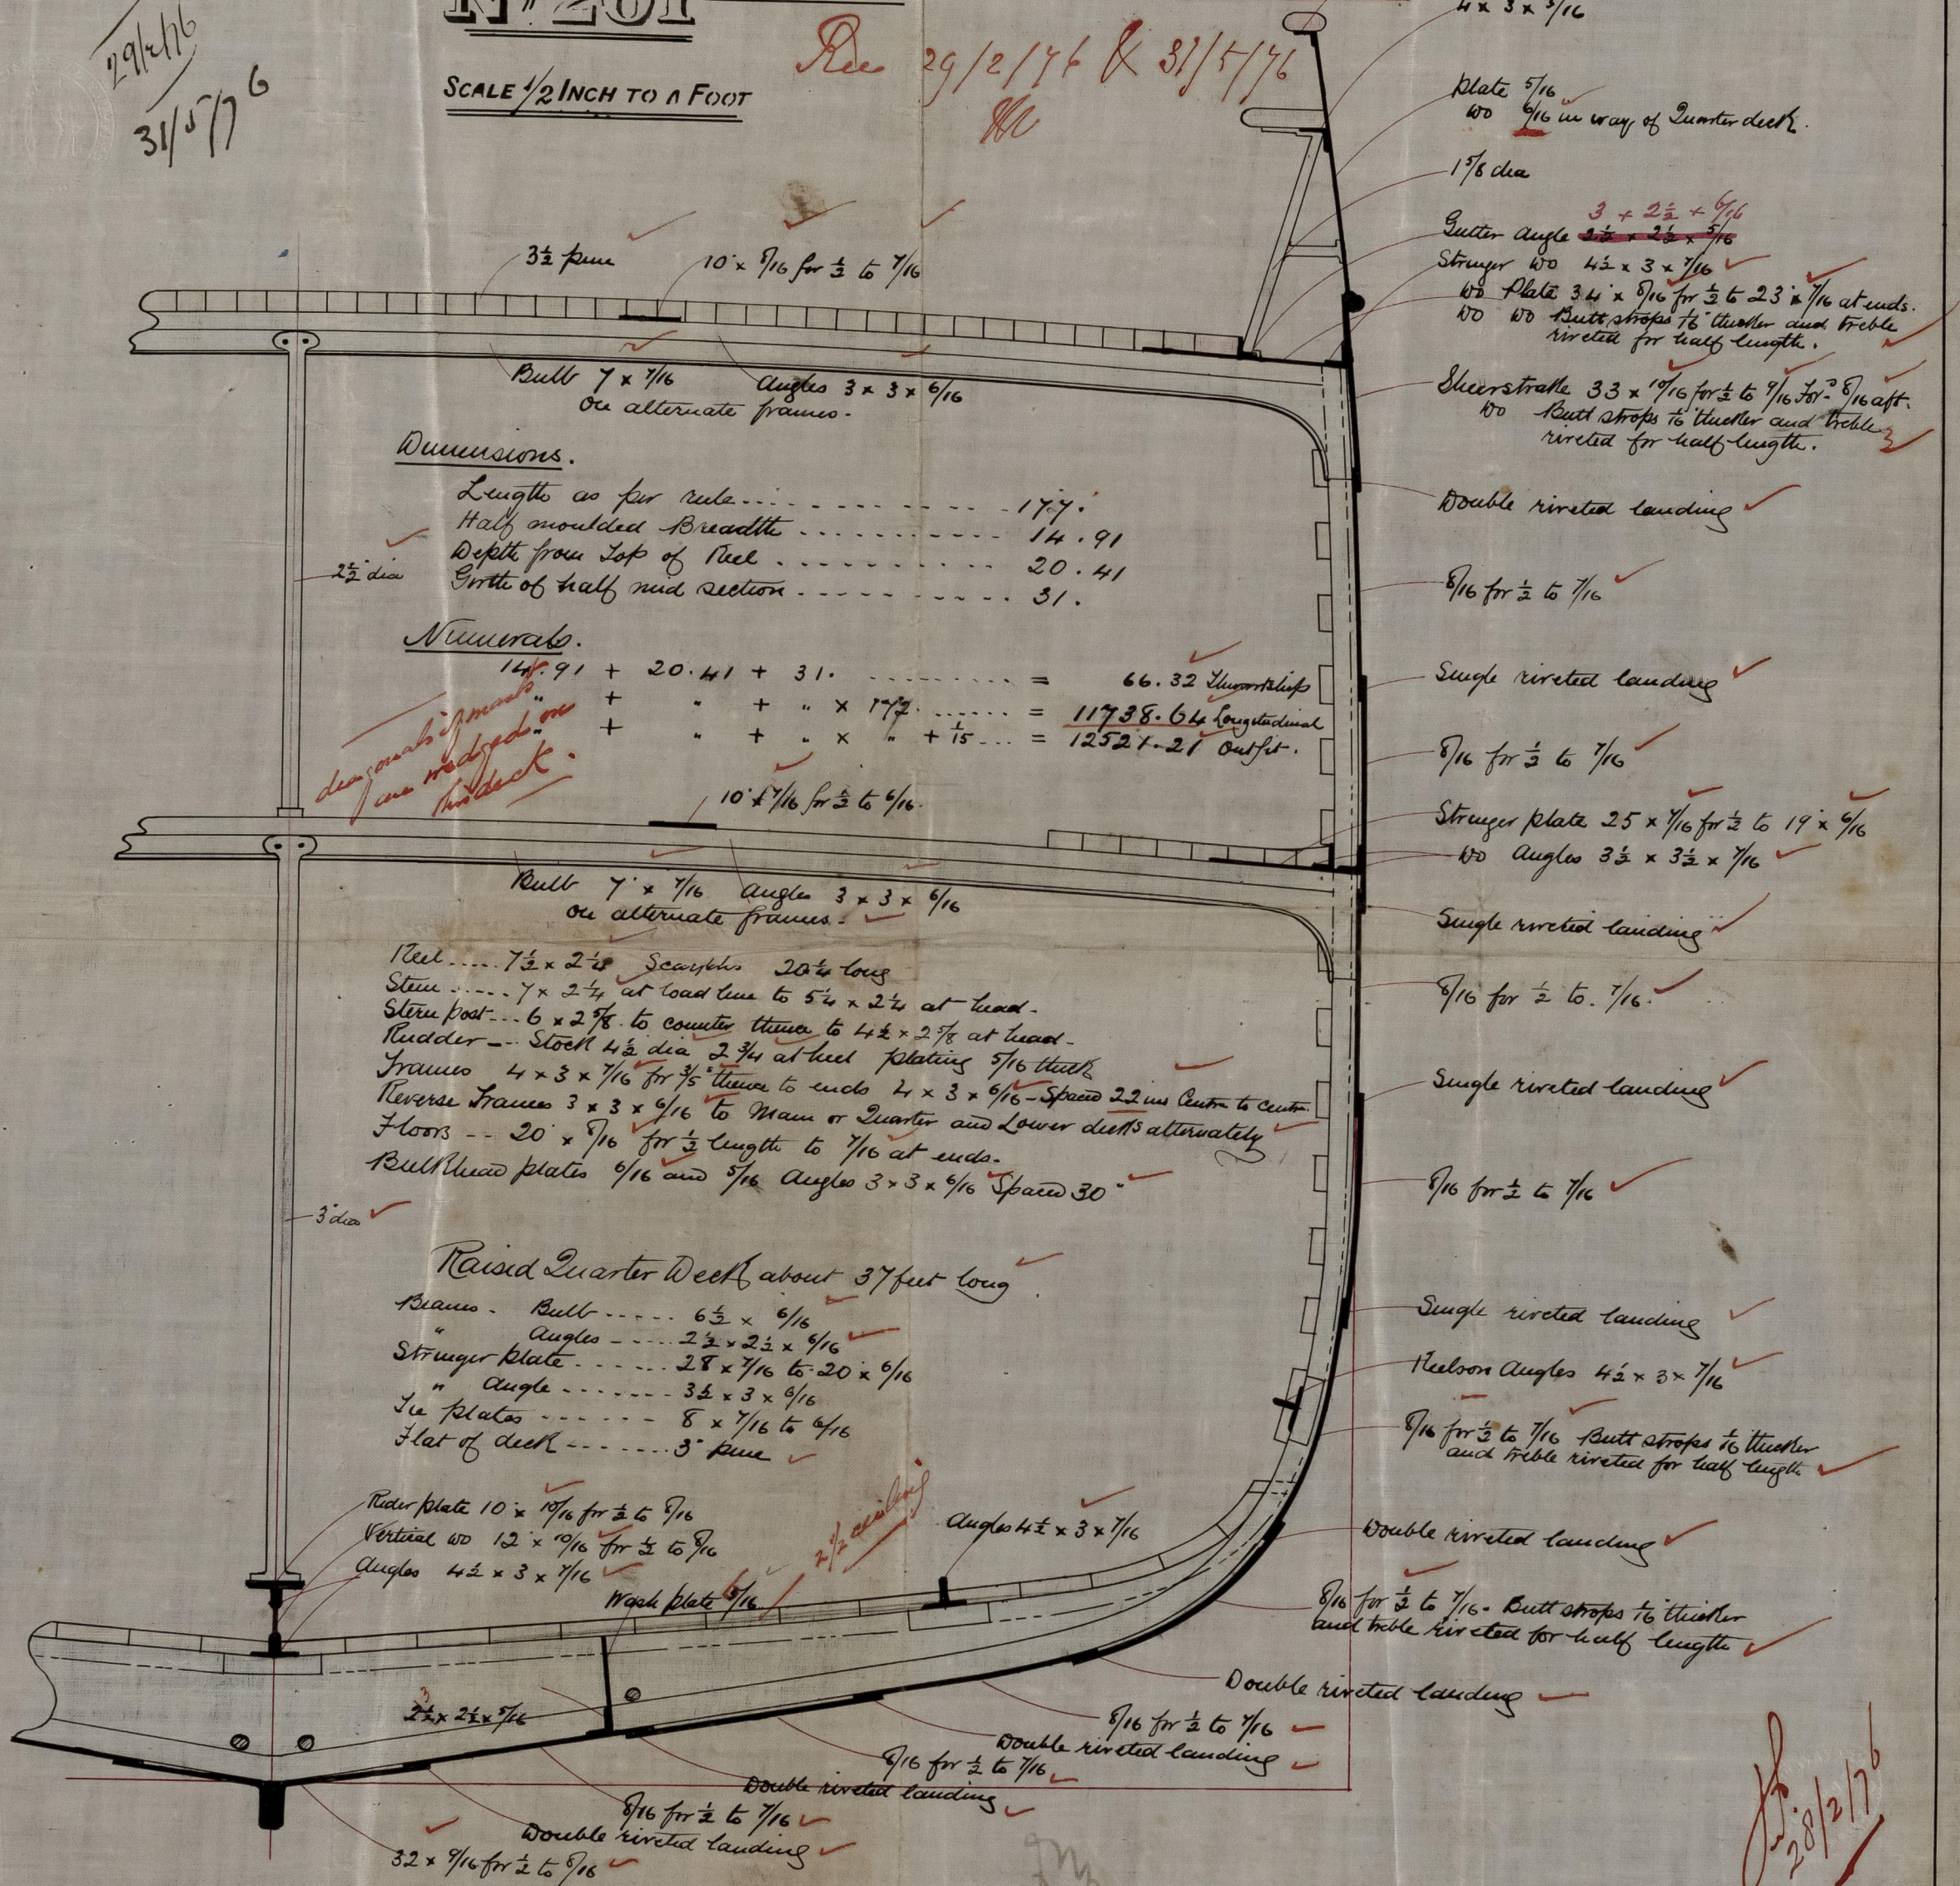

28/2/76

Alex^r Stephen & Sons
SHIPBUILDERS & ENGINEERS

GLASGOW

DRAWING NO 428

IKON 518 - 0179

Iron
17367

or

Liv 38 8/5




1177: 21/10/15

74/5

8/10/15



IRONS18-0179

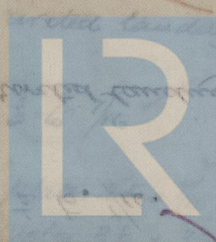

© 2021

Lloyd's Register
Foundation