


Ship "Scrapis"
of London
Greenock Report
No 4110

Midship Section of new Ship No 13

Scale 1/2" = one foot Per 15/5/76 & 28/9/76
To Class 100A at Lloyds

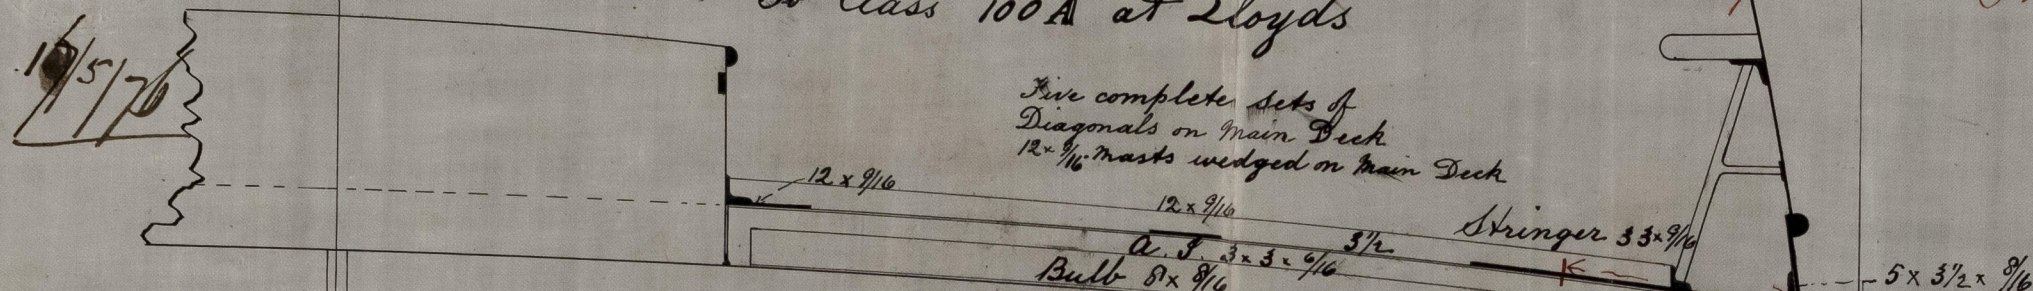

1/2 Beam 17 x 8
Depth 22 x 7
Girth 32 x 8
72 11
153 12 x 6 Chain No same

Frame Space 23 inches
Frames 4 1/2 x 3 x 9/16 - 3 1/2 x 4 1/2 x 3 x 7/16
Reverse 3 x 3 x 7/16 To Main and Lower Deck alternately
Bulkheads 9/16
Do angle Iron 3 x 3 x 7/16
Ceiling 2 1/2
Rudder 5 1/4
Pinches 3

Butt Straps of sheer-shake
and Main Deck Stringers
to be 1/16 thicker and
treble riveted for 1/2 Length

Under 10 Depths

Main Deck Stringer Plate 33 x 9/16 ends 24 3/4 x 9/16
Tween Deck Stringer Plate 30 x 8/16 ends 24 x 7/16



Three Strakes
Treble Riveted Butts
1/2 Length 1/16 thicker

James E. Scott
Ship Builder
Greenock

15/5/76

Lloyd's Register
Foundation

IRON 519 - 0004