


28/9/76

Ship No 13 Ship "Scrapis" of London
 Rec 28/9/76 Greenock Report
 No 4110

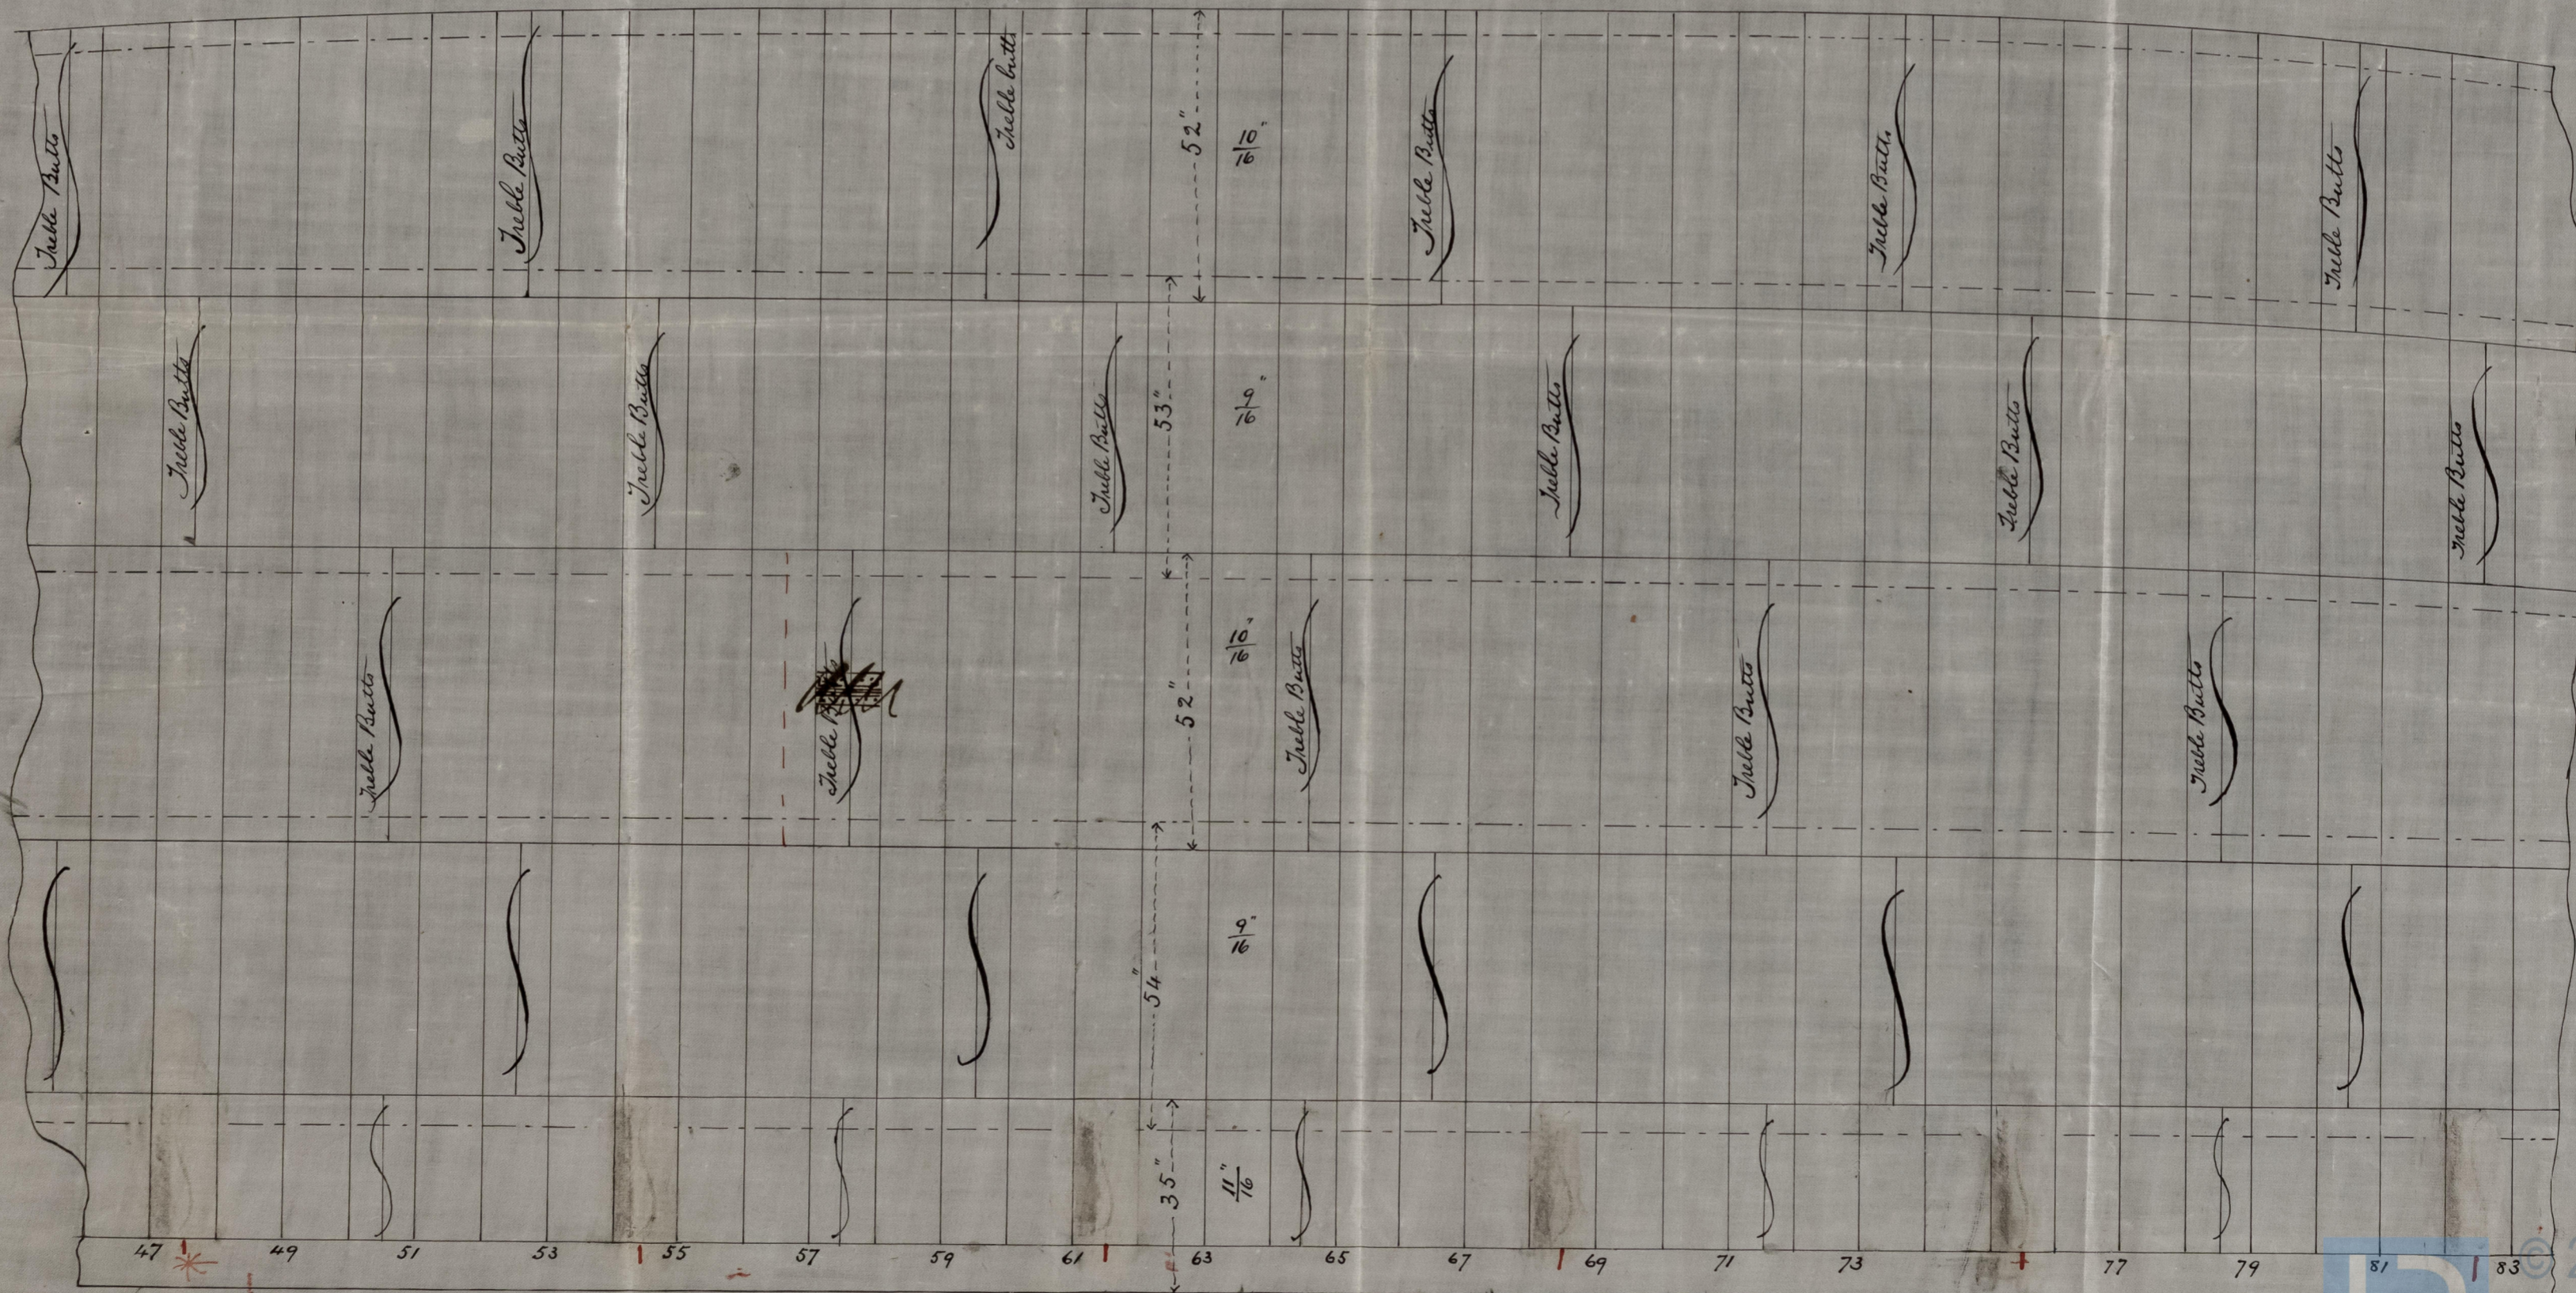

* Red Ind. Butts of Gunboards on the 1st

James E. Scott.
 Shipbuilder
 Greenock

2021
 Lloyd's Register
 Foundation
 28/9/76

IRON 519-0005