


Scantling $79.95 \times 221 = 17.668$

PA

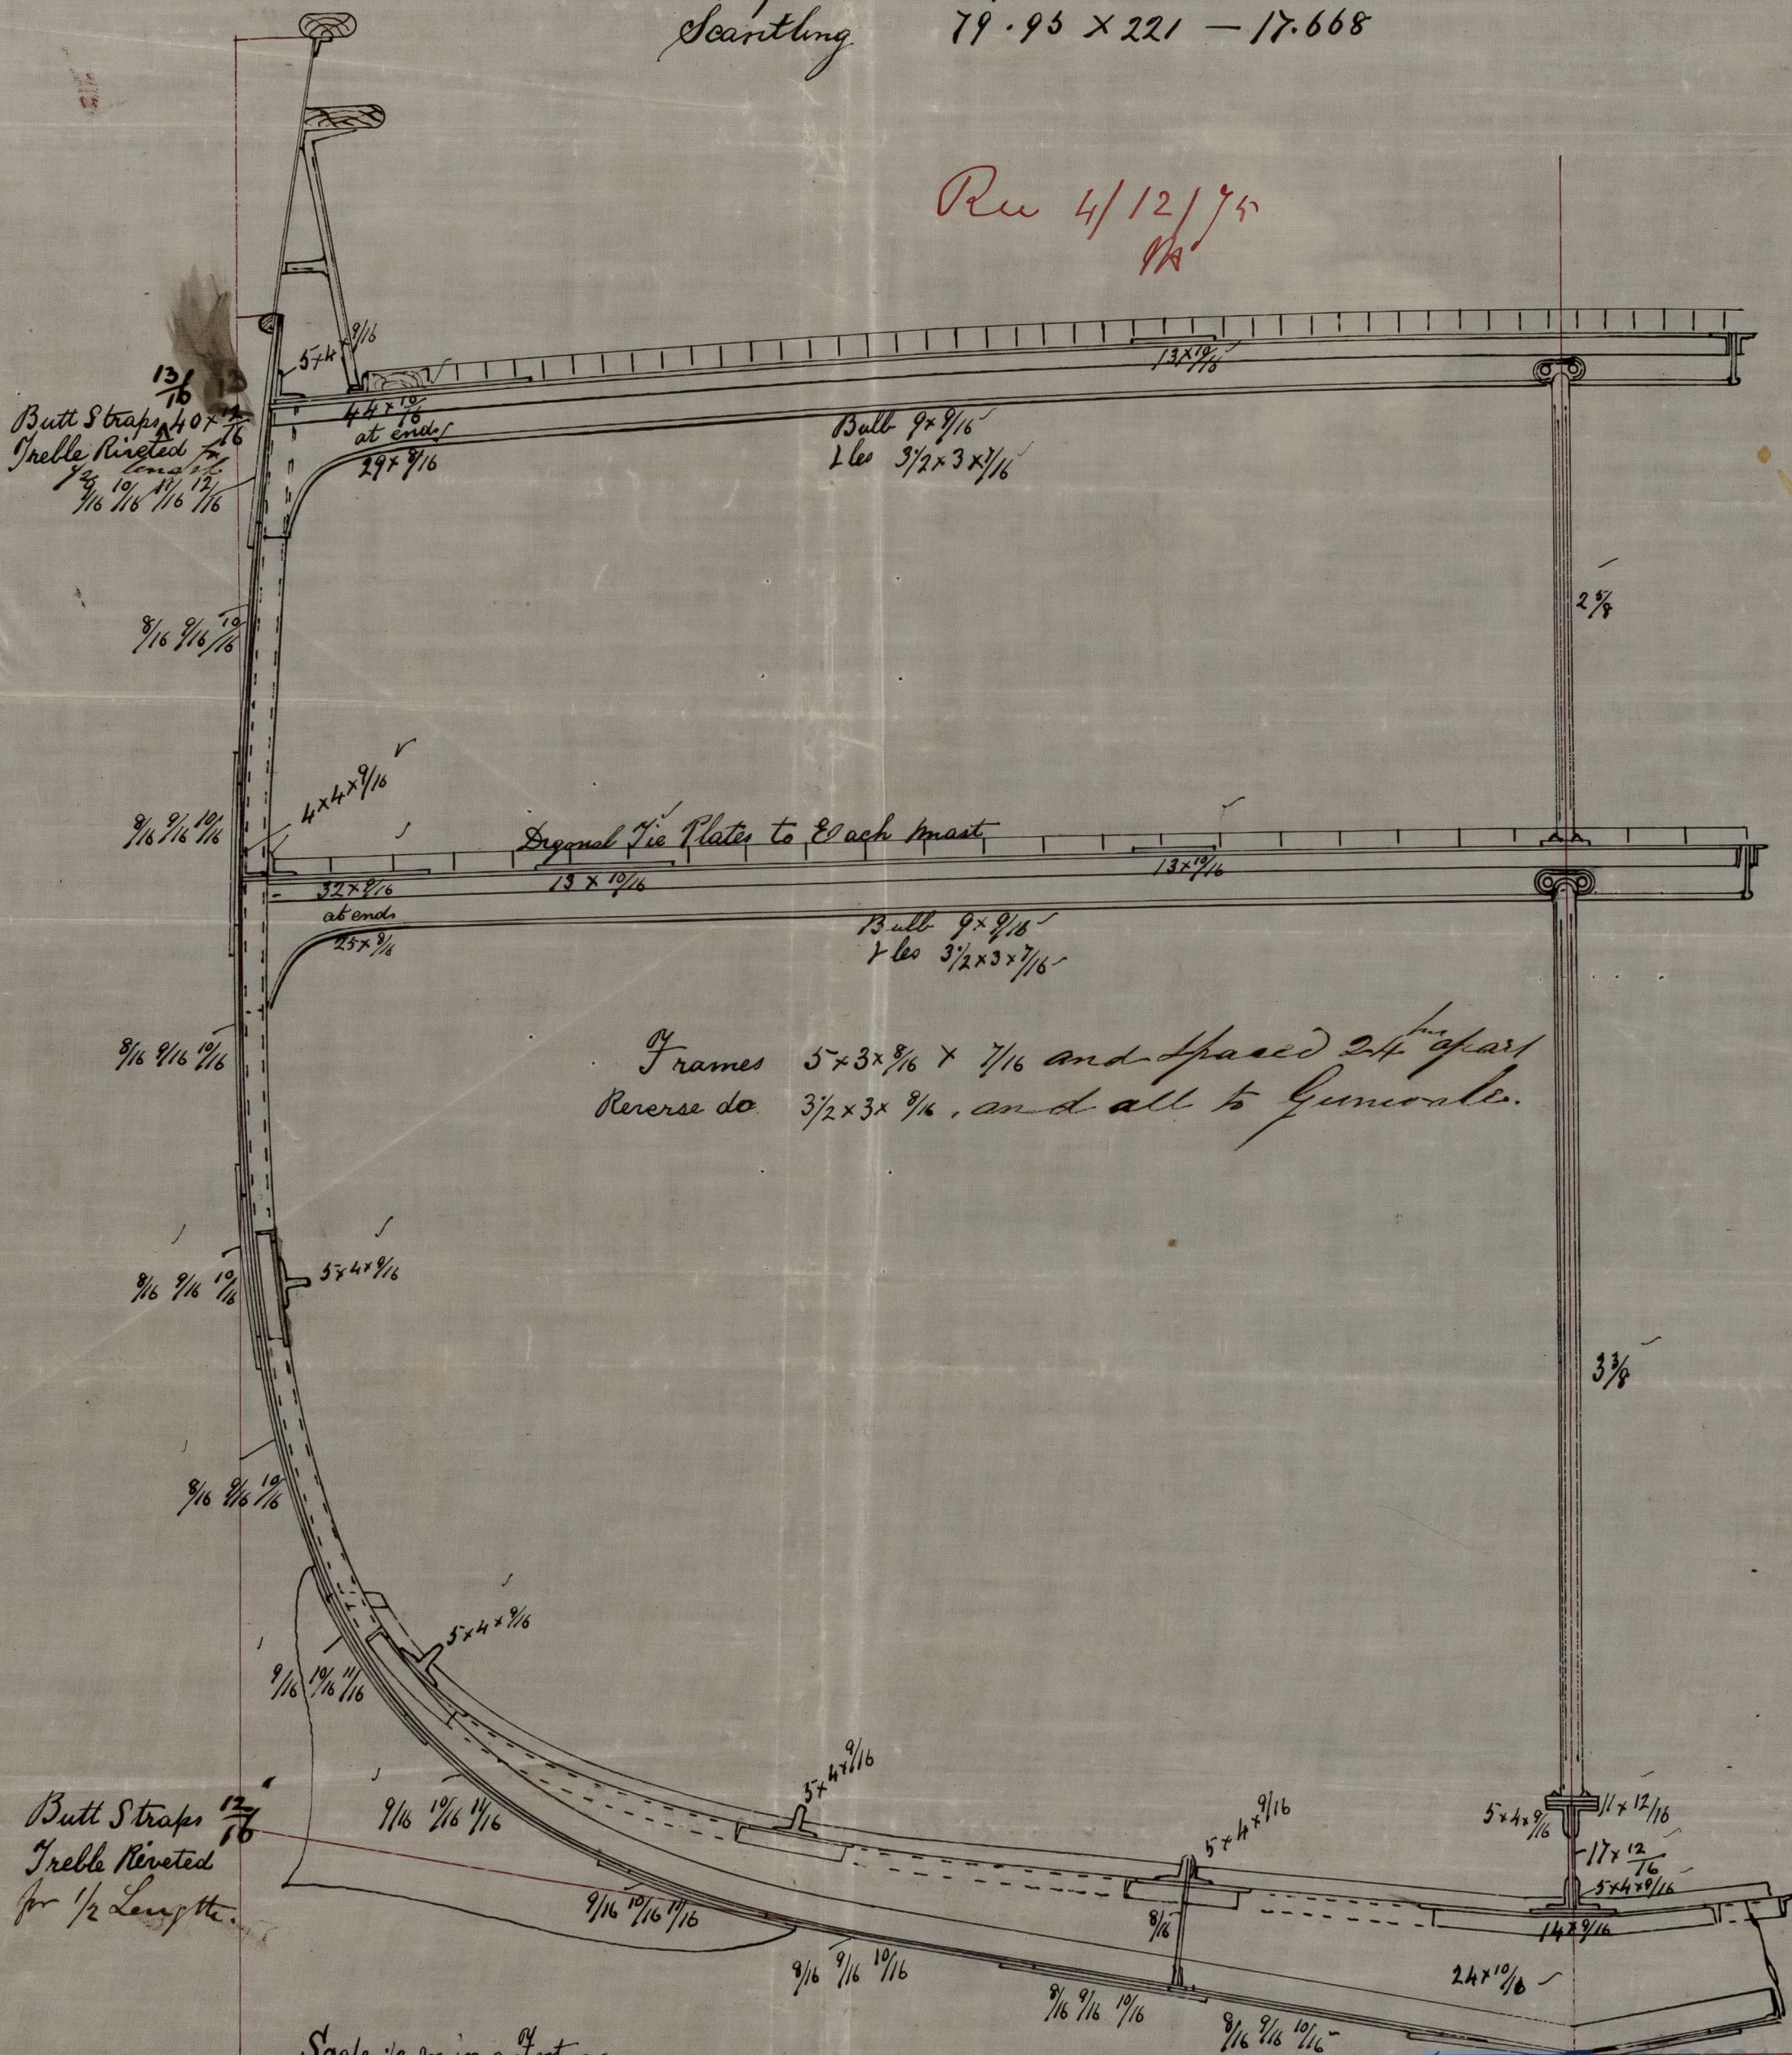

Frames $5 \times 3 \times \frac{8}{16} \times \frac{7}{16}$ and spaced 24^{hrs} apart
Reverse do. $3\frac{1}{2} \times 3 \times \frac{8}{16}$, and all to General.

Scale $\frac{1}{2}$ in in a Foot

J. H. J.
6/12/75

IRON 519 - 0007

36x¹¹/₁₆ ¹⁰/₁₆ ¹/₁₆
 9x2¹/₂
 Floors Double Butte Straps 8.
 Treble Knitted 16
 Lloyd's Register
 Foundation