


"Yulchau" - Dundee Ref: No 4023.
Shd 14-11-76

Rev 1/4/76
M

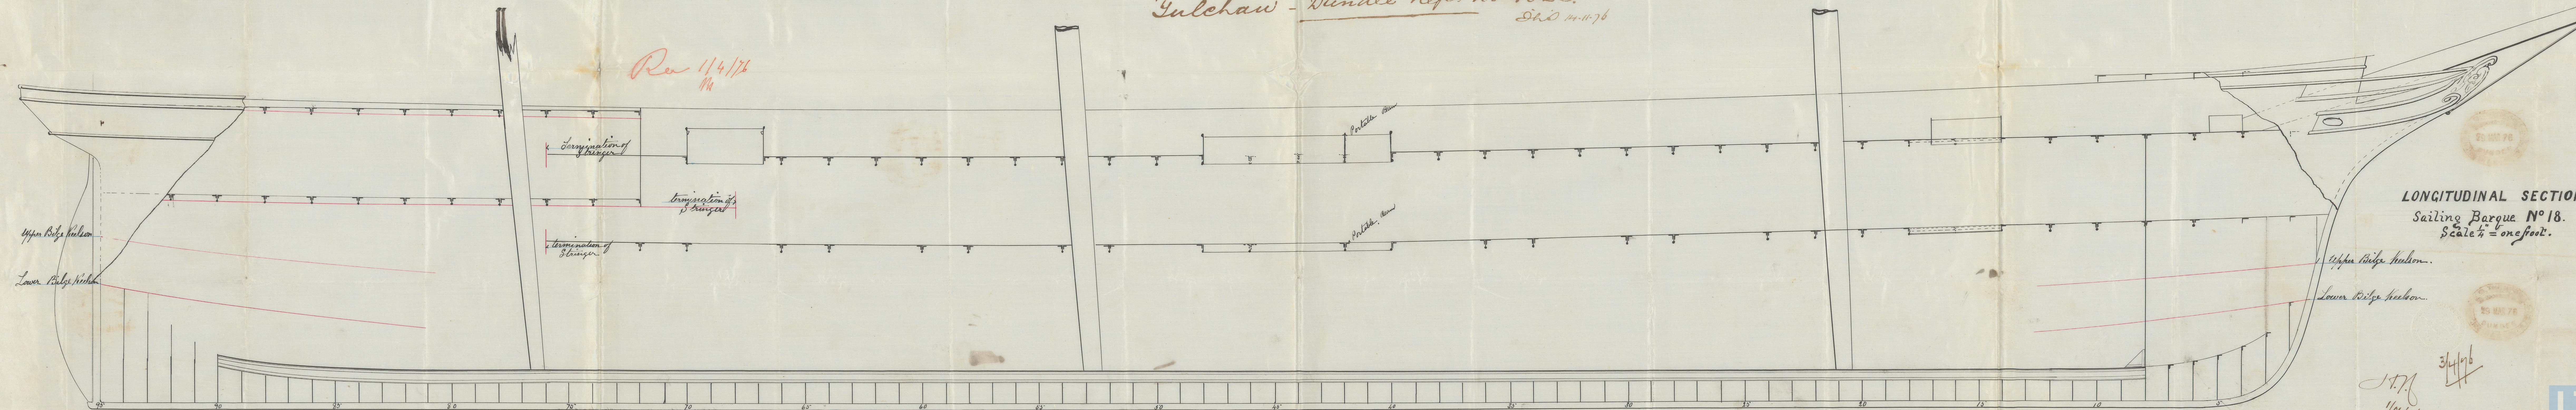

LONGITUDINAL SECTION.

Sailing Barque N° 18.
Scale 1/4" = one foot.

Upper Bilge Keelson.
Lower Bilge Keelson.

J.T.N.
1/4/76
3/4/76