

*S.S. "Armstrong" Report No. 11540
Amended Profile*

Y. Y. No. 221


November 2nd

1876

Scale 1/8" = 1 foot

*permanent plate
steel beams 8"*

*Hatchway
plated over 1 1/2 ft
in length*

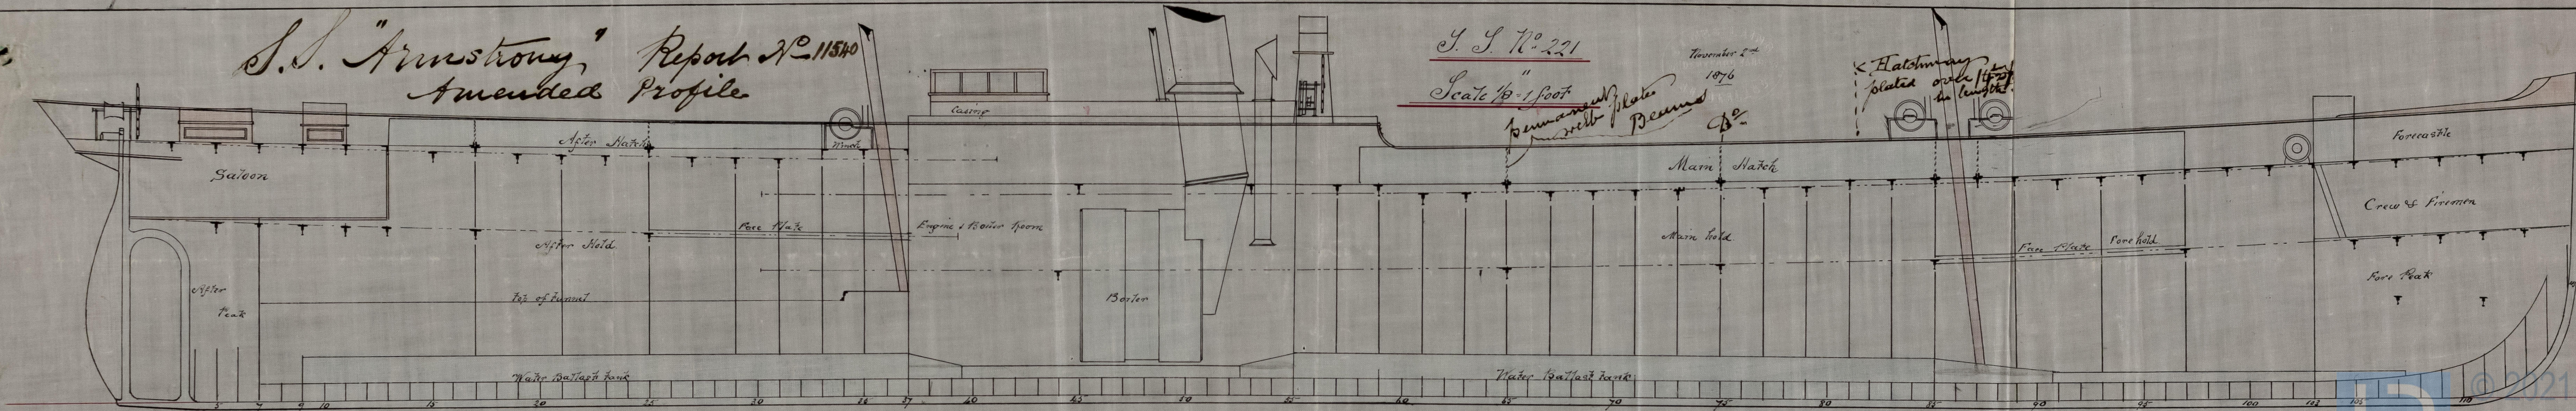

© 2021

Lloyd's Register
Foundation

IRON 519-0022