

S.S. Armstrong Report No. 11540
Hatchways are fitted
as shown on Amended Profile


Screw Steamer No 221

Scale 1/8 of an inch equals 1 foot.

June 27
1876

Rev 4/7/76

6/7/76

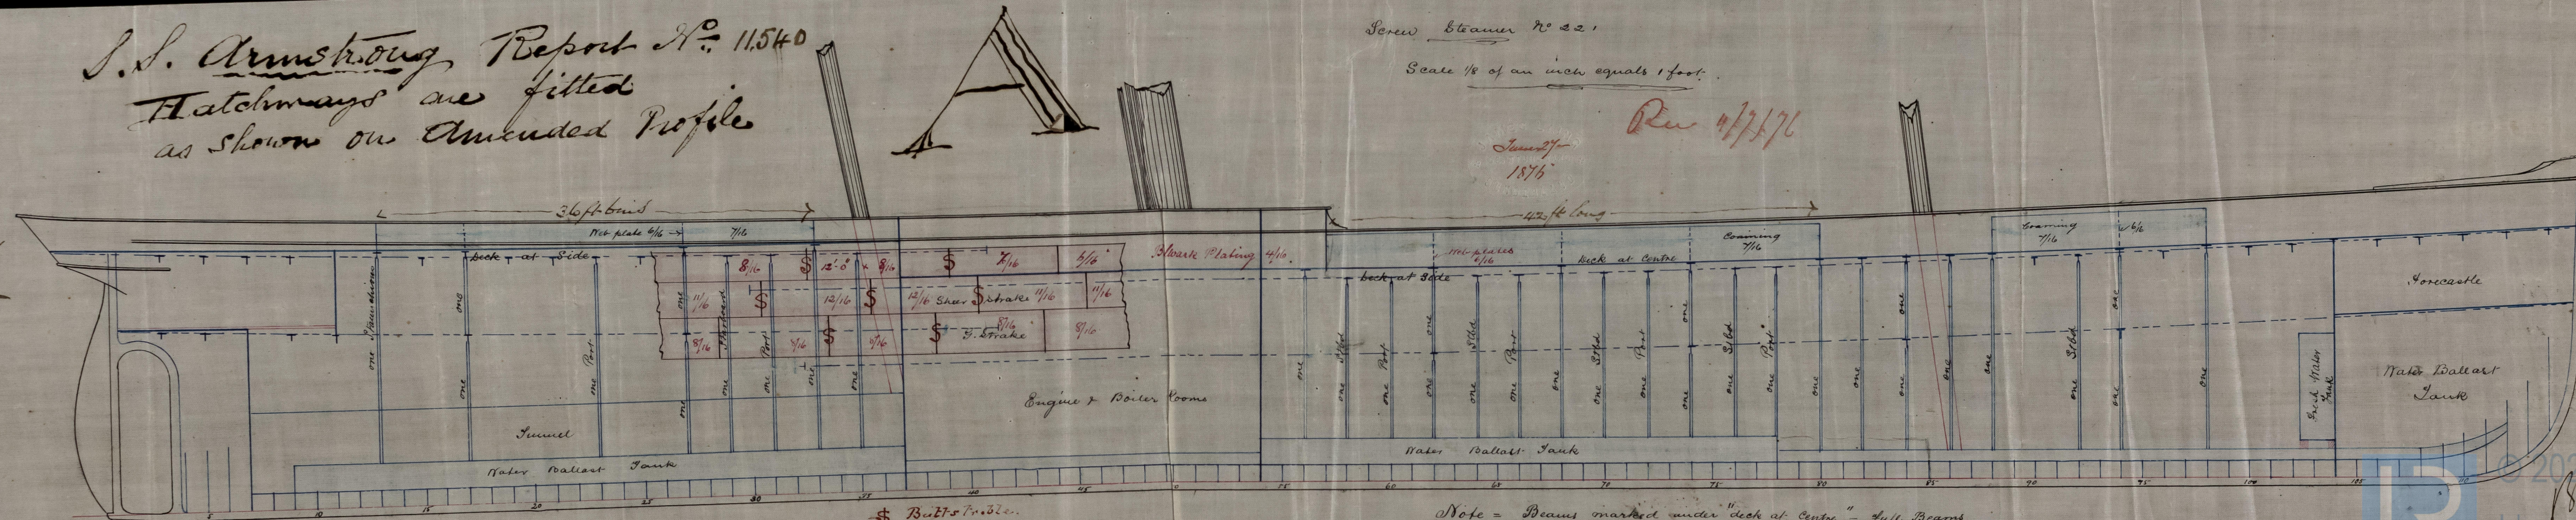

\$ Butts Trouble.

Note = Beams marked under "Deck at Centre" = Full Beams
do do Side = 1/2 "

IRON 519-0024