

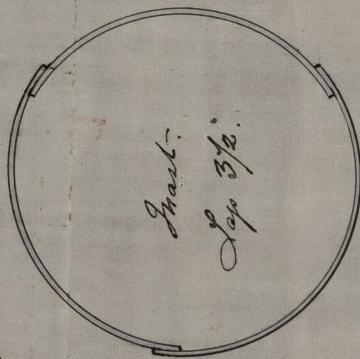
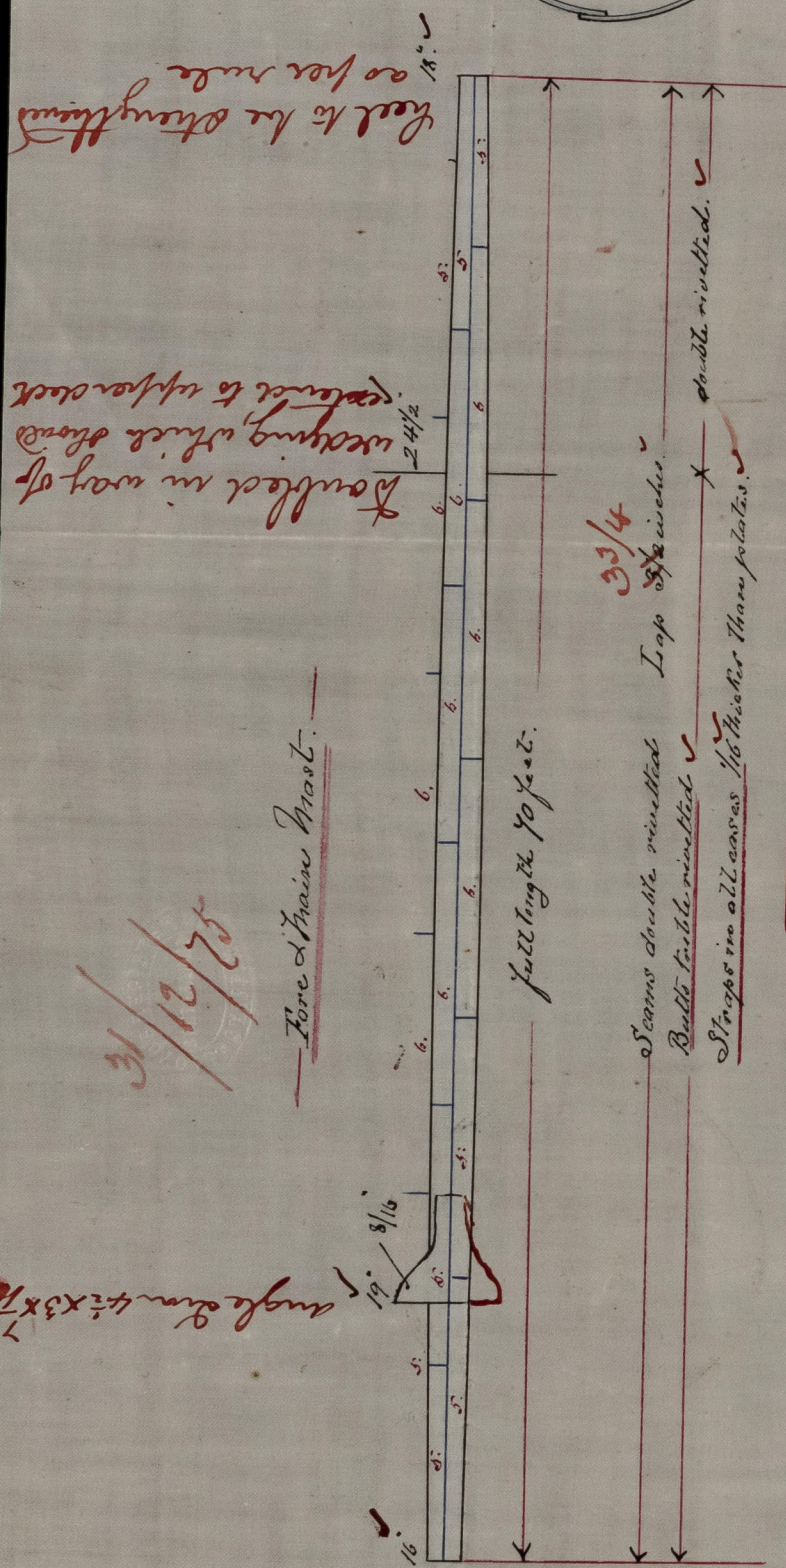




BK "Beech Hollow" Report No. 11536

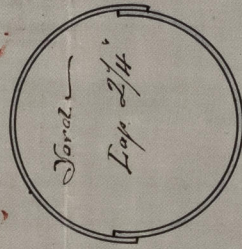

Fore & Main Lower Yard.

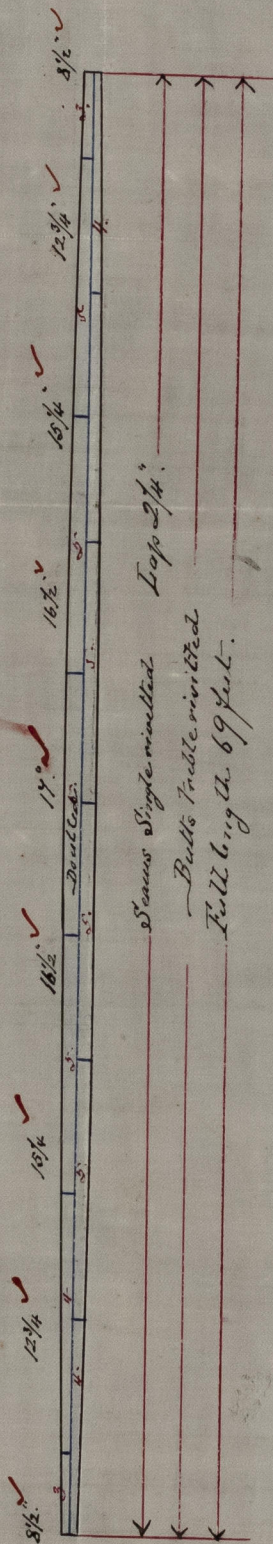

Bowsprit.

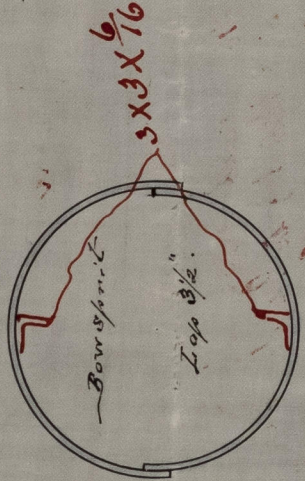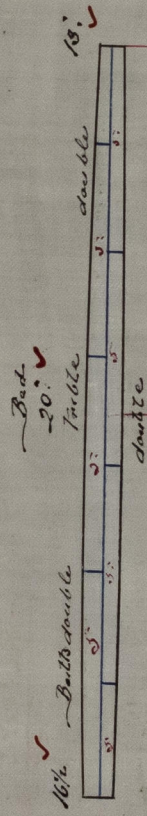

Sailing Ship.
No. 214.

Butts wraps $\frac{6}{16}$ and those outside Butts to be treble rivetted; to be doubled at the wedging and to have 2 angles the whole length.

IRON 519-0036



© 2021
Lloyd's Register
Foundation