


S. S. "Cymru"  
Greenock Report  
No. 4118.

Dec 26/15/76

20/4/76  
27/5/76

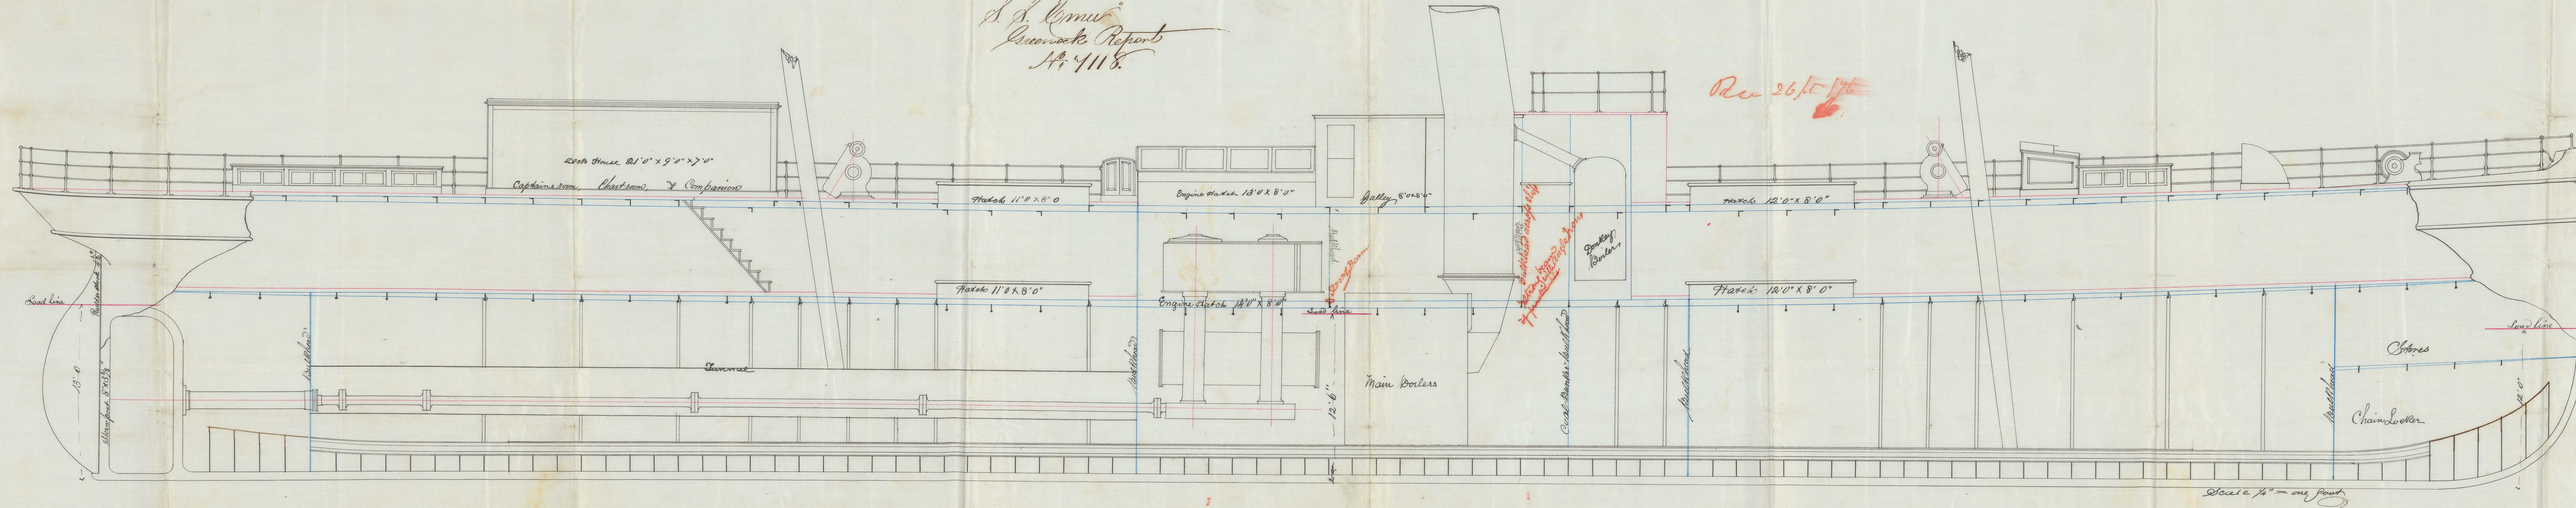

No 139 S. S.  
Length on dock = 178.75  
Breadth moulded = 24.83  
Depth of hold = 11.50  
Blackwood & Gordon  
Port Glasgow  
13/4/76

Wm  
20/4/76  
27/5/76

120519-0039