

20/4/76

27/5/76  
Long


Length on deck = 178.75

Breadth moulded = 24' 83

Depth of Hold = 11' 50

Class ☒ 100A1 awning decked.

Rec 26/5/46

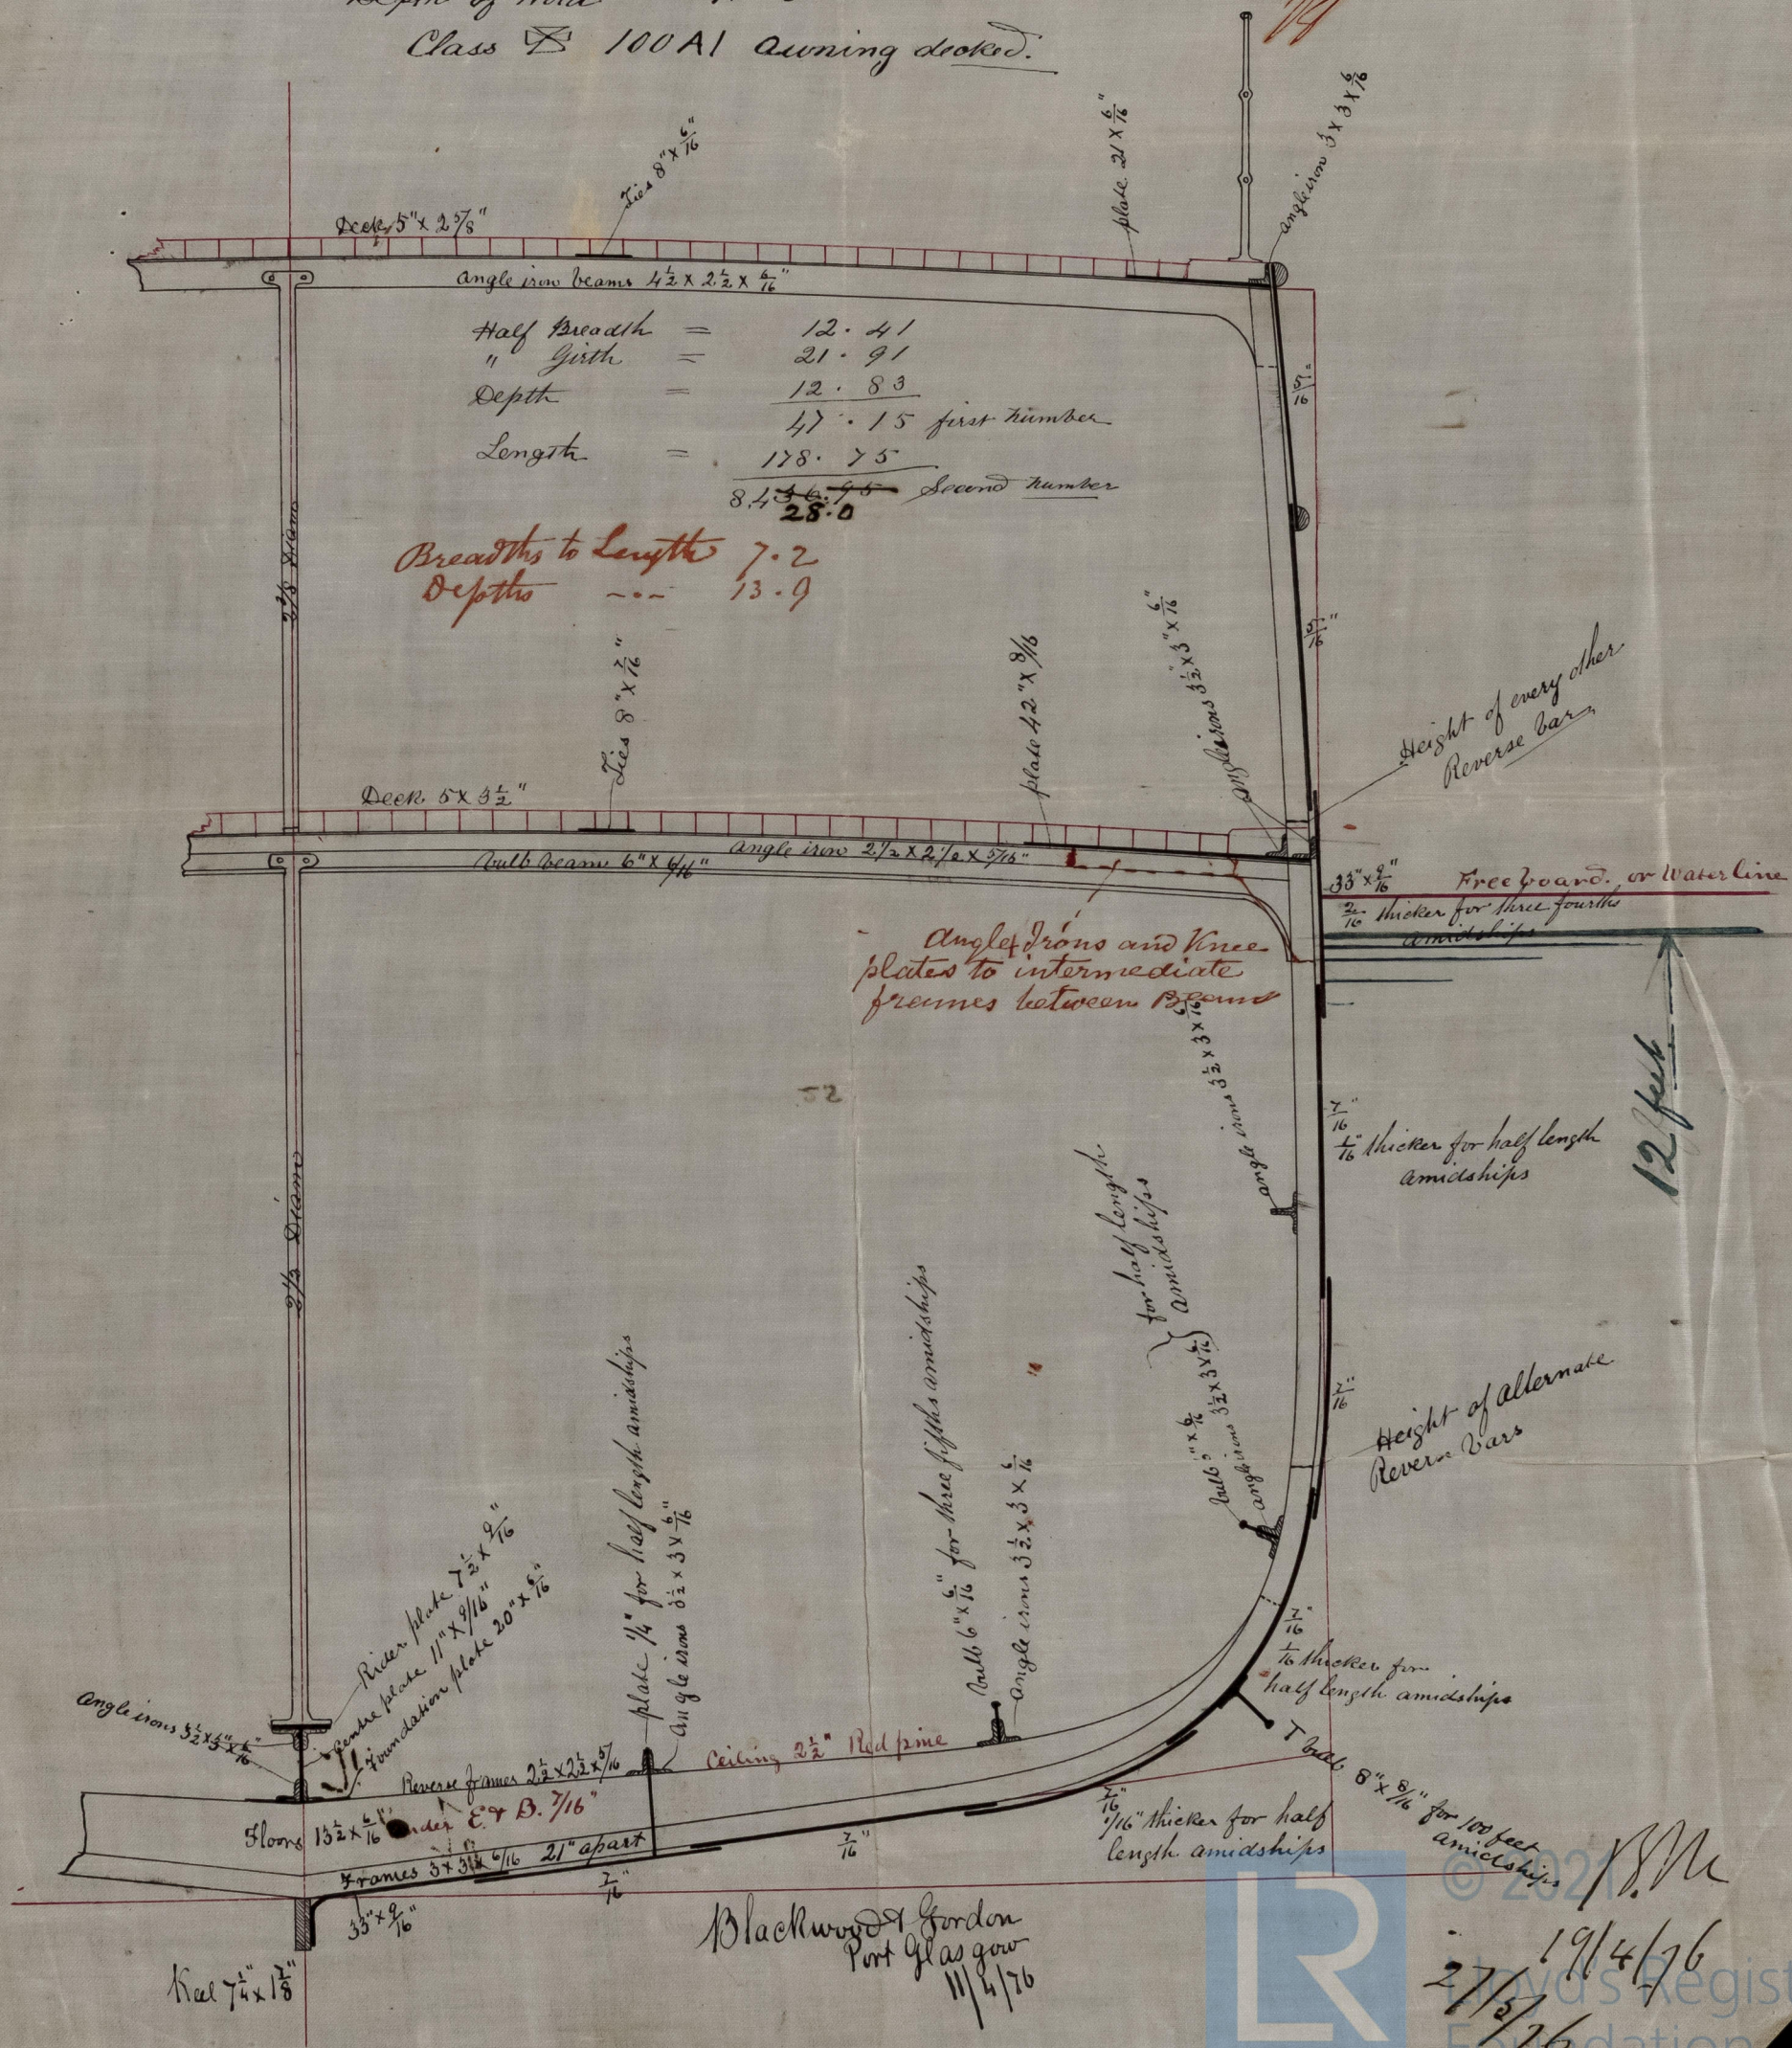

Blackwood & Gordon  
Port Glas grow  
11/6/76

For 100 feet  
amidships

19/4/76

27/2/76

1RONS19-0040