


LONGITUDINAL SECTION

of  
No 290

Rev 11/5/76  
*[Signature]*

8/6/76  
*[Signature]*

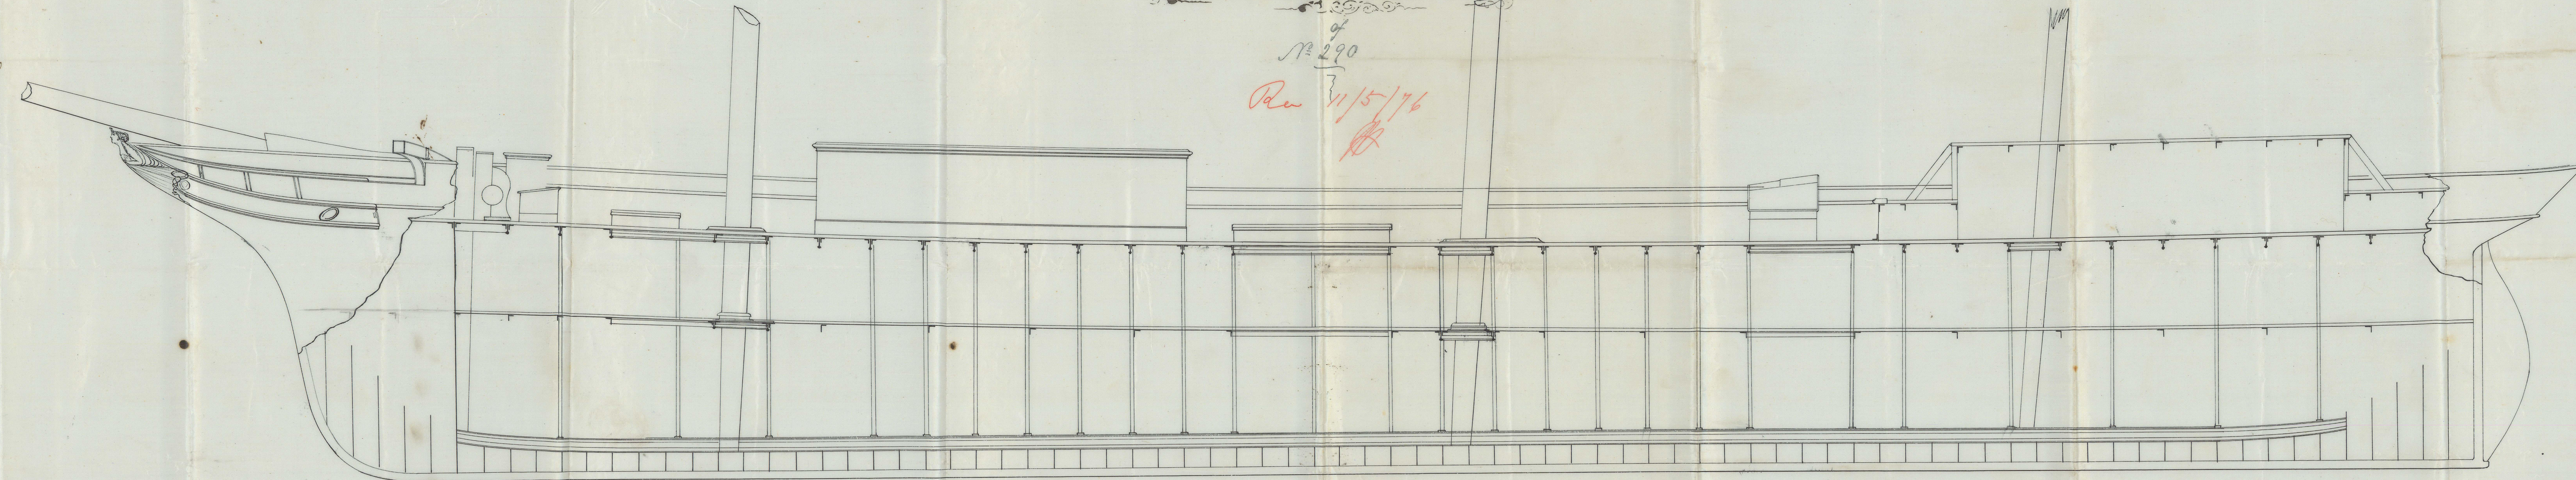

SCALE 1/4" INCH TO A FOOT

Alexander Hall & Co  
Shipbuilders  
ABERDEEN

1200519-0057