

Glasgow Report
No. 4360


RADNORSHIRE

S.S. No 194

SCALE 1/2 INCH TO THE FOOT

CLASS 100 A 3 DECK

See 20/3/76 & 6/6/76

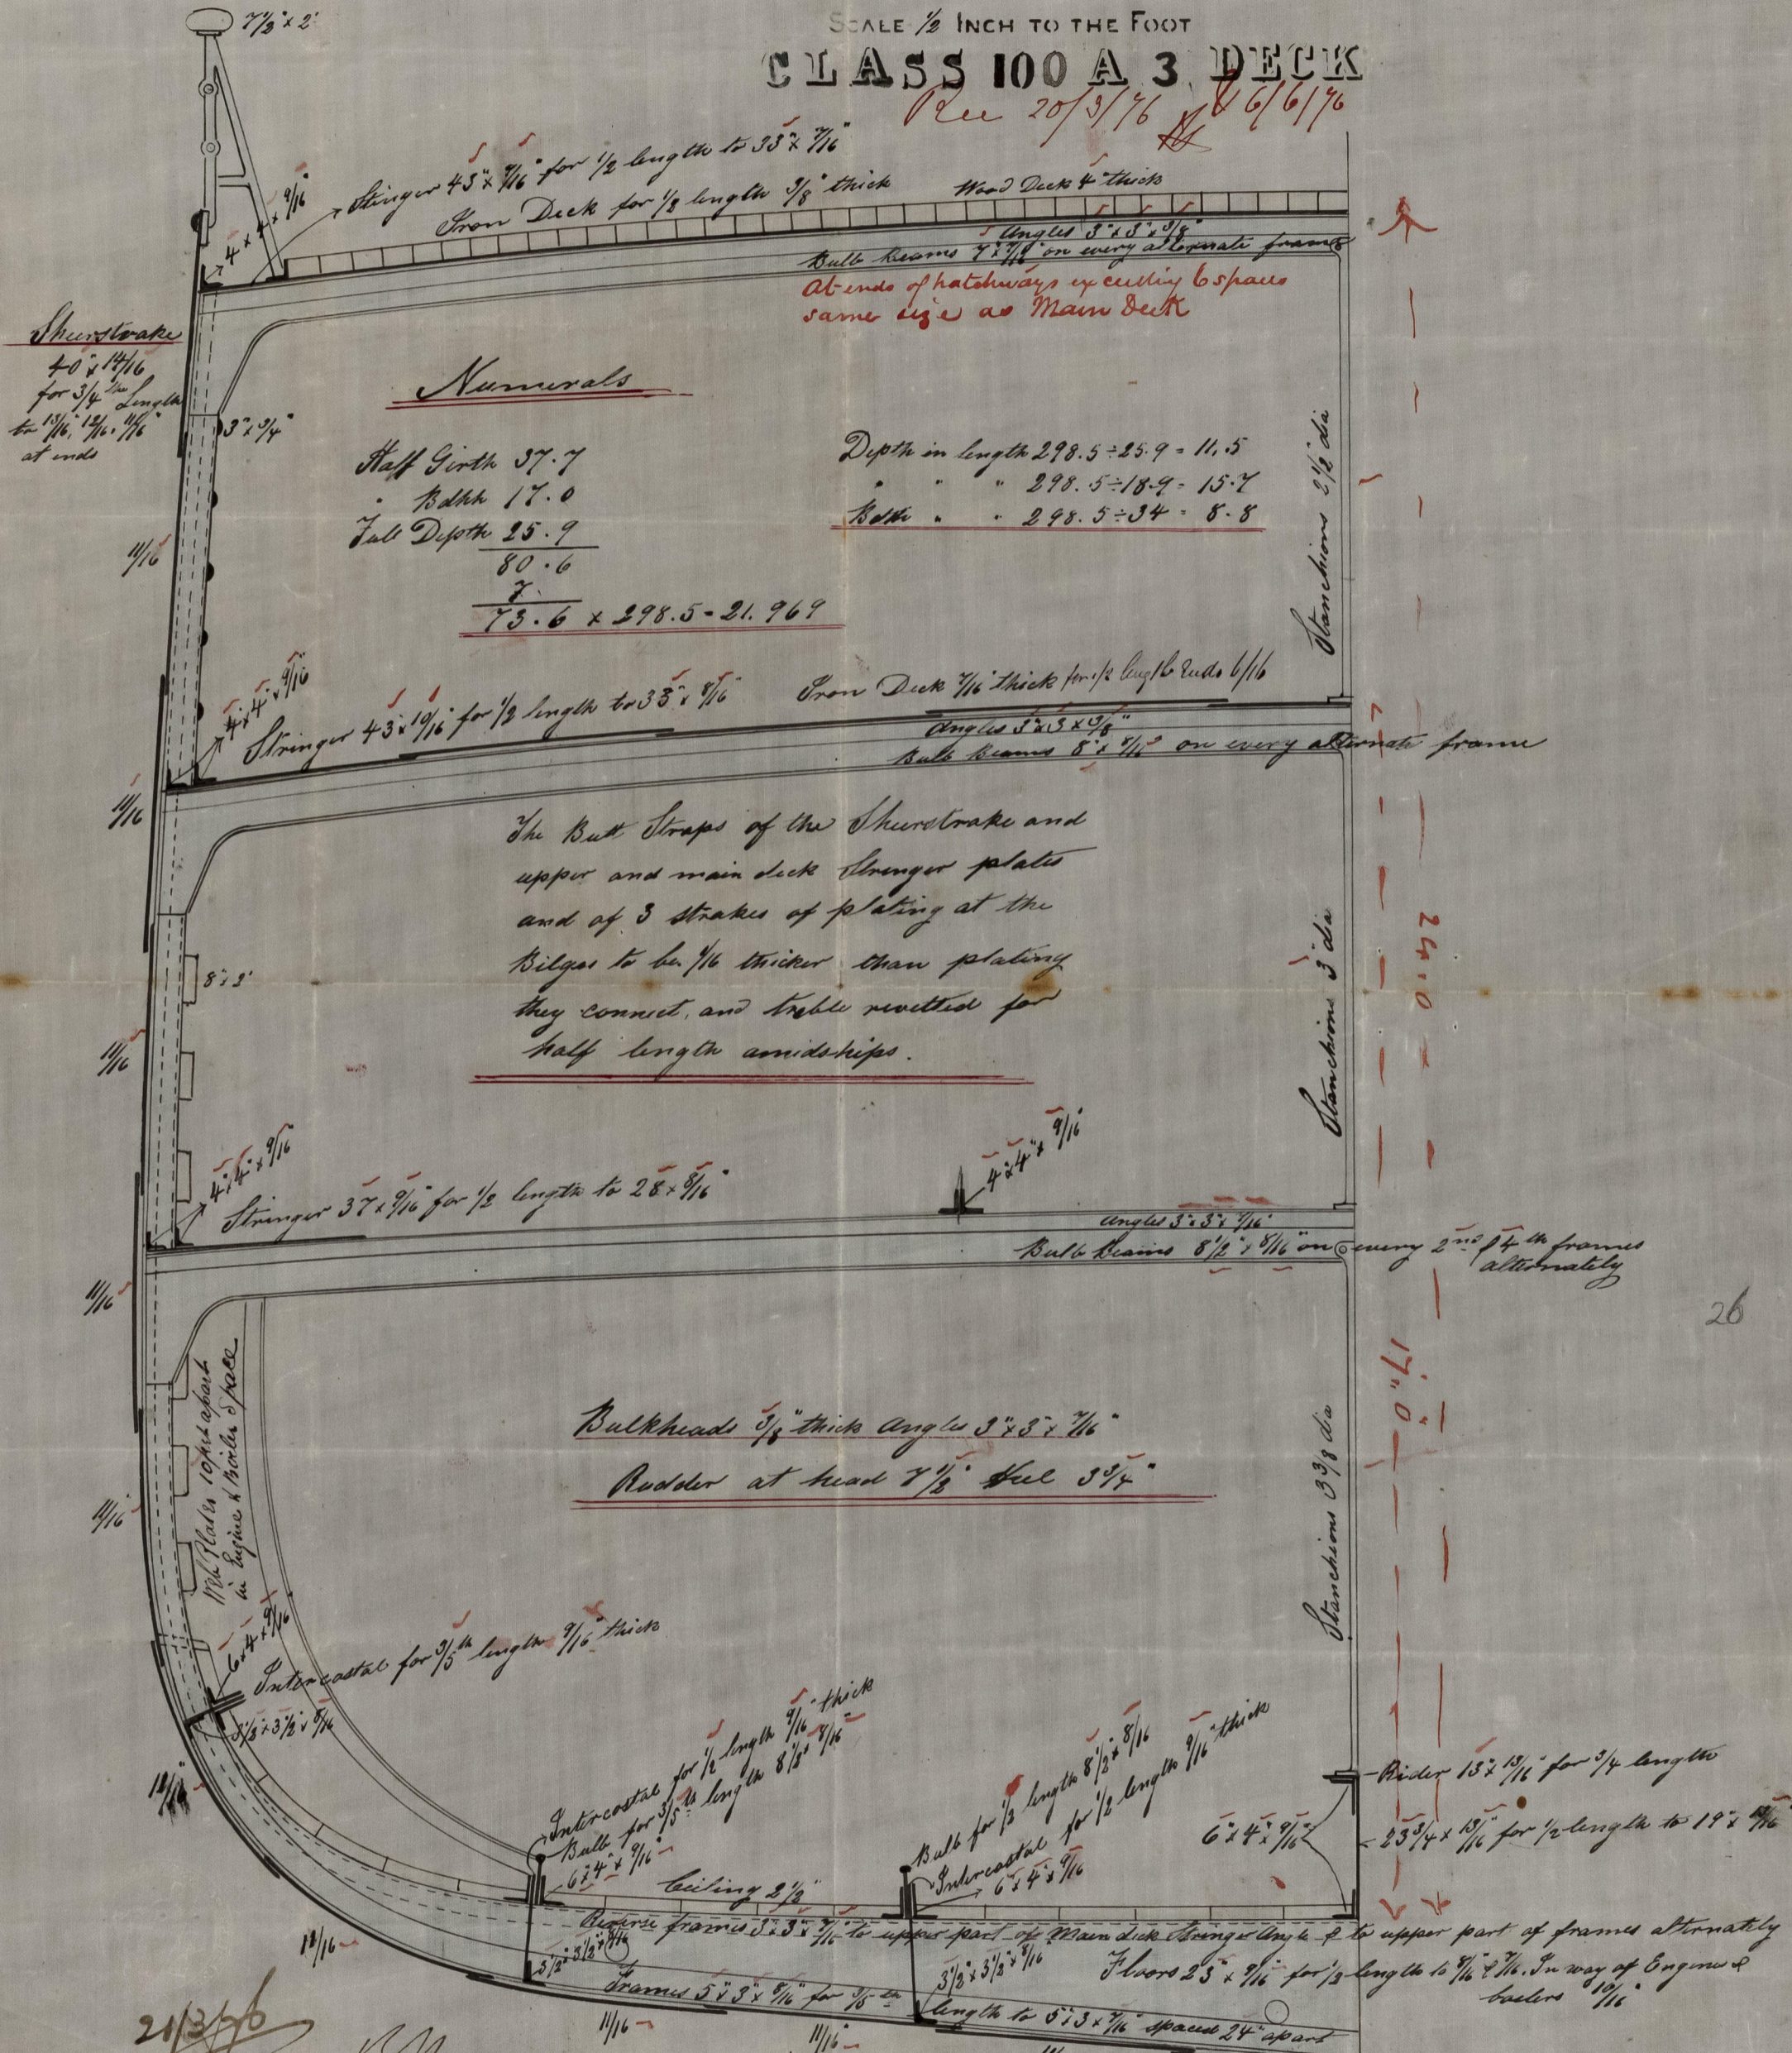

LONDON & GLASGOW
ENGINEERING & SHIPBUILDING CO.
LIMITED

15th March 1976

20/3/76

IRON 519-0063

Lloyd's Register
Foundation