

"RADNORSHIRE"
S.S. N^o 194


Midship section approved per Surveyors
minute of 22^d of March

Glasgow Report No 4360


LONDON & GLASGOW
ENGINEERS & IRON SHIPBUILDERS
Rev 6/6/76 & 1/7/76

Scale 1/8 Inch to one Foot

in letter
7/6/76
1/7/76

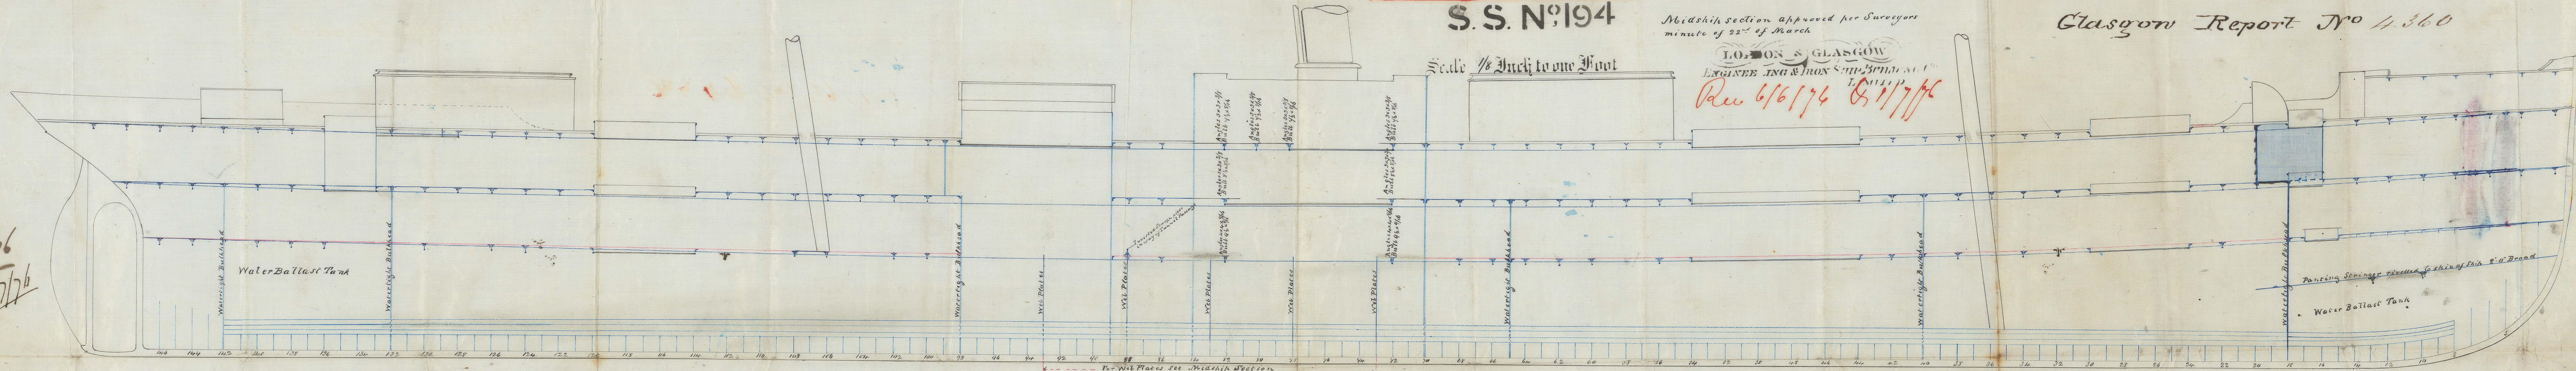

Upper Deck

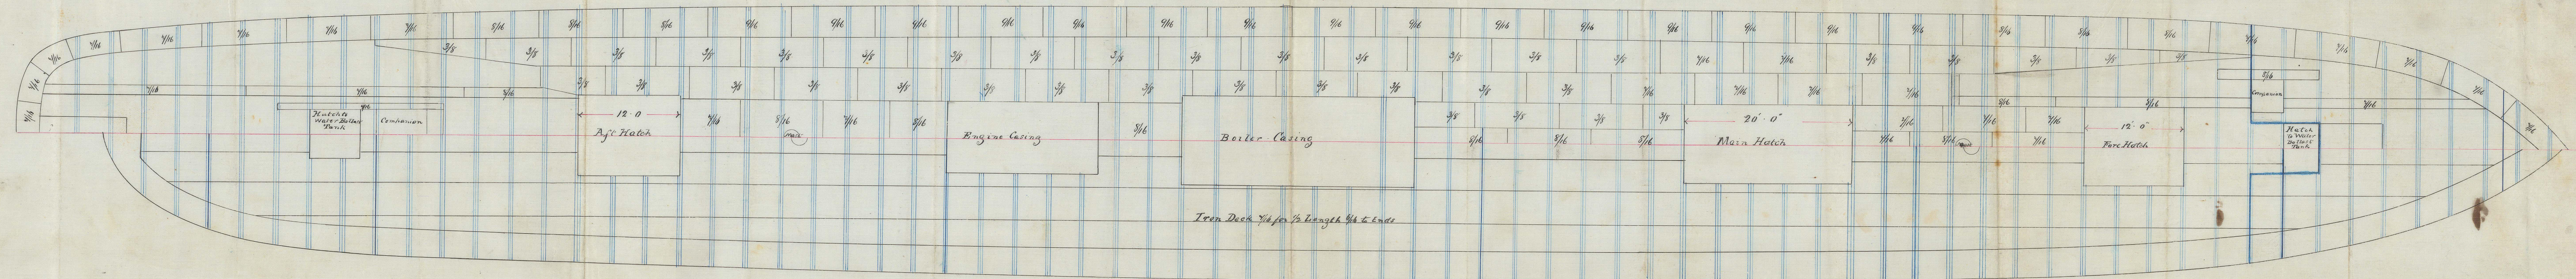

Main Deck

IRON 519-0064