


# "LOCH LINNHE"

Glasgow Report  
No 4364

18/12/75

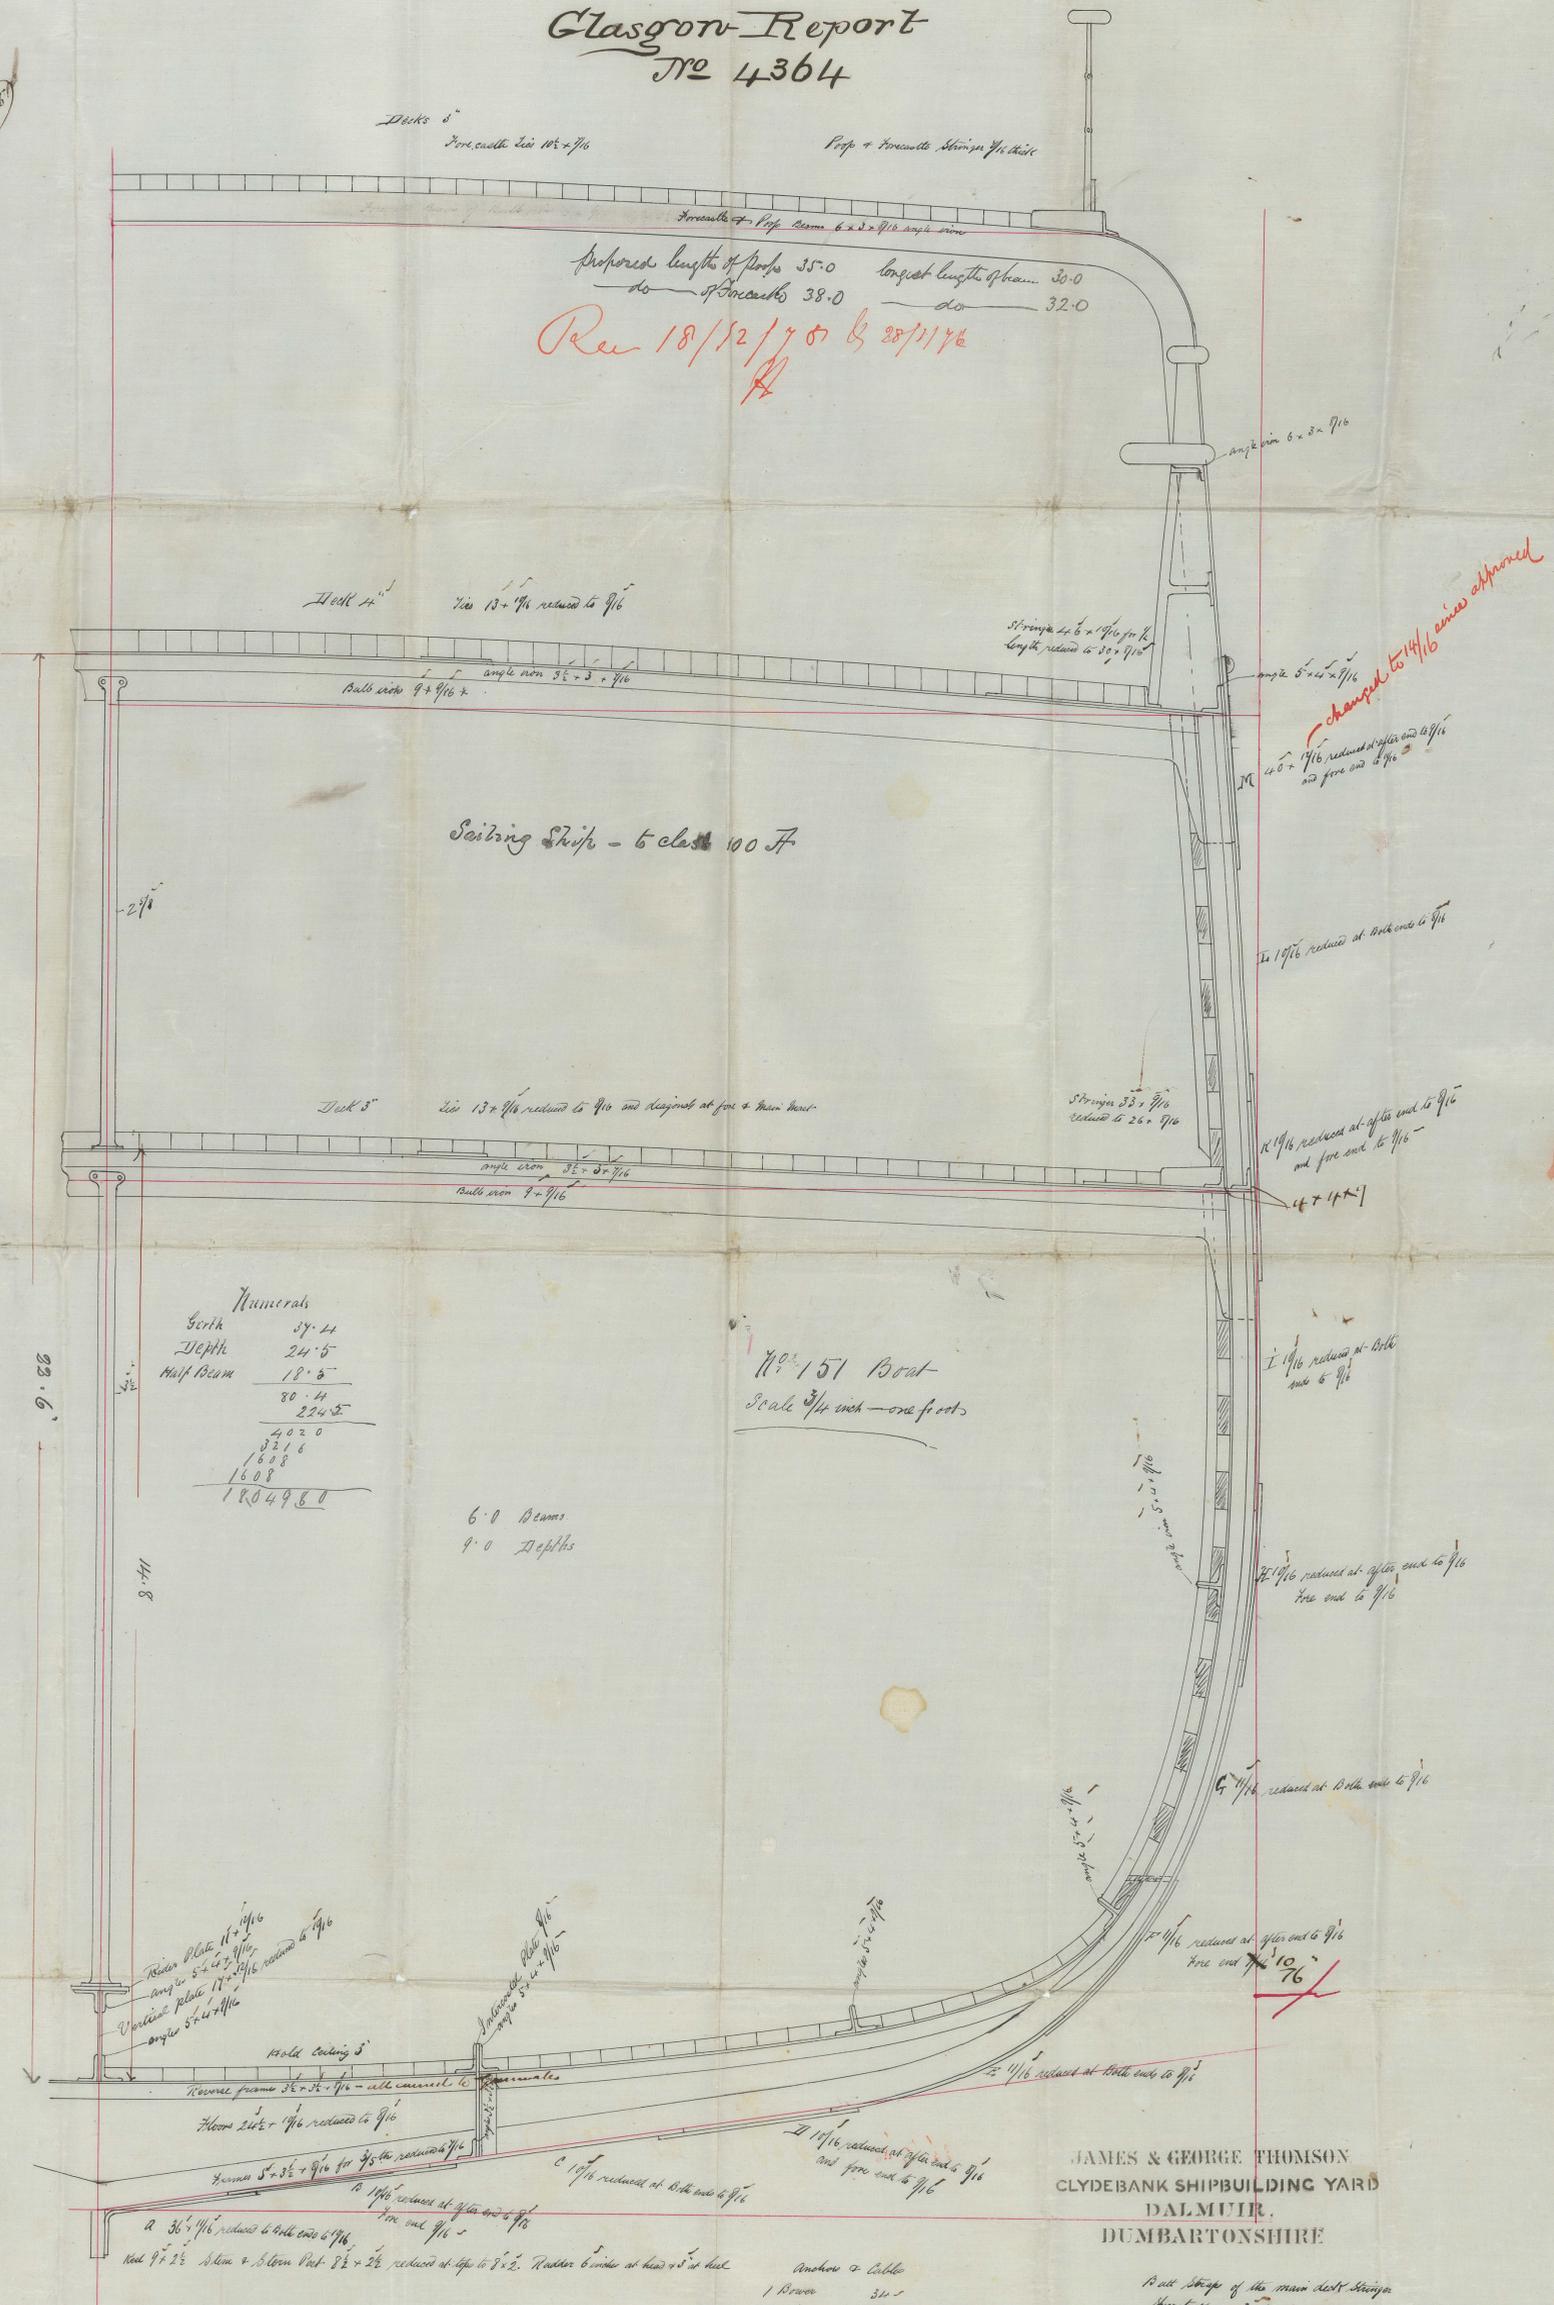

proposed length of keel 35.0 longest length of beam 30.0  
do of forecabin 38.0 do 32.0  
Rec 18/12/75 by 28/11/76

changed to 1 1/16 since approved

Numerals


No 151 Boat  
Scale 3/4 inch = one foot

6.0 Beams  
9.0 Depths

JAMES & GEORGE THOMSON  
CLYDEBANK SHIPBUILDING YARD  
DALMUIR,  
DUMBARTONSHIRE

- Anchor & Cable
- 1 Bower 30'
  - 1 do 33'
  - 1 do 30'
- 97' Collector weight on stock.
- 1 Steam 125'
  - 1 Trawl 8 1/4'
  - 1 do 3 1/4'
- 240 fms steel chain cable 1 1/4"
- 90 fms steam chain 1"

10 all Stays of the main deck Steerage  
Shrouds & 3 Stays of Mast  
round the Ship to be 1/16 thicker  
for 1/2 the length, snatching & brails riveted

Positions of Collision Bulwarks will be submitted

J.G.T.  
18/12/75

LOCH LINNHE

Rec'd Glasgow  
17/12/75 S.C.