

228 ft long overall  
222 ft long overall


# Midship Section of Iron Sailing Ship

No 152 + 3  
Scale  $\frac{1}{2}$  = one foot.

IRON 519-0072

31/1/76

Rec 31/1/76

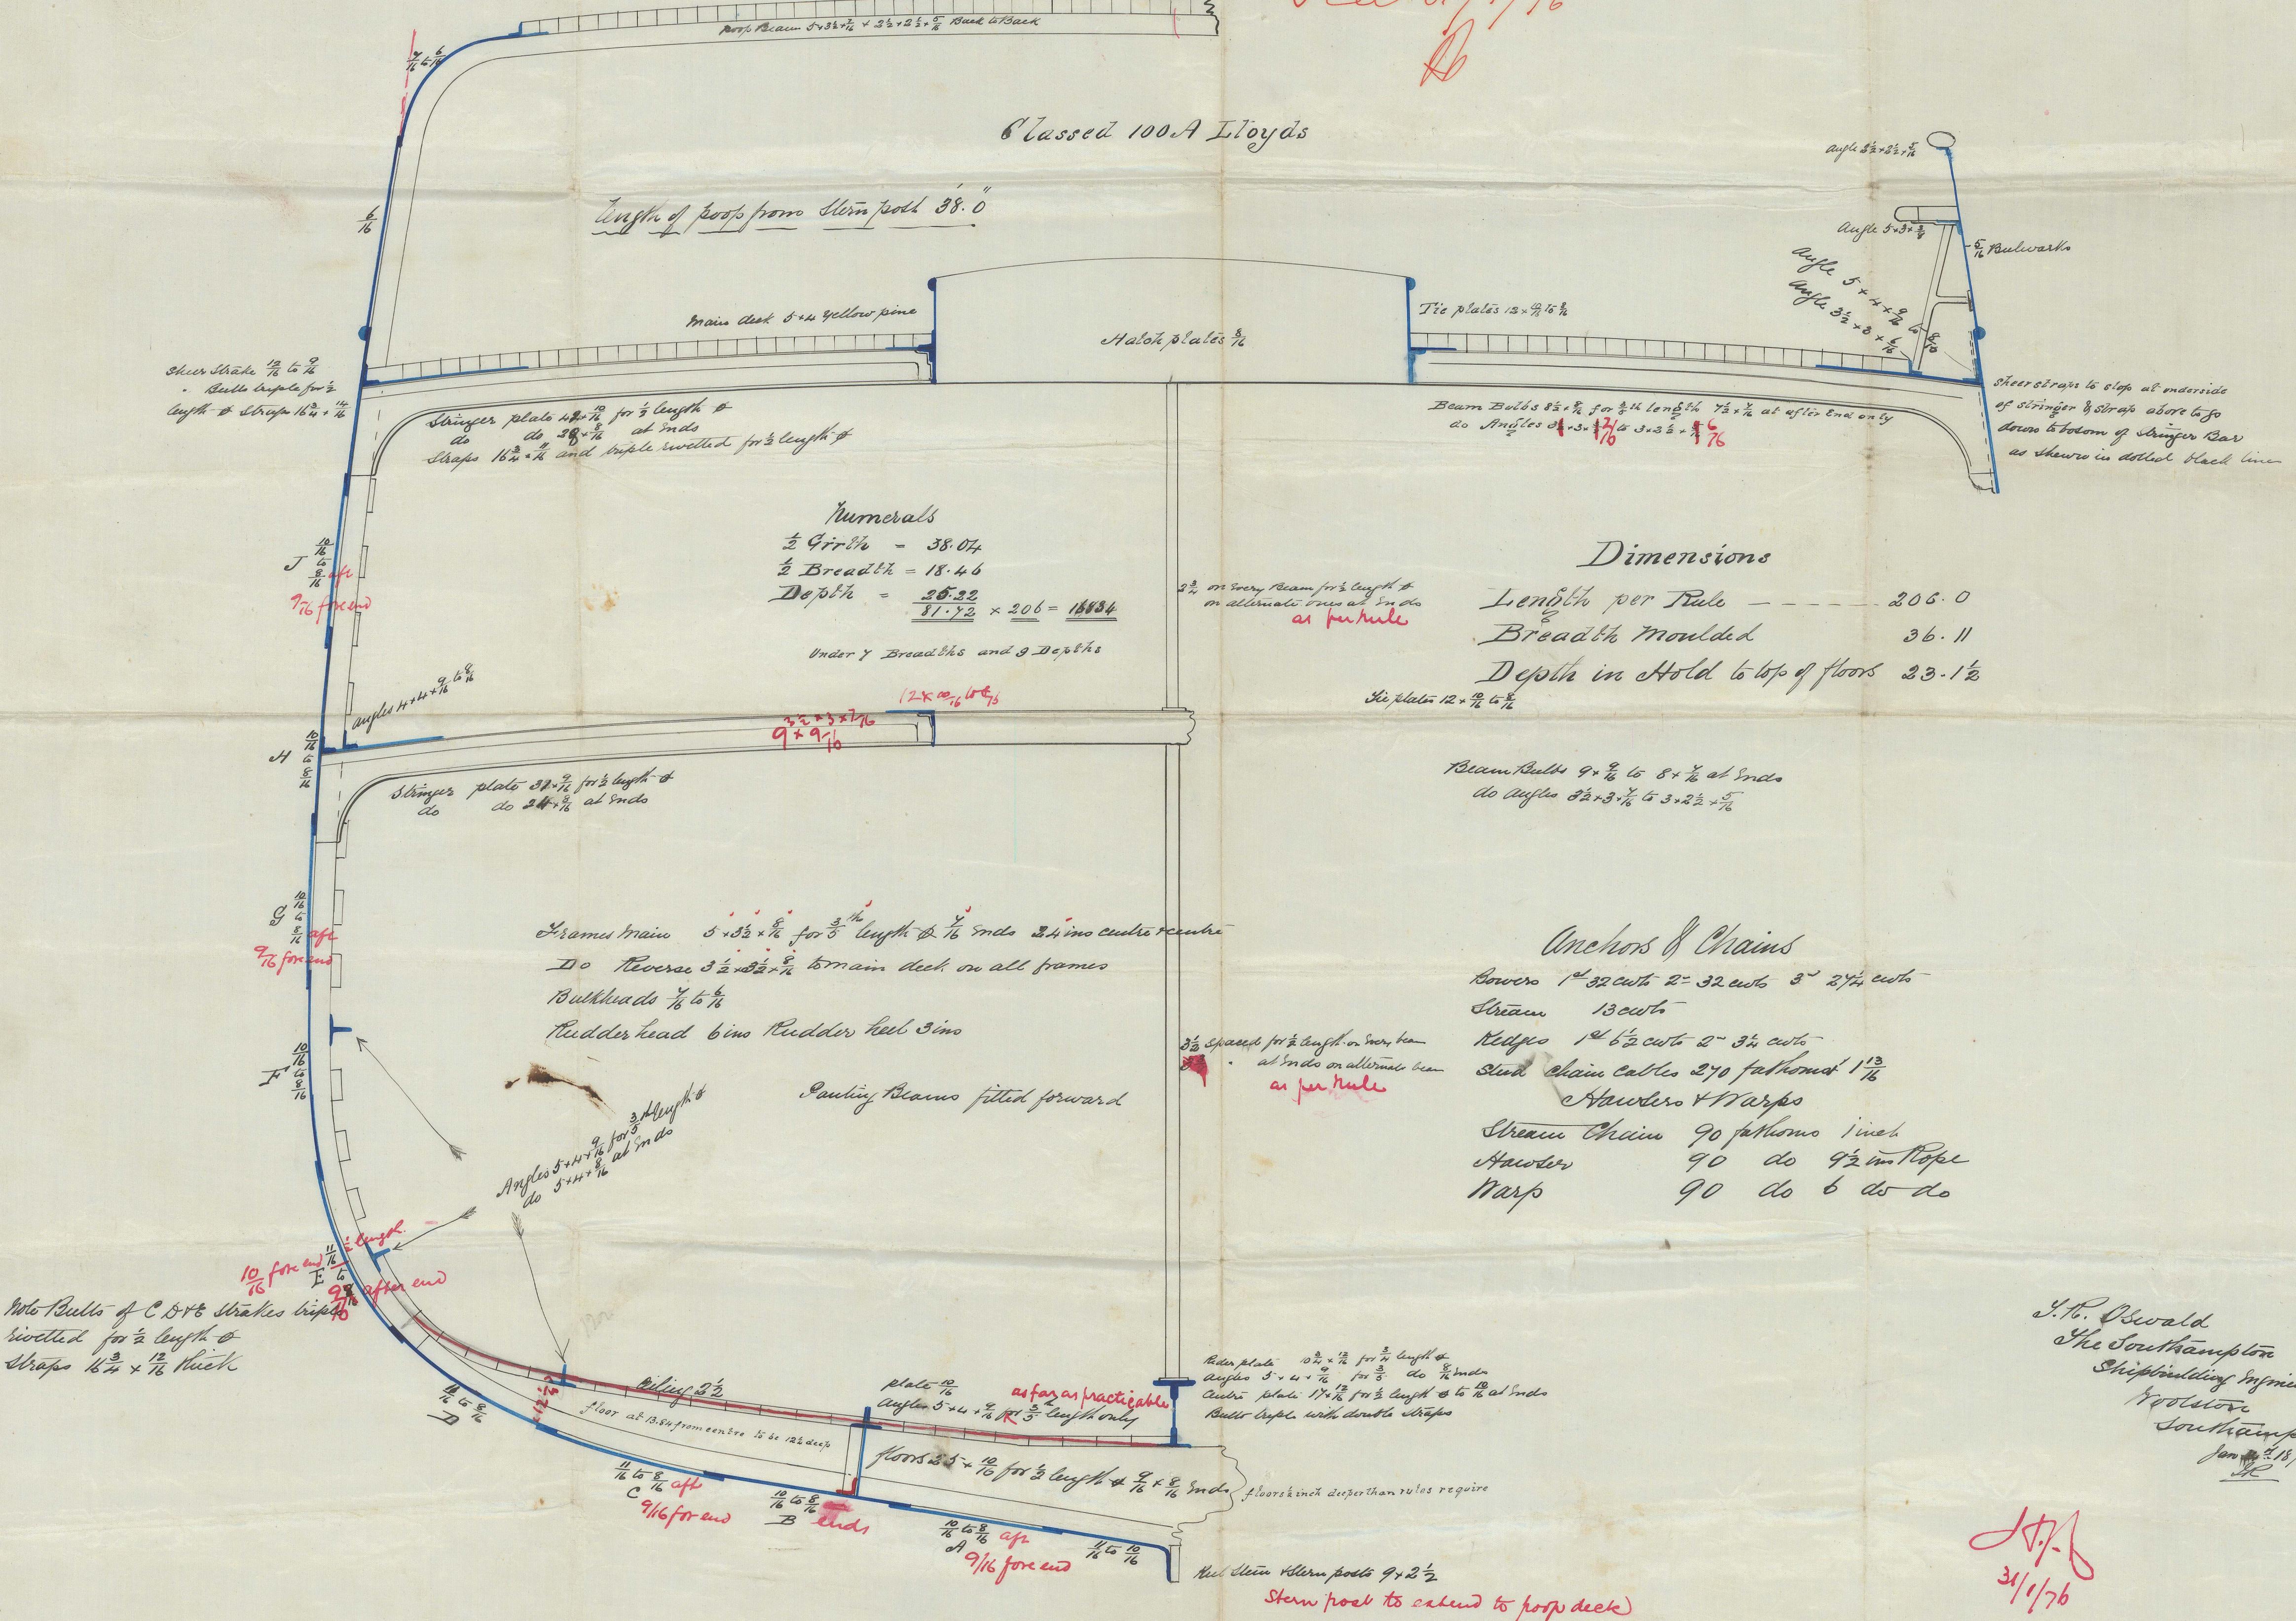

J. P. Oswald  
The Southampton  
Shipbuilding Engineering Repairing Works  
Southampton  
Jan 15/76

J. P. O.  
31/1/76

Cambrian Monarch

Iron Rpt 16856.

Cambrian Prince

Iron Rpt 17555.

IRON 519-0072

9/1/76



© 2021

Lloyd's Register  
Foundation