


23/6/76

S. L. Kietow
Report No. 3734

No 61 SS

Scale 1/8" = 1 foot

Rec 30/8/76 & 5/1/77
H

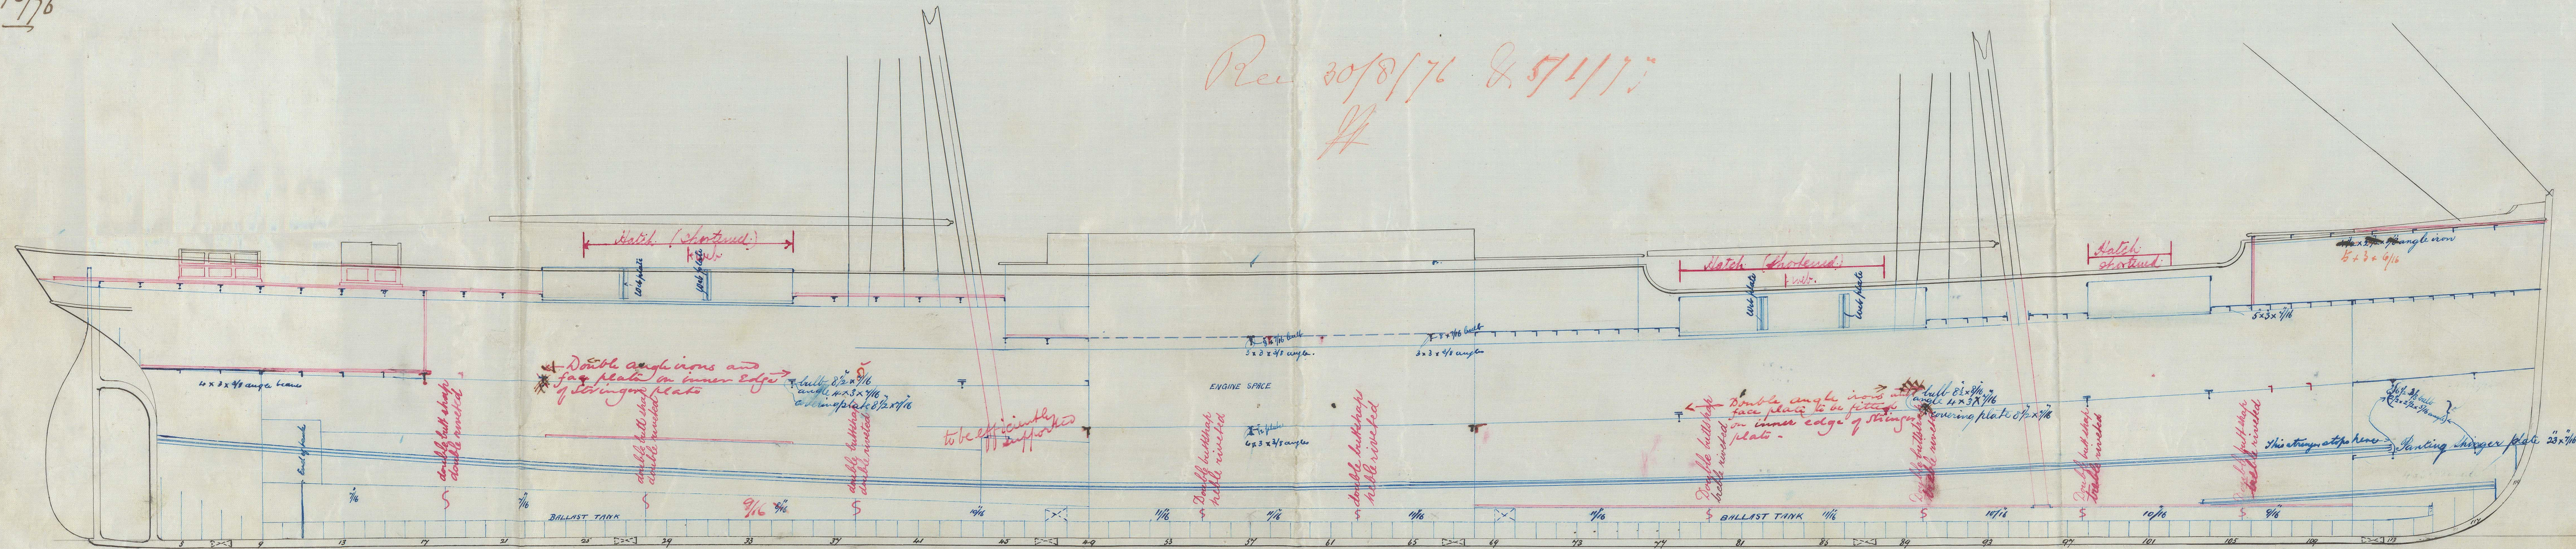

Strong steel beams (or ship) on 17, 25, 35, 43, 57 (plate) 73, 88, 98 and 104. Face plate or angle on inner edge of stringer plate as per rules

For Edw. Withy & Co
Geo. Cooper

22/6/76
30/8/76

21/6/76