

23/6776


Class 90A1 at Lloyds

— Scale  $\frac{1}{2}$ " = 1 foot

Rec 80/8/76  
H

Section thro Main D<sup>th</sup>

Section thro Quarter Deck

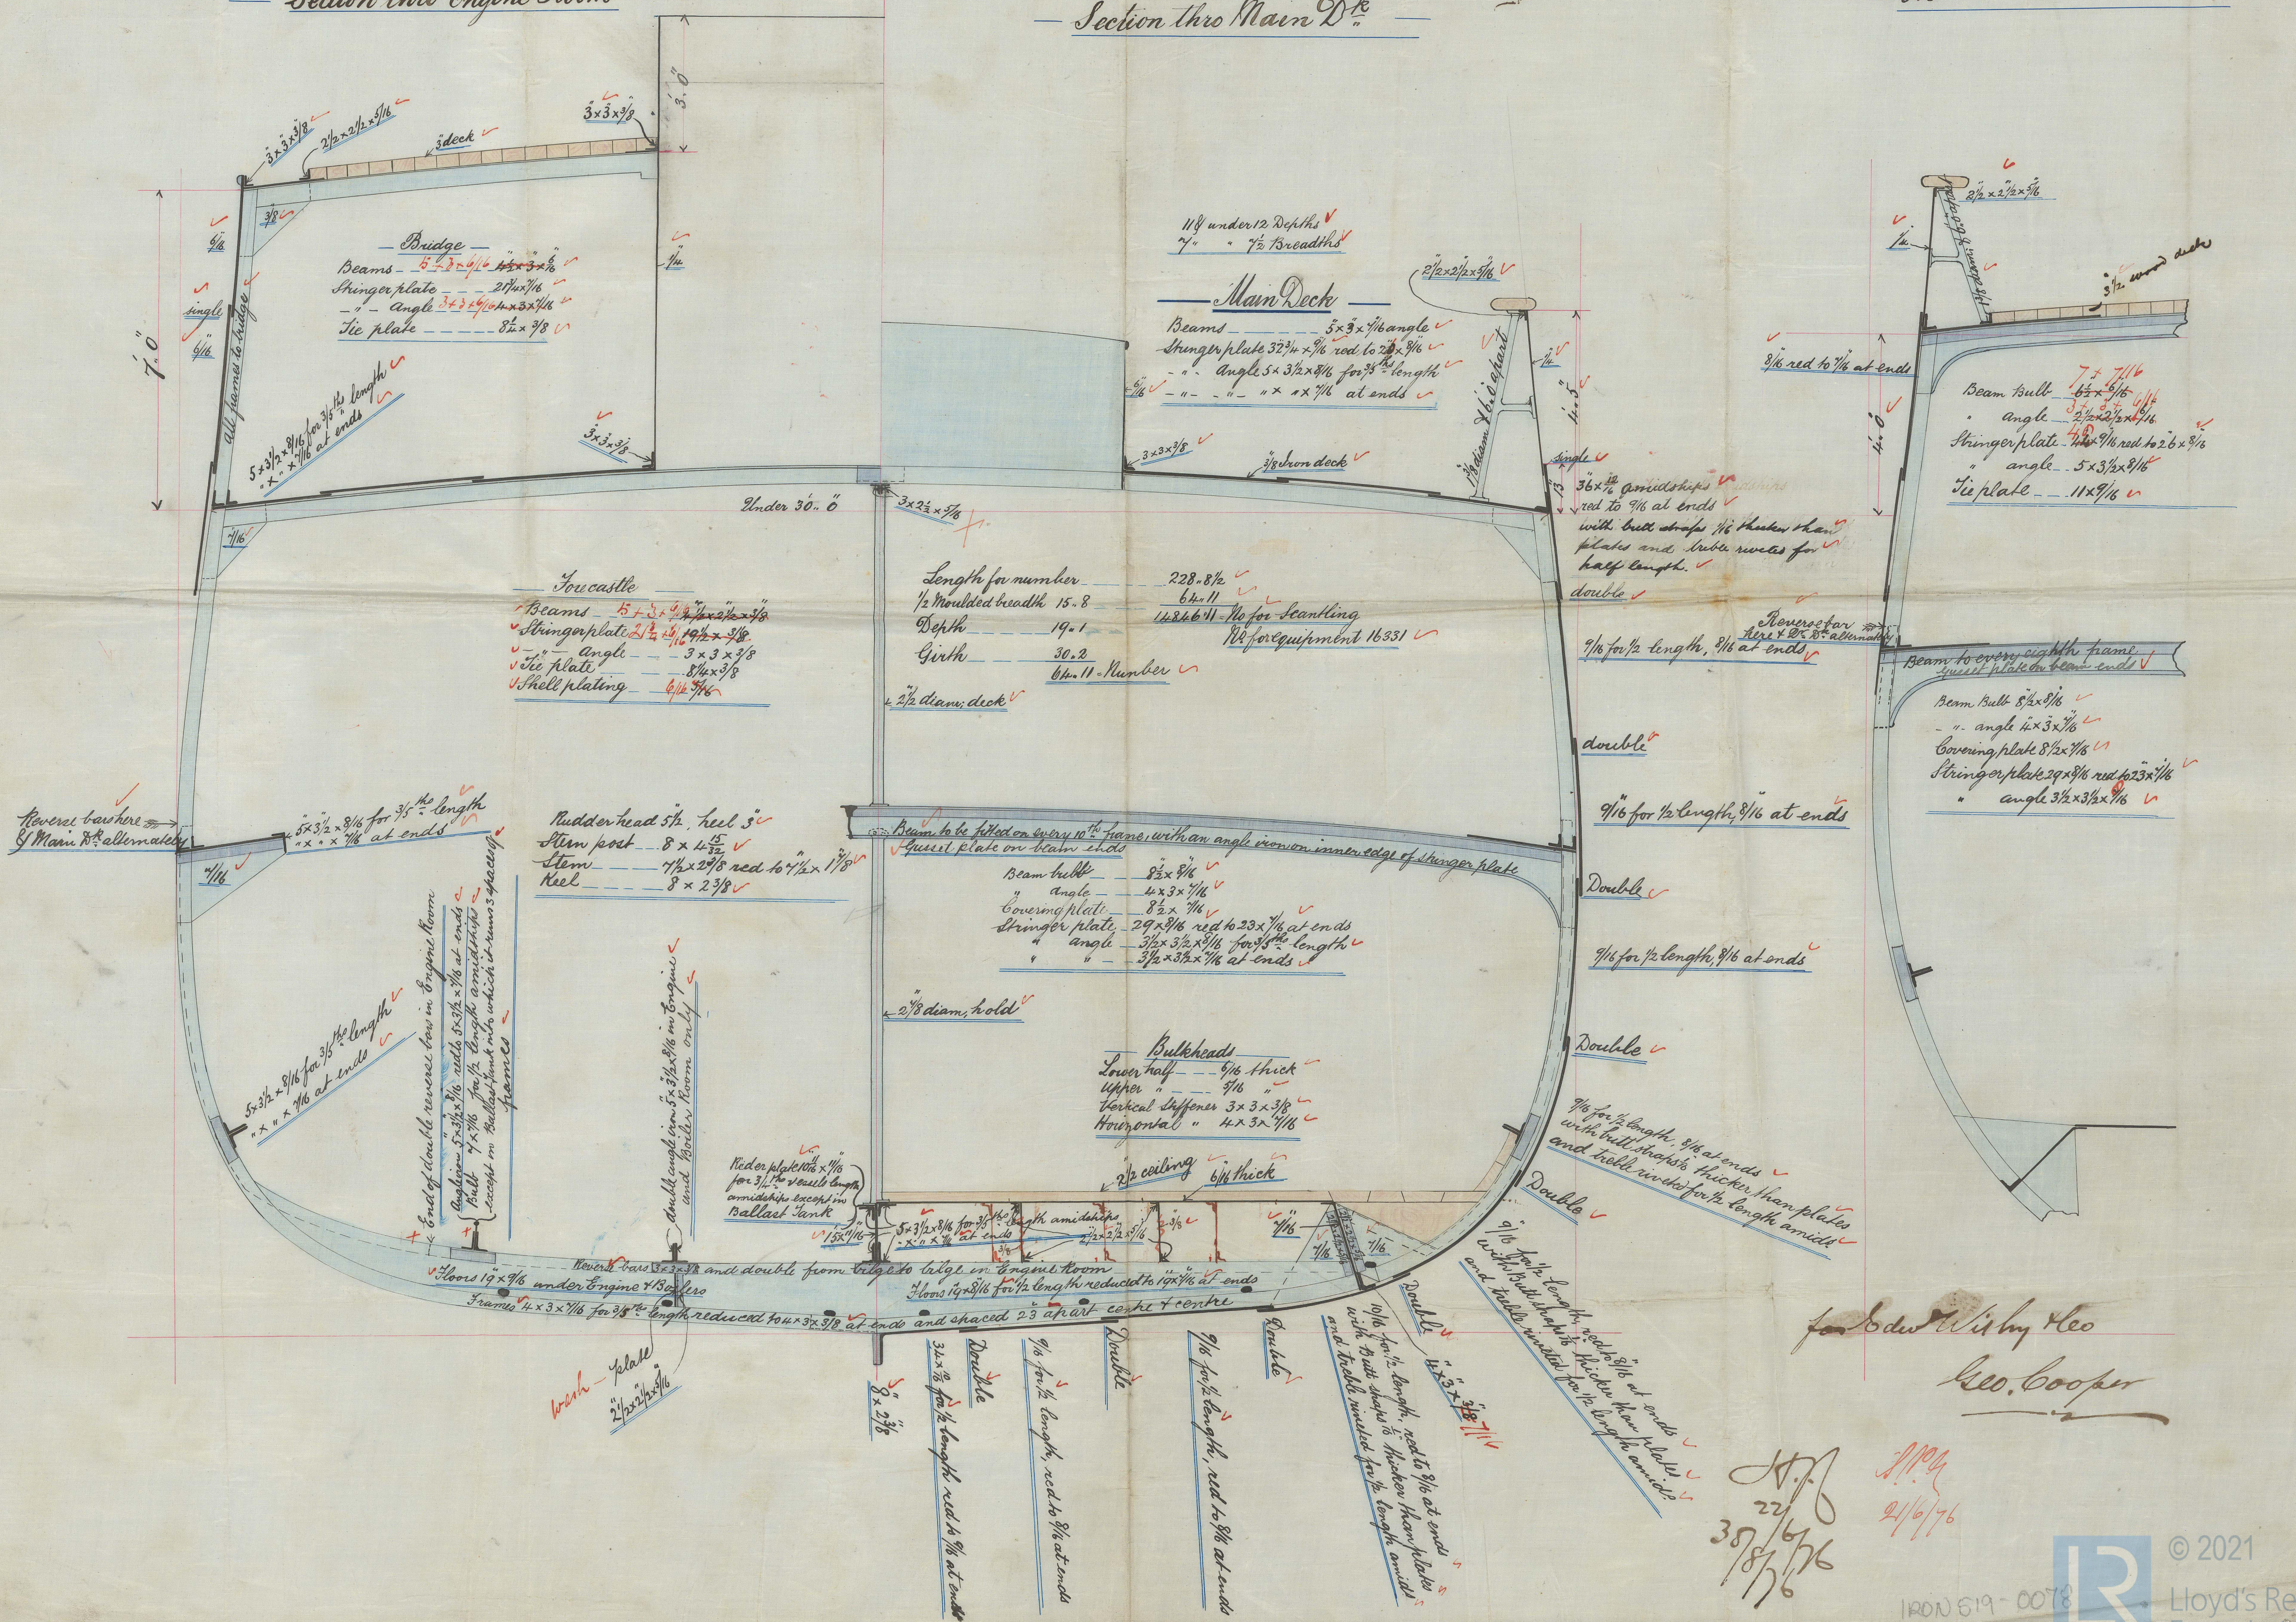

for Edw. W. H. by Leo  
Leo. Cooper

22  
 38 6/26  
 18 7/6

SP4  
2/6/76