



Sketch shewing Arrangement of Pumps to Water Ballast Tanks and Holds S.S. No. 90  
Scale 1/2" = 1 foot

J. J. Rosend Castle No. 11561

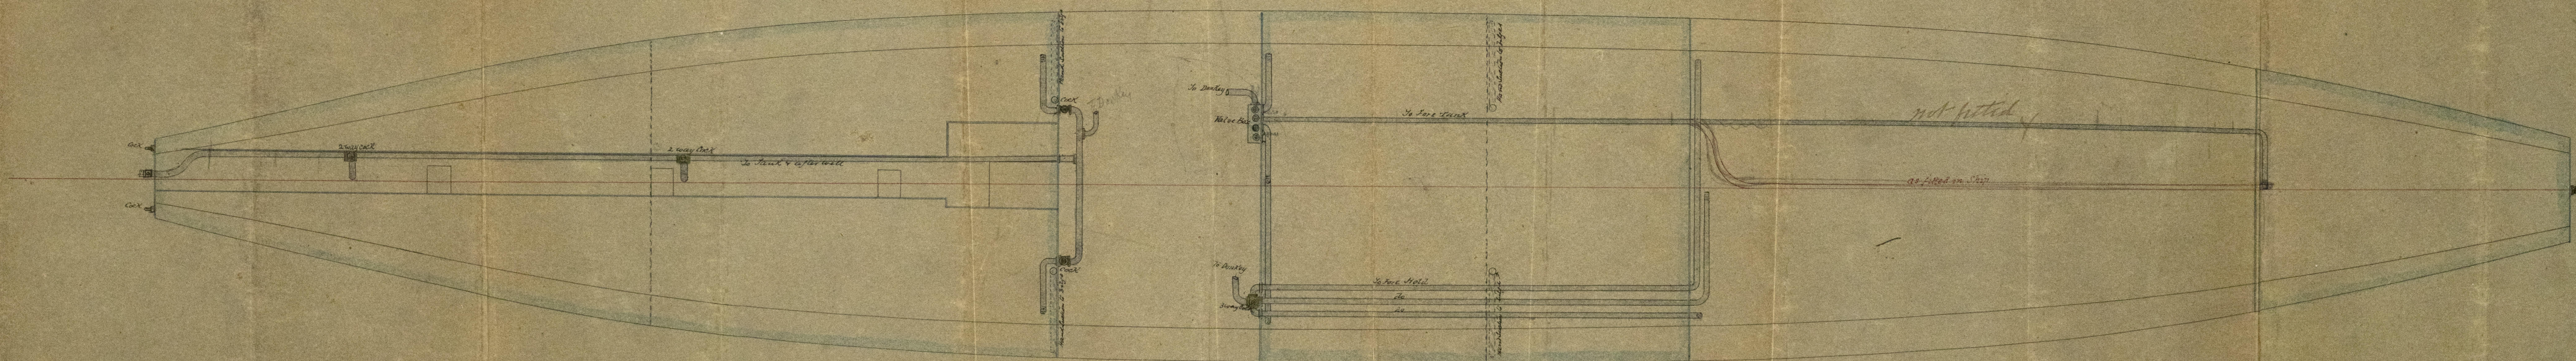

OB  
9/10/76

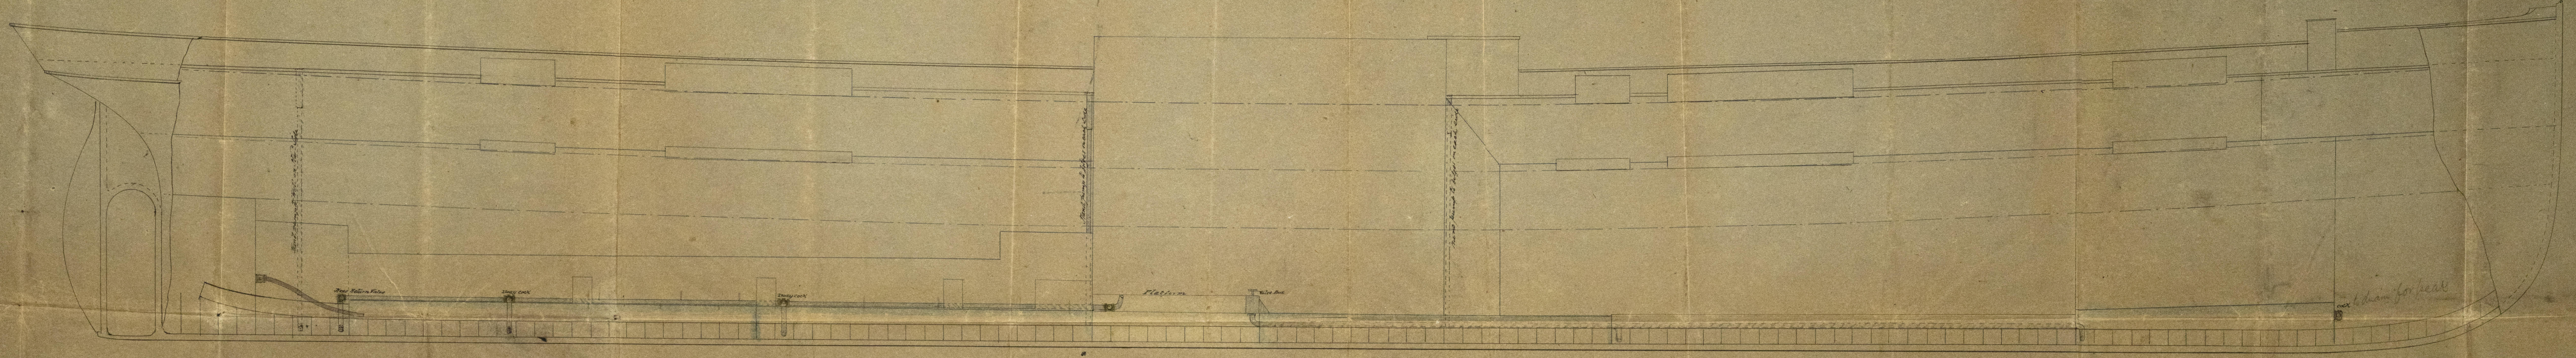