

$\frac{1}{2}$  Girth = 32.75  
 $\frac{1}{2}$  Breadth = 16.25  
 $\frac{1}{2}$  Depth = 21.5  
 1st Numeral  
 88.8  
 56.40  
 56.40  
 70.5  
 13310.40 2nd Numeral

18/9/76

No 116  
 Bk Lindores Abbey of Glasgow  
 Greenock Report No. 4185.


Dimensions  
 190 x 32.5 x 19.5 = Hold  
 188.8 x 32.5 x 21.5 = Per Rules

Class 100 A

Length of Poop = 32-0  
 Length of O. G. Forecastle = 26-0  
 Main Hatch = 14-6 x 10  
 Fore Hatch = 6-0 x 6-0  
 Aft Hatch = 5-0 x 5-0

Per 18/9/76

Butt Straps Existing  
 The Butt Straps of Main Deck Stronger Plates Sheer Straps  
 and Fore-bilge Straps for half length are to be  $\frac{1}{16}$   
 thicker than the plates they connect and to be rivetted.  
 The Butts of center-bulkhead Straps and to be rivetted per Rules.

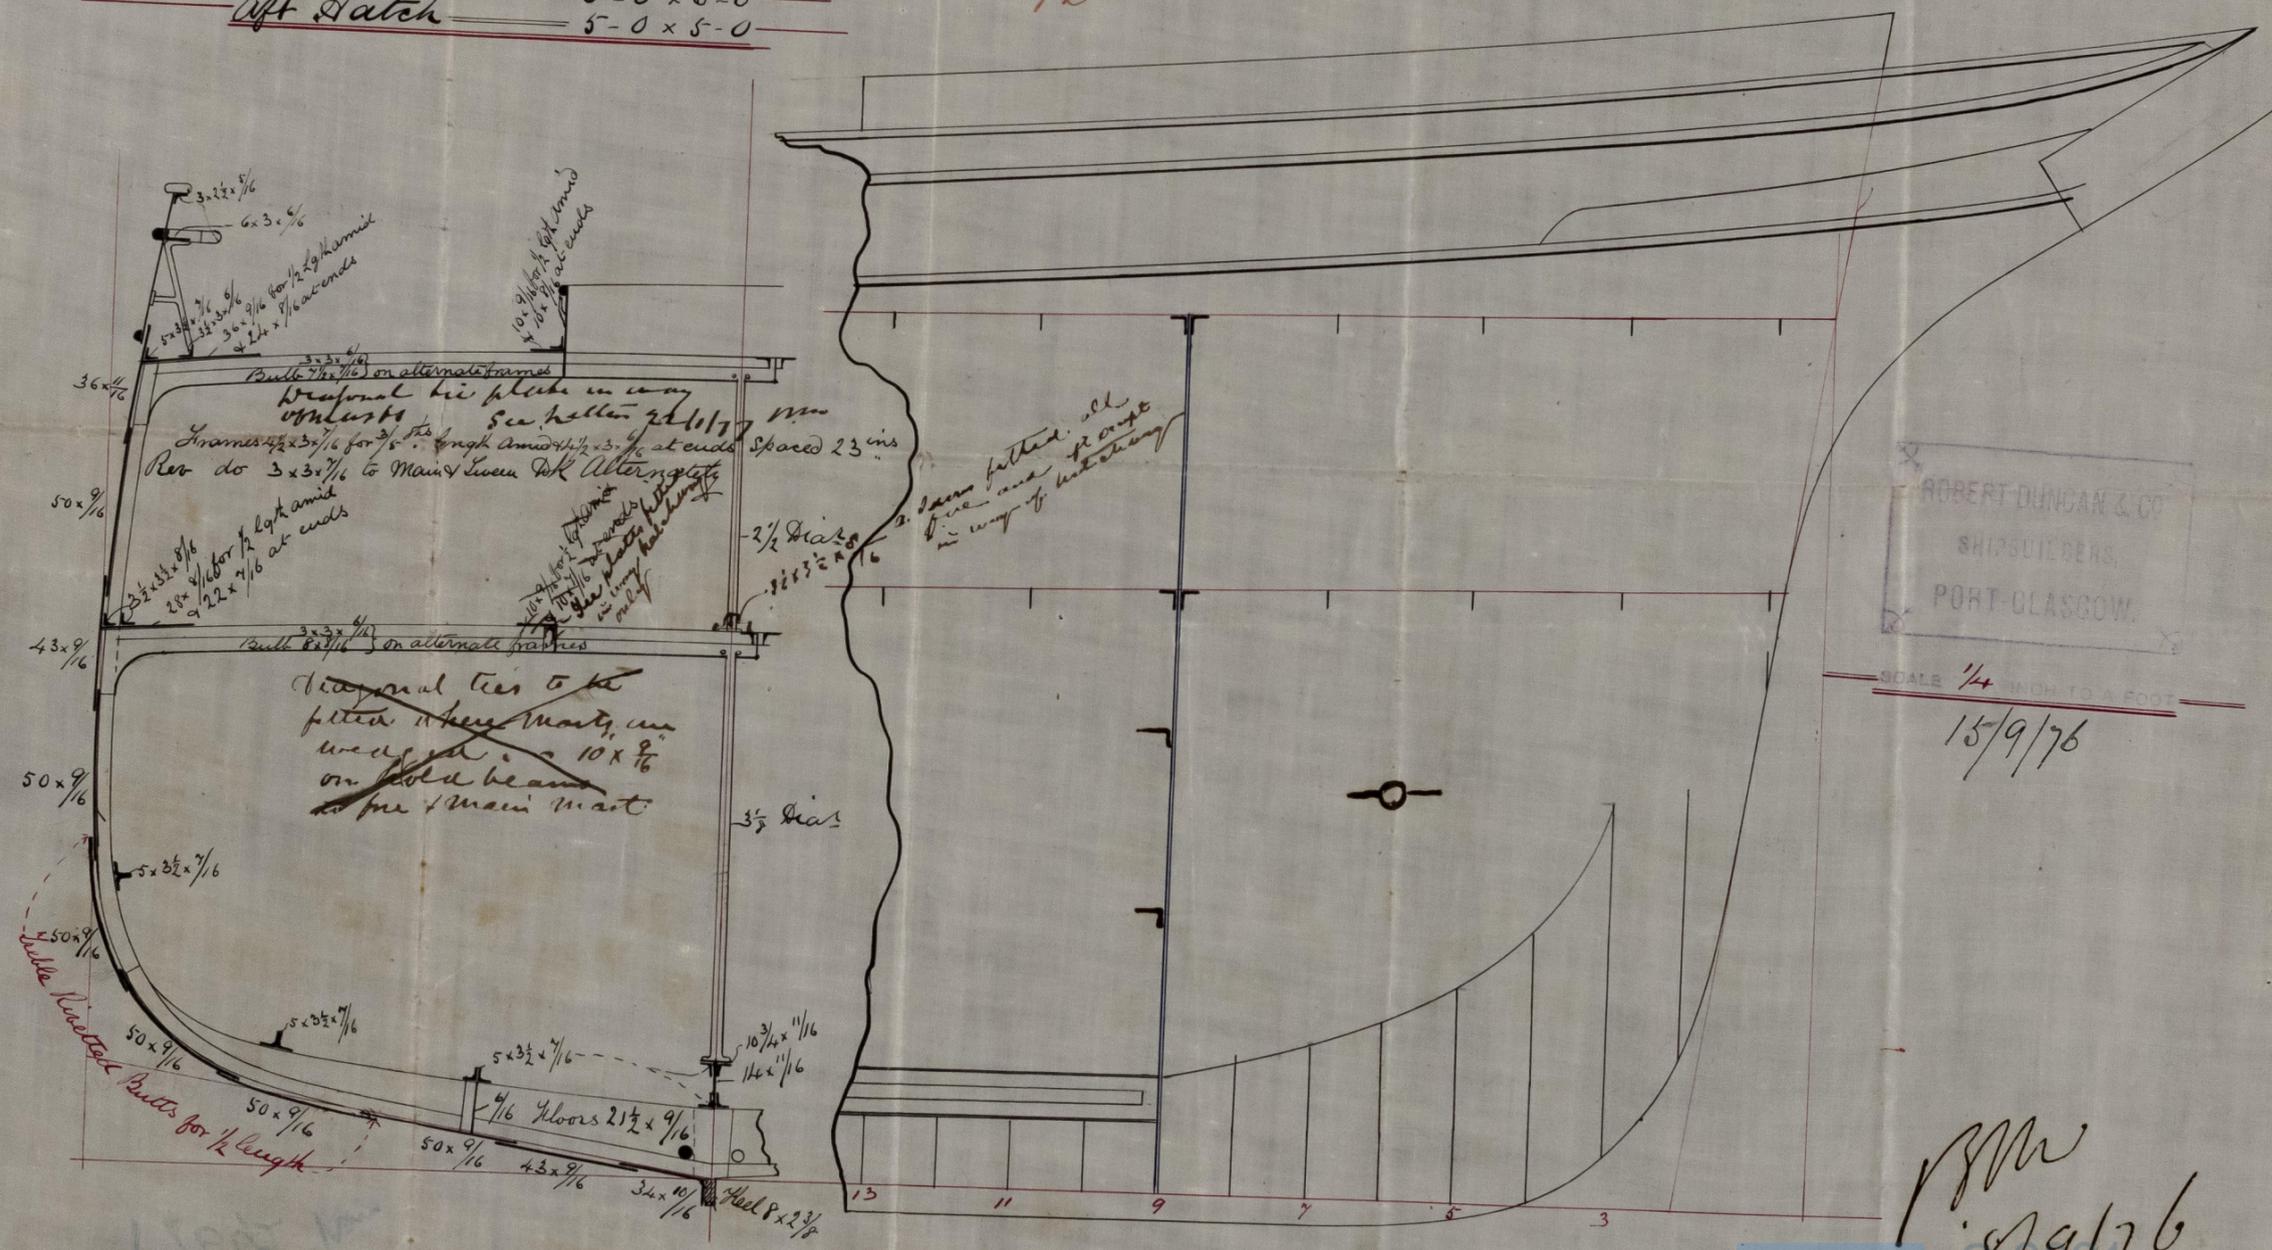

ROBERT DUNCAN & CO  
 SHIPBUILDERS,  
 PORT-GLASGOW.

SCALE 1/4 INCH TO A FOOT  
 15/9/76

RDM  
 18/9/76




IRONSIA-0116

9/16/18!

17692 Iron

IRON 519-0116

Vertical handwritten notes in red ink, possibly a list of measurements or specifications.

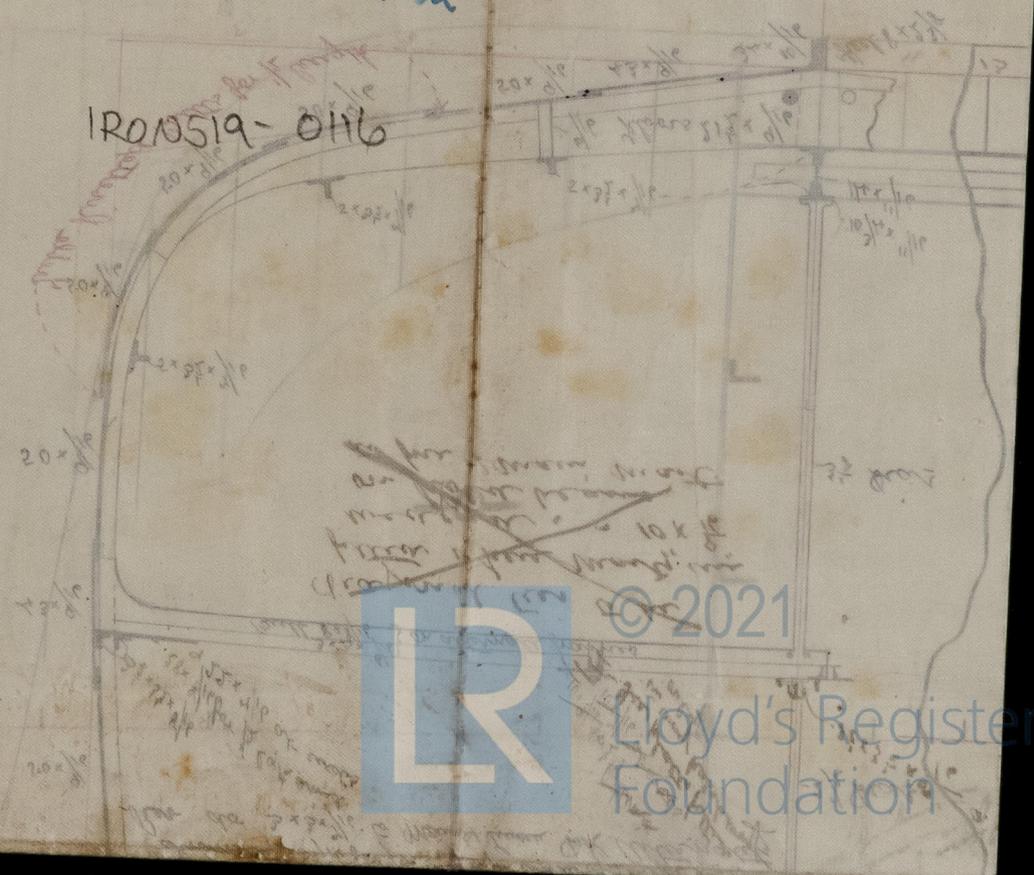

© 2021  
Lloyd's Register  
Foundation