

S'S "Sicily"

Lane No.
Birkenhead Iron Works,

Jan. 31st 1876.

Rec. 2
Lit. 31/1/76 N° 437


1851 Screw Steamer 245 ft x 33 ft x 23 ft Hold.

Lloyds 100 A. Two Decked Vessel.

Scale $\frac{1}{2}$ " = 1 foot.

Notes

Since drawing this section
it is decided to fit a
complete Ten Main deck.
This stringer will therefore be
reduced according to Rule to
40" instead 56" wide -.

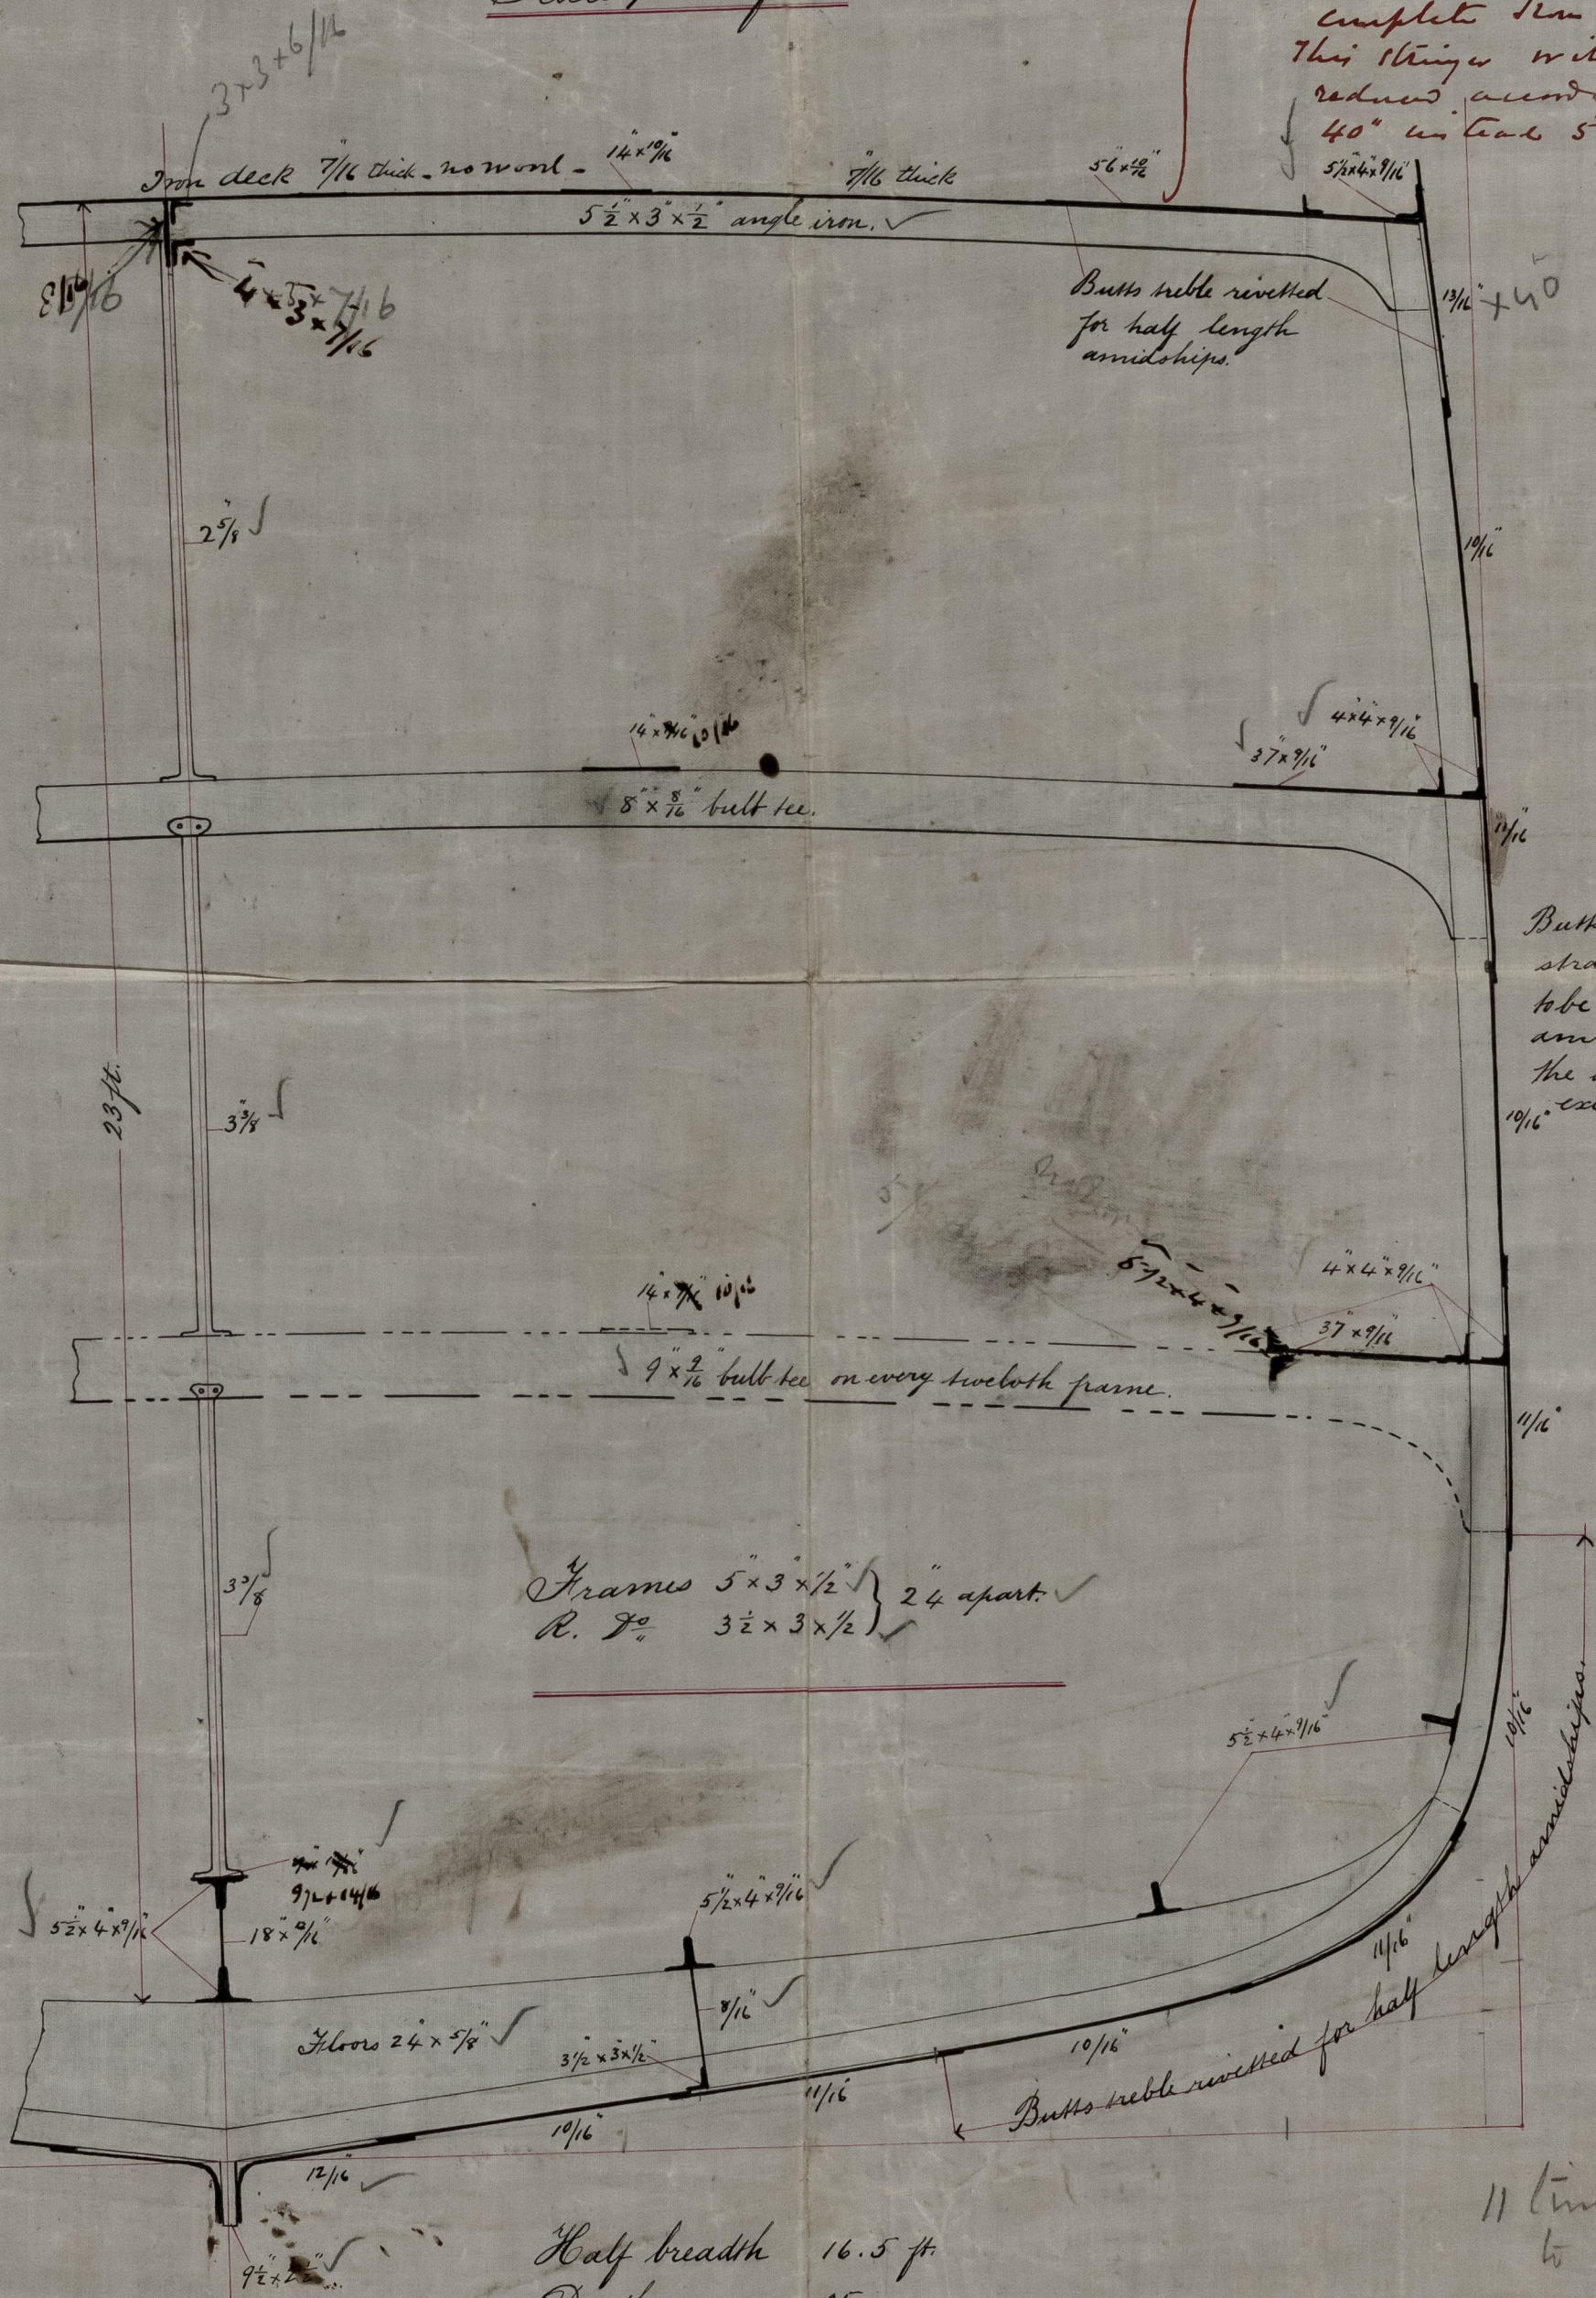

Butts of outside
strakes of plating
to be neatly riveted
amidships where
the breadth of plates
exceeds 44 inches


Frames $5 \times 3 \times \frac{1}{2}$ } 2" apart. ✓
R. Jo $3 \frac{1}{2} \times 3 \times \frac{1}{2}$ }

9. 7 L
Lipard 2/2/76
2

11 times for deposit
to Laid

Half breadth	16.5 ft.
Depth	25. "
Half girth	37.35 "

1st number $78.85 \times 245 = 21684$ (2nd number)

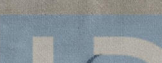
 Sam 2021 breathers
 for) ✓
 to be on 3-3
 Lloyd's Register
 Foundation

IRON 519 - 0119