


S.S. "City of Gloucester" Dundee Regt No 4032.

DLS 12.2.77

Tracing No 2 of St No 3 showing alterations  
 scale 1/4" = one foot  
 Rev 28/9/76

For plan of shells &c see other tracing.

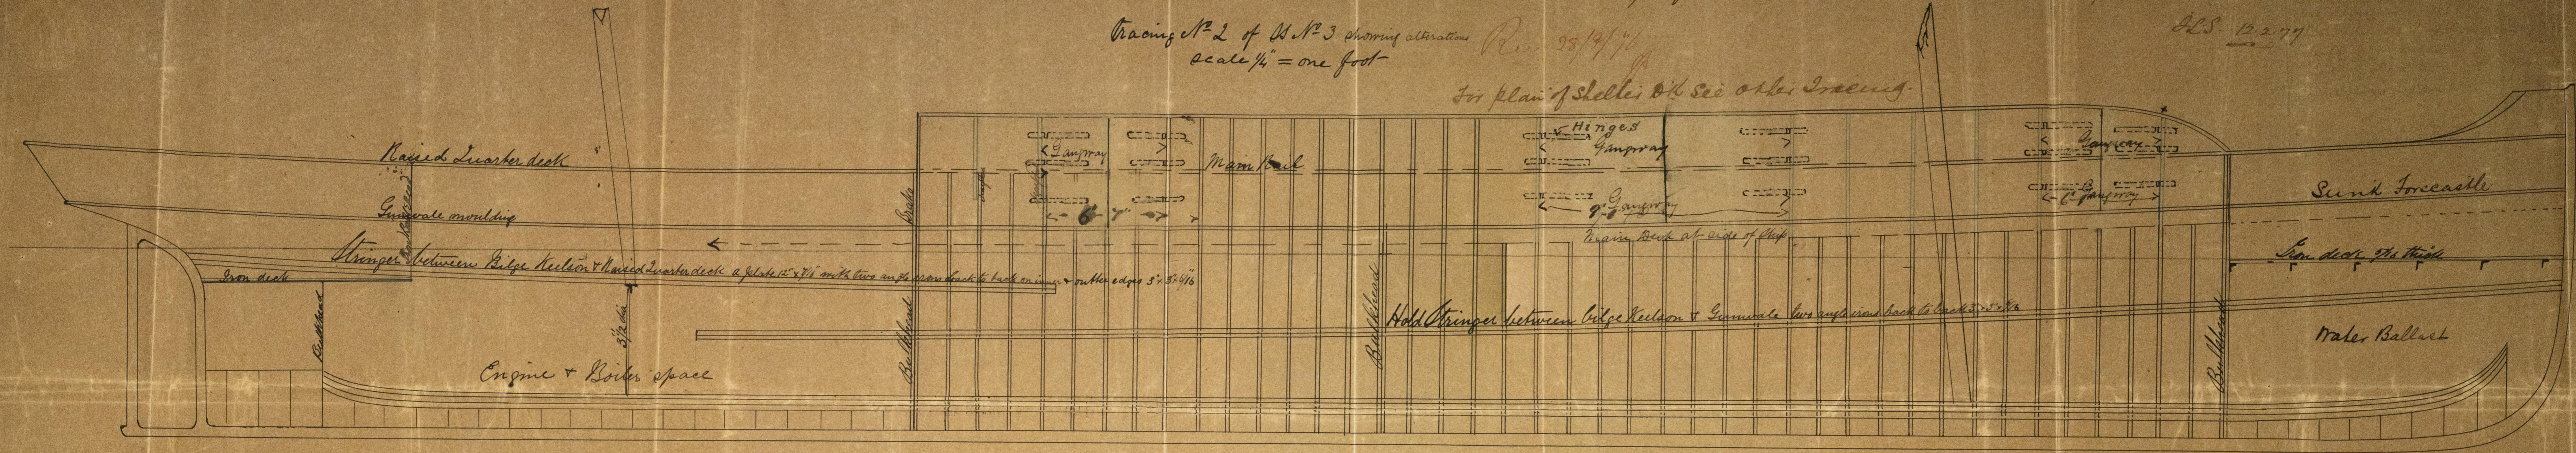

Black & Noble  
 IRON SHIP BUILDERS  
 MONTROSE

J.H.  
 28/9/76

IRON 519-0136