


S.L. Evelyn
 Report No. ³⁷⁶⁰~~3759~~ N^o 162

Rev. 15/9/96 & 18/9/96

7/7/96
 20/7/96

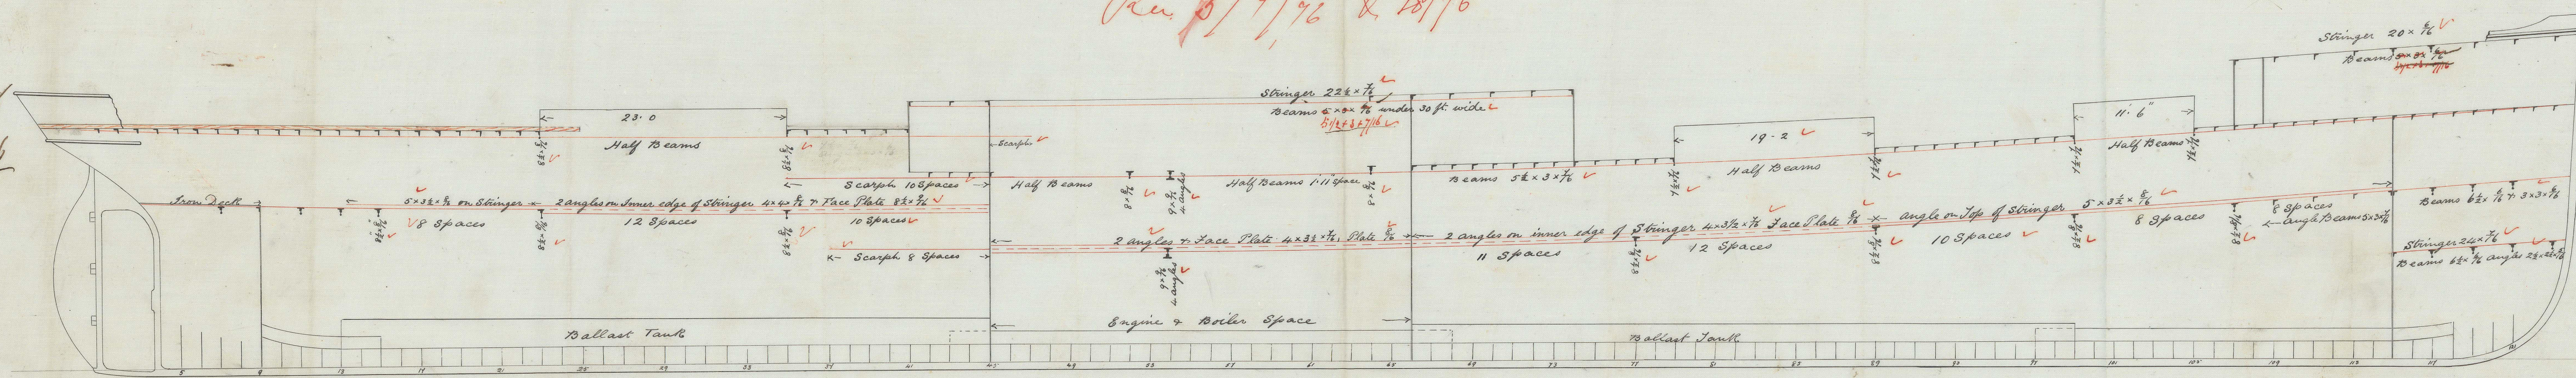

SCALE 1/8 INCH = 1 FOOT

18/9
 19/7/96

18/9
 4/7/96
 18/9

W. GRAY & CO.
 IRON SHIPBUILDERS
 REPAIRERS
 WEST HARTLEPOOL
 IRONS 19-0140

Lloyd's Register
 Foundation