

100 A grade

Midship Section

S. S. 7p 75

Redford 25/2/70

-45 + 10/16 for 1/2 length
This is in excess of 1/2

Lloyds Numbers

Depth to Keel at Midship Frame			28.200
$\frac{1}{2}$ Girth	a.	a.	40.458
$\frac{1}{2}$ Breadth	a.	a.	17.500
			<hr/> 86.158

Deduct 7.000
 12.155

Clouds Length = 79.138
 313.95

Number of Steps (top of Upper Neck to Neel) in Loyas Length = 24852.415 ✓
 do do (- Mari - -) - - - =

Breathes 8.9

1 1/16 for 1/2 length
1 1/16 to 3/4
Gradually reducing
to 1 1/16 at ends

2 Butt Straps
1/16 thicker and
flange riveted
for 1/2 length

11/16 for $\frac{1}{2}$ length
40/16 to $\frac{3}{4}$
9/16 at ends

11/16 for $\frac{1}{2}$ length } Butt straps
10/16 to $\frac{3}{4}$ } 1/16 thicker and
9/16 at ends } irreplaceable
for $\frac{1}{2}$ length

11/16 for 1/2 length
10/16 to 3/16
9/16 at ends

W/16 for $\frac{1}{2}$ length } But 18 strands
10/16 to $\frac{3}{4}$ } 16 thick strands
9/16 at ends } in doublets
for $\frac{1}{2}$ length

11/6 for $\frac{1}{2}$ length
11/6 to $\frac{3}{4}$

1/2 lengtly Butt Strap
3/4 do 1/4th of 1/2
1/4 do 1/4th of 1/2

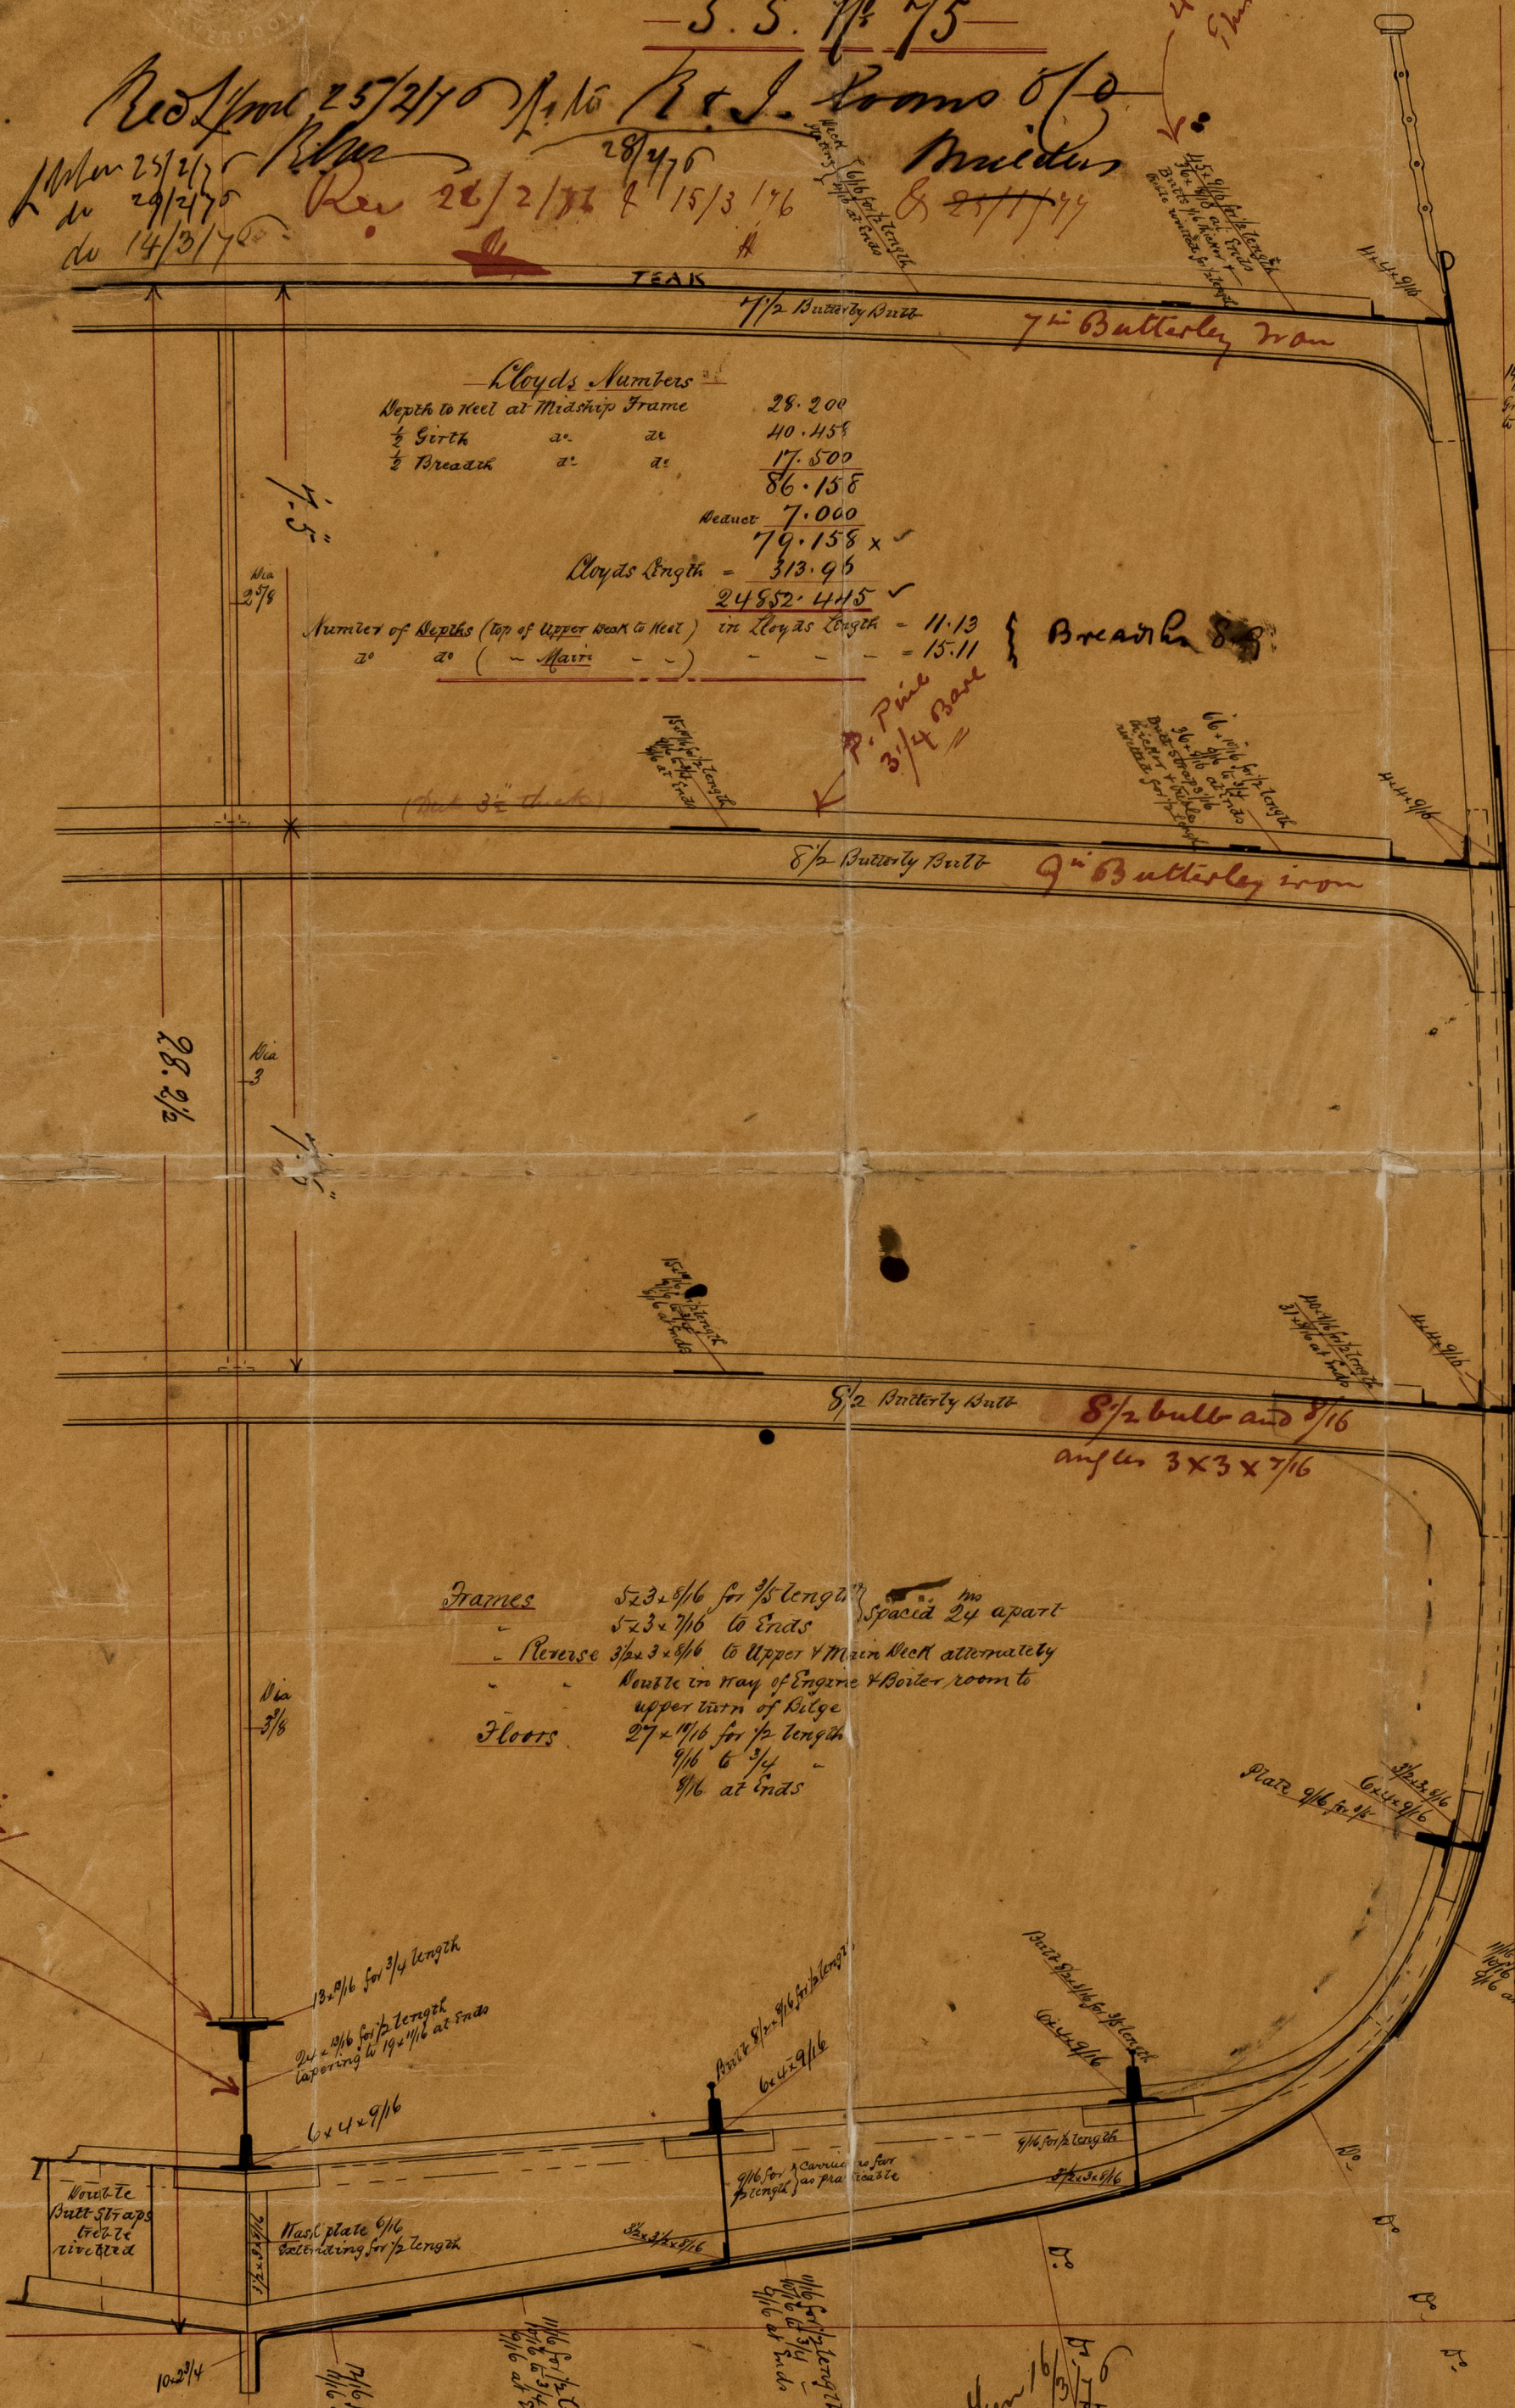
Frames

$5 \times 3 \times \frac{5}{16}$ for $\frac{1}{2}$ length } $\frac{1}{2}$ in mo
 $5 \times 3 \times \frac{7}{16}$ to ends } Spaced 24 apart

Reverse $3\frac{1}{2} \times 3 \times \frac{5}{16}$ to Upper & Main Deck alternately
Nourish in way of Engine & Porter room to

Floors

27 x 10/16 for 1/2 length
9/16 to 3/4 -
8/16 at ends

$$\begin{array}{r} 13 \times 15 \\ \hline 195 \end{array}$$


RON 519-0148

— Scale $\frac{1}{2}$ inch = 1 foot

1822
15/3/6

Lloyd's Register
Foundation