



S Steamer No 84
 Scale $\frac{1}{2}$ inch = 1 foot
 Rec 5/6/76

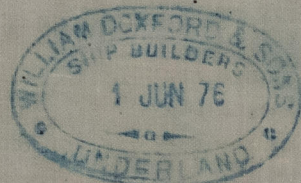

8/6/76


After Tank

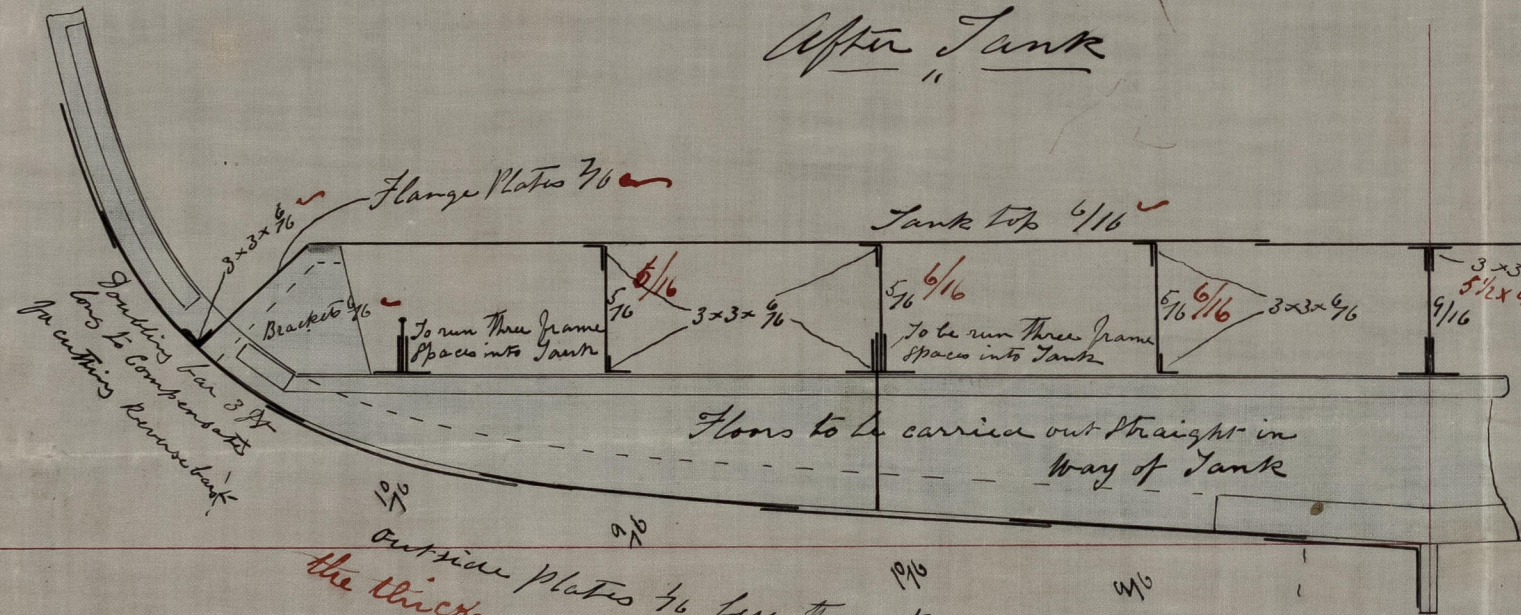

Outside plates to be less than Rule in way of Tank
 the thicker plates to overlap the tanks.

S.S. Commonwealth
 Report No 11582

Fore Tank

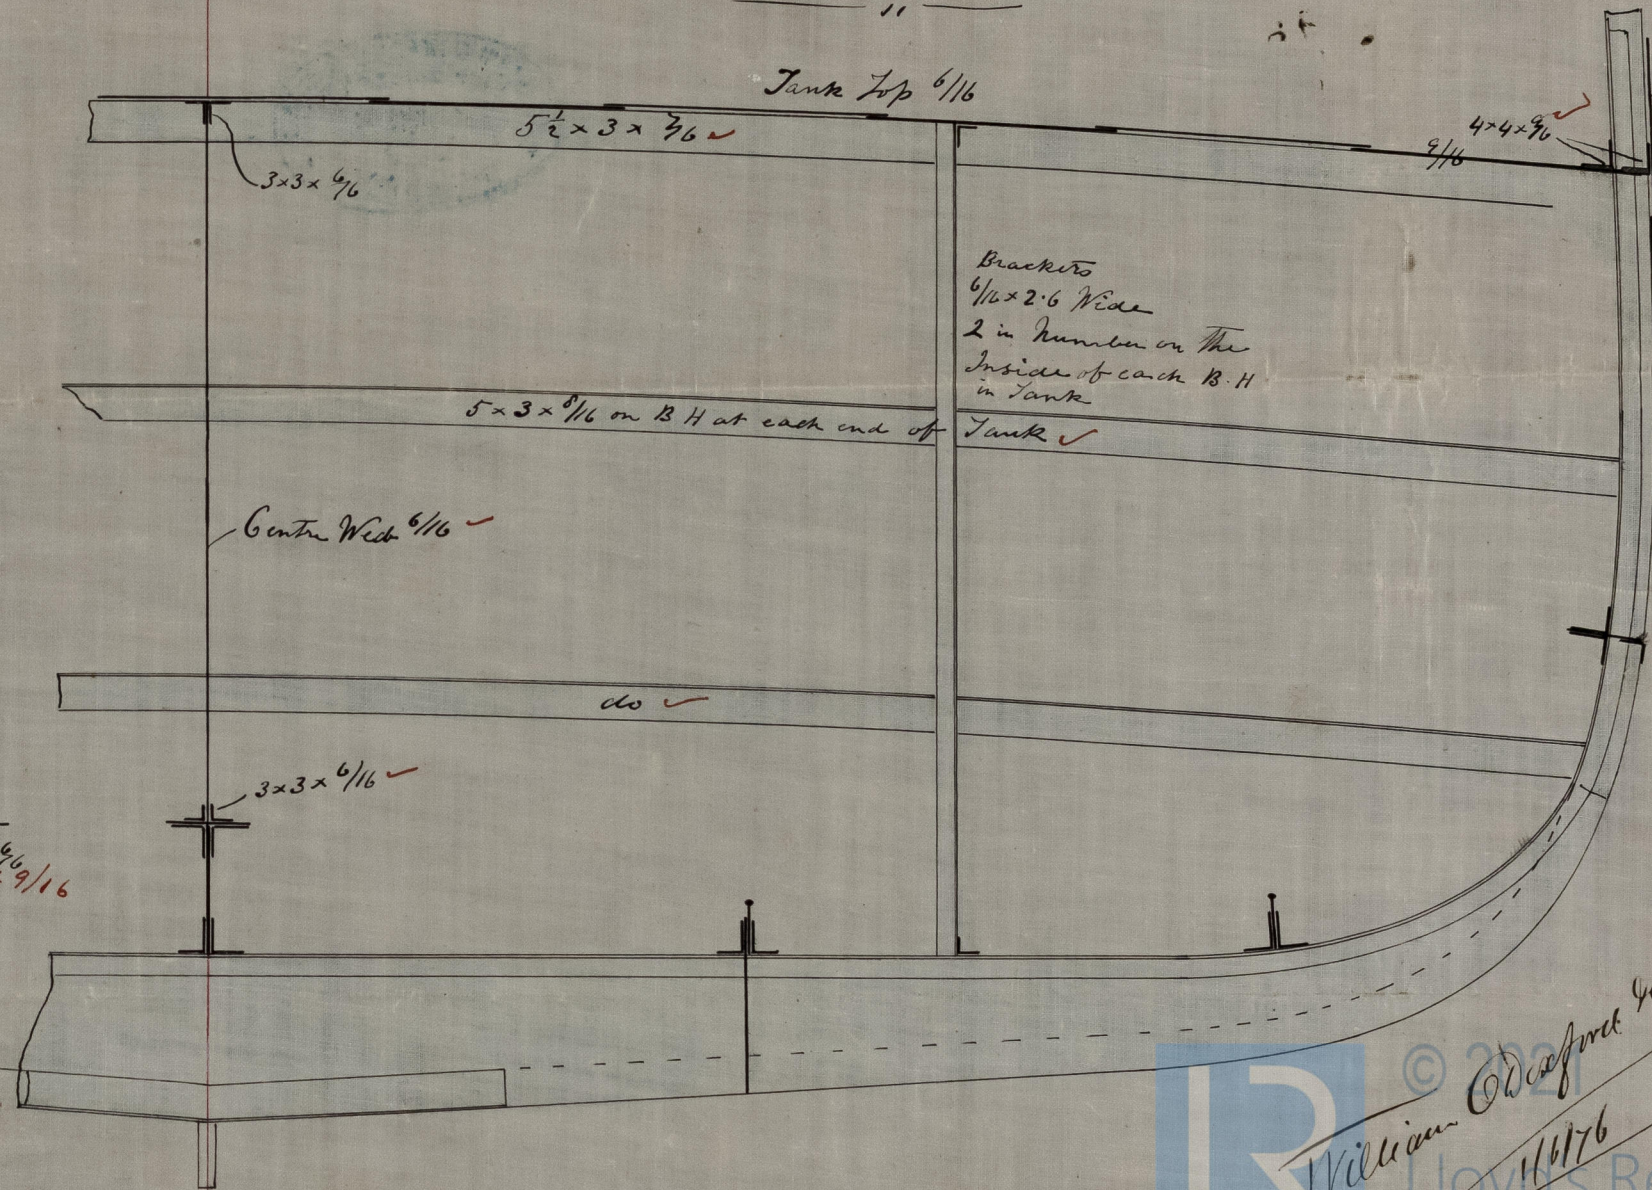

IRON 519-0157