


S.S. "Commonwealth"

Report No. 11582

S. N<sup>o</sup>. 84

Sketch showing disposition  
and size of hold beams.

116-1 foot

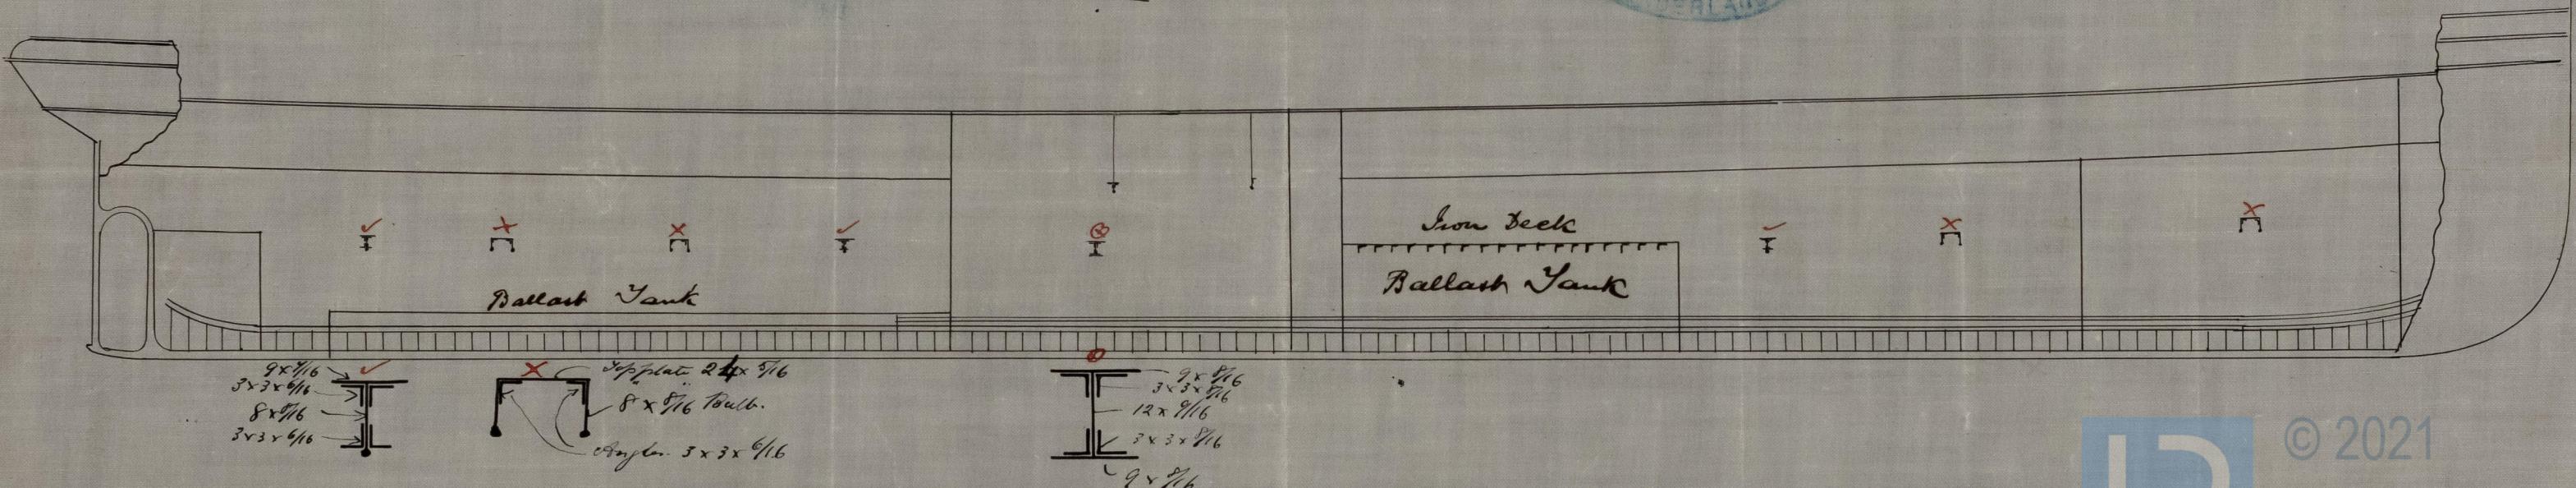

© 2021


Lloyd's Register  
Foundation

1R005P-0159

"Commonwealth"

11285 2/2/1906 P

IRON 519-0159

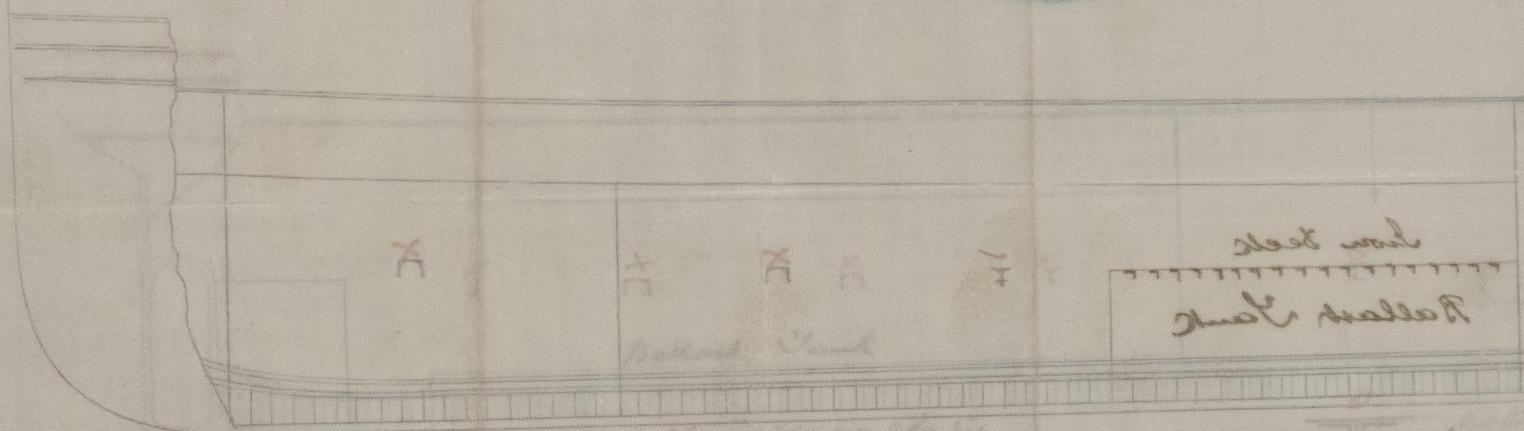

© 2021



Lloyd's Register  
Foundation