

86776

2 Bawen	30	Cot	✓
1 do	25 $\frac{1}{2}$	"	✓
1 Stream	12	"	✓
1 Hedge	6	"	✓
1 do	3	"	✓
240 Sallows	1 $\frac{1}{2}$	Cable	✓


Length	280.0
Ext Breadth	34.0
Depth in hold	24.0

3 Decked. Class 100 Sloysds.
(Rules 1845. 6.)

Rec. 5/6/76 & 26/11/77

Length 249.0
 1/2 N. Breadth 16.91
 Depth tip of keel 26.16
 1/2 girth 39.45
82.52
7.5
45.52 1st No
249.0
689.68
52864
15104
2106.08 = 2nd No

Proportions.
under 11 depths to upper deck. ✓
" 15 " " Middle " ✓
" 8½ Breadths. ✓

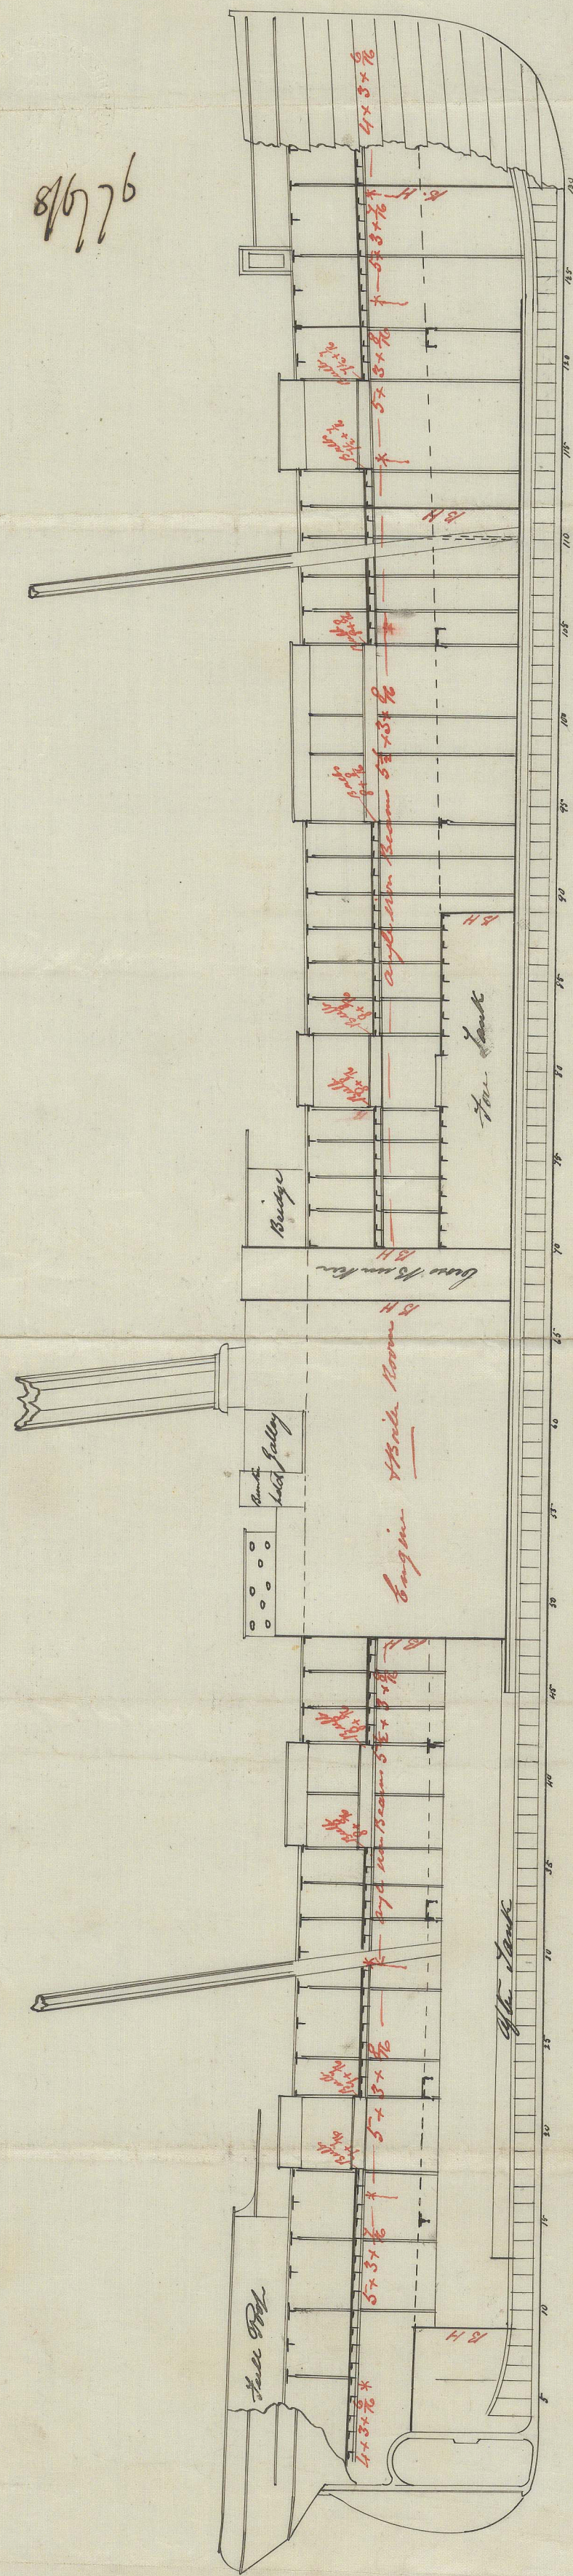

Elevation. W. 84 S. S.
Scale to inch = 1 foot

[illegible]