


207

BARQUE LURLINE

Rev 26/8 176

Glasgow Report. No. 4393

SCALE $\frac{1}{8}$ INCH TO FOOT

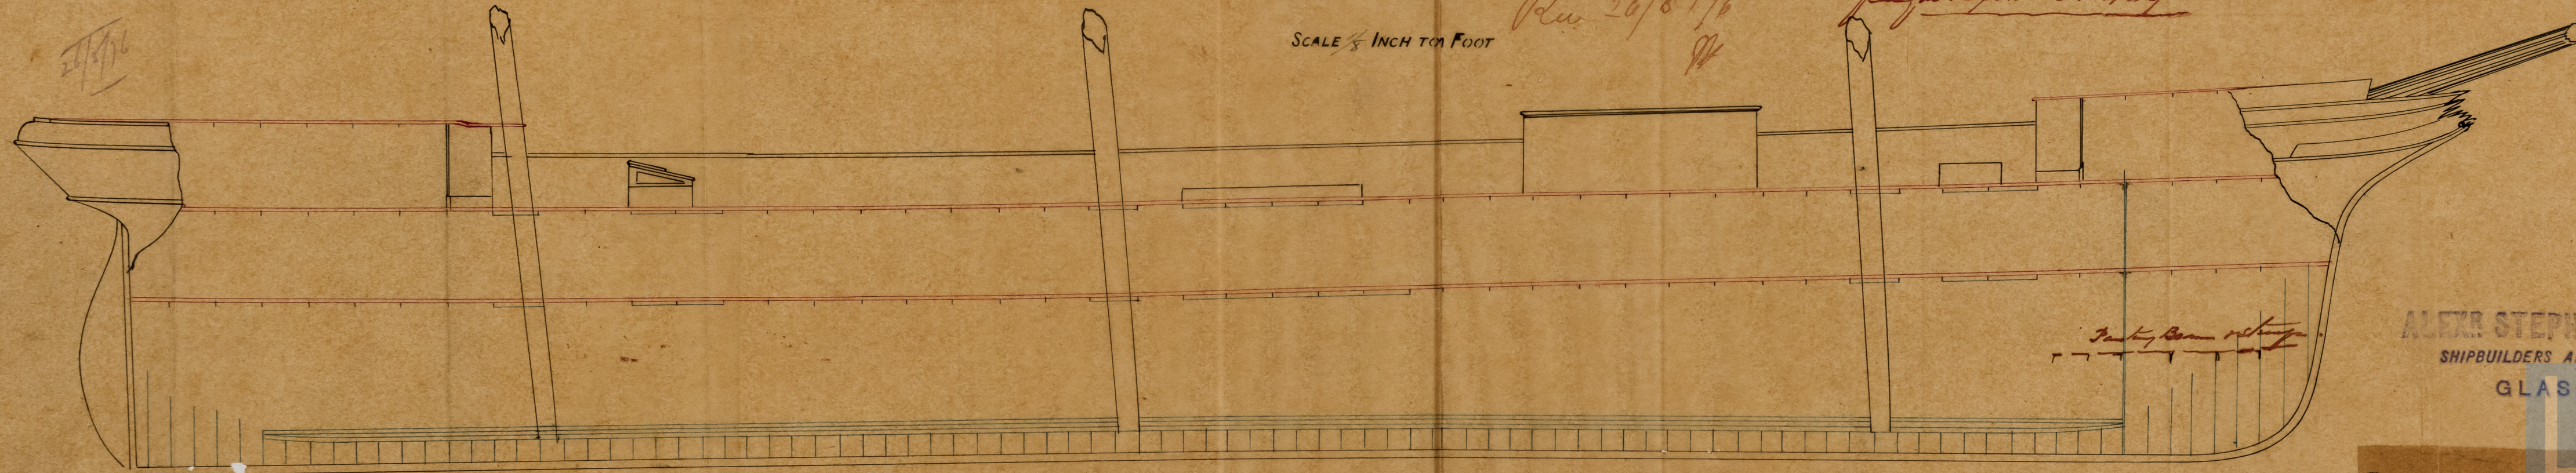

IRON 519-0165

ALEX. STEPHEN & SONS,
SHIPBUILDERS AND ENGINEERS,
GLASGOW. © 20

© 202
GOW. DRAWING No.

ING No. 611
Ex. 22/8/76

611
En. 22/8/16 *manu*