
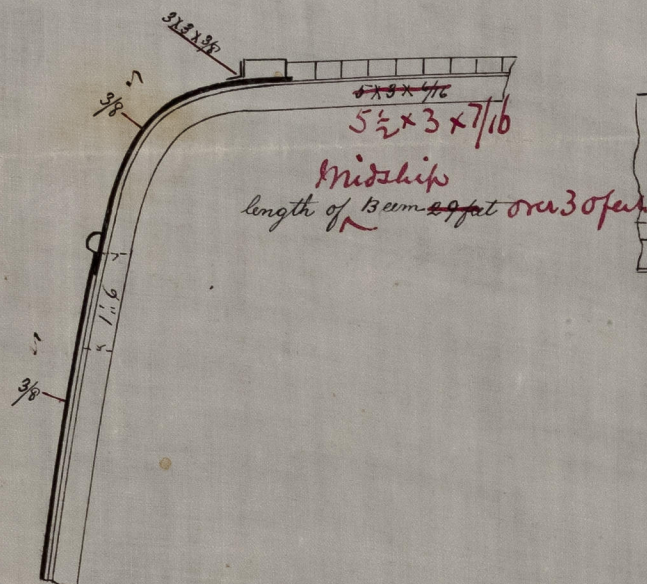


Dec 4-12-75
TJ


Rec 8/12/72



9/12/75



Length (as per rule)	218" 6
Breadth moulded	34" 8
Depth from top of keel to upper Deck beams	23" 9
Girth of half Midship Section (as per rule)	35" 11 3/4
R ^{es} to regulate Scantlings $74 \cdot 04 \div 16833, 24$	
Proportions Length over 9 Depths & over 6 Breadths	
Breadth Moulded	
Scale $3/8$ in = 1 Foot	

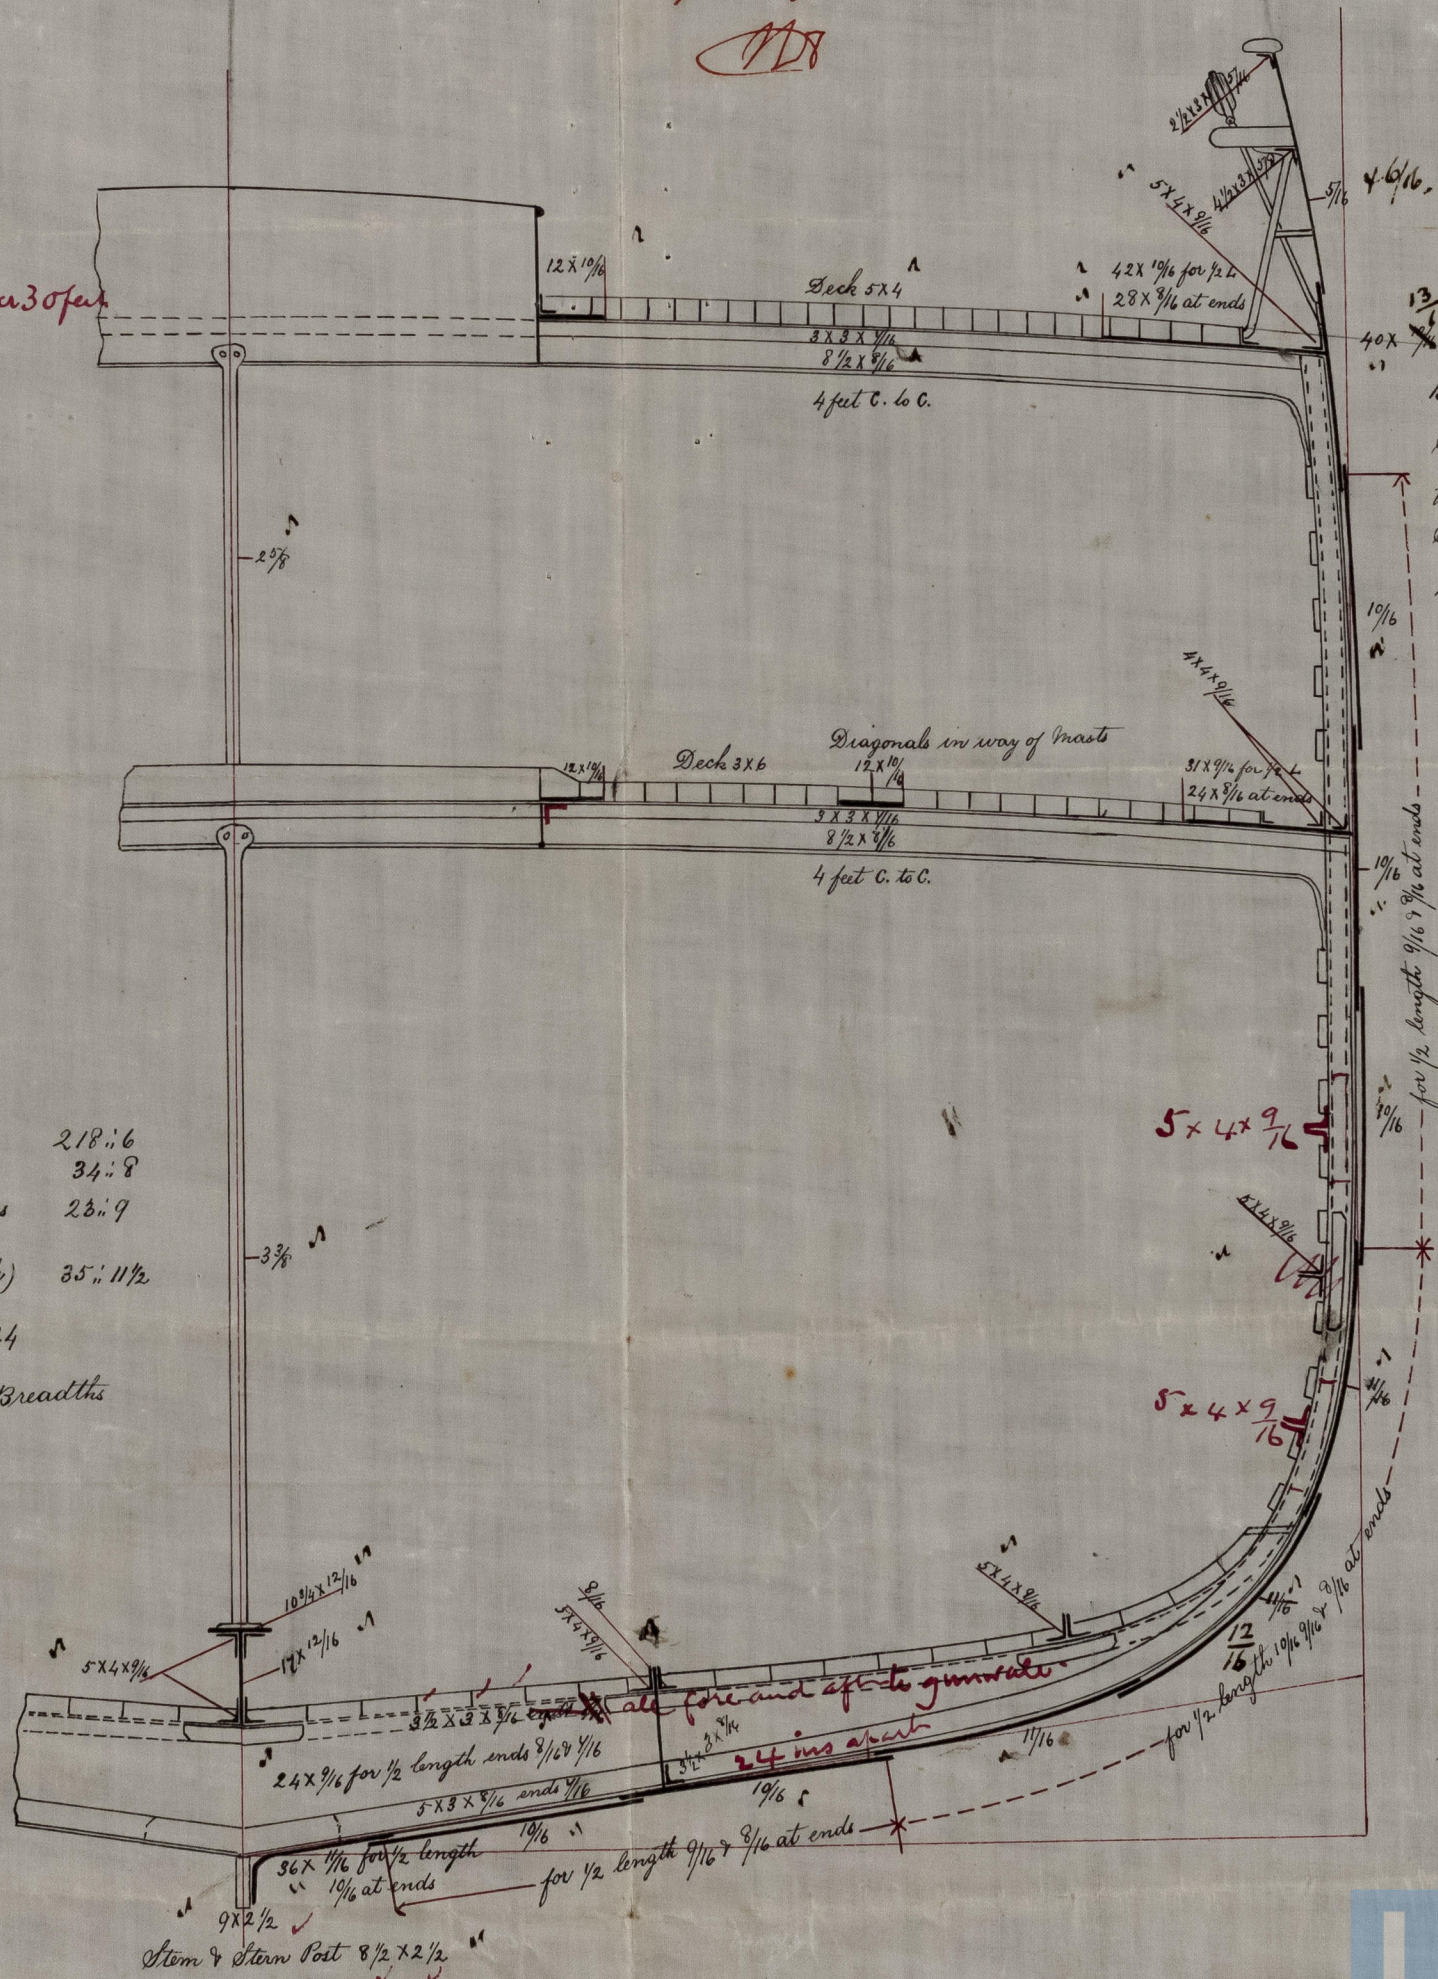

40X $\frac{13}{16}$ for $\frac{9}{16}$ length only $\frac{12}{16}$ $\frac{11}{16}$ $\frac{1}{8}$ $\frac{9}{16}$.

Butts of main stringer & sheer strake rabbled riveted for $\frac{1}{2}$ length Amidships
Straps $\frac{1}{16}$ thicker than the plates they connect

Butto of three Strakes
round ridge treble
riveted for $\frac{1}{2}$ length
amidships, Straps $\frac{1}{16}$
thicker than the plates
they connect

1R0N519-0175

© 2021
J.H.A.
9/12/75
18-10-76
17-2-77