

Length BP	165'0"
Beam extreme	25'0"
D ^o moulded	24'10"
Depth D ^o	14'5"
D ^o of hold to floors	13'11"
Rise of beam	8 1/2"


Class 90A.
Scale $\frac{1}{2}'' = 1 \text{ foot.}$

Rec 8/4/96

Section thro Engine & Boiler Room

Section the Hold.

Section thro' Quarter Deck

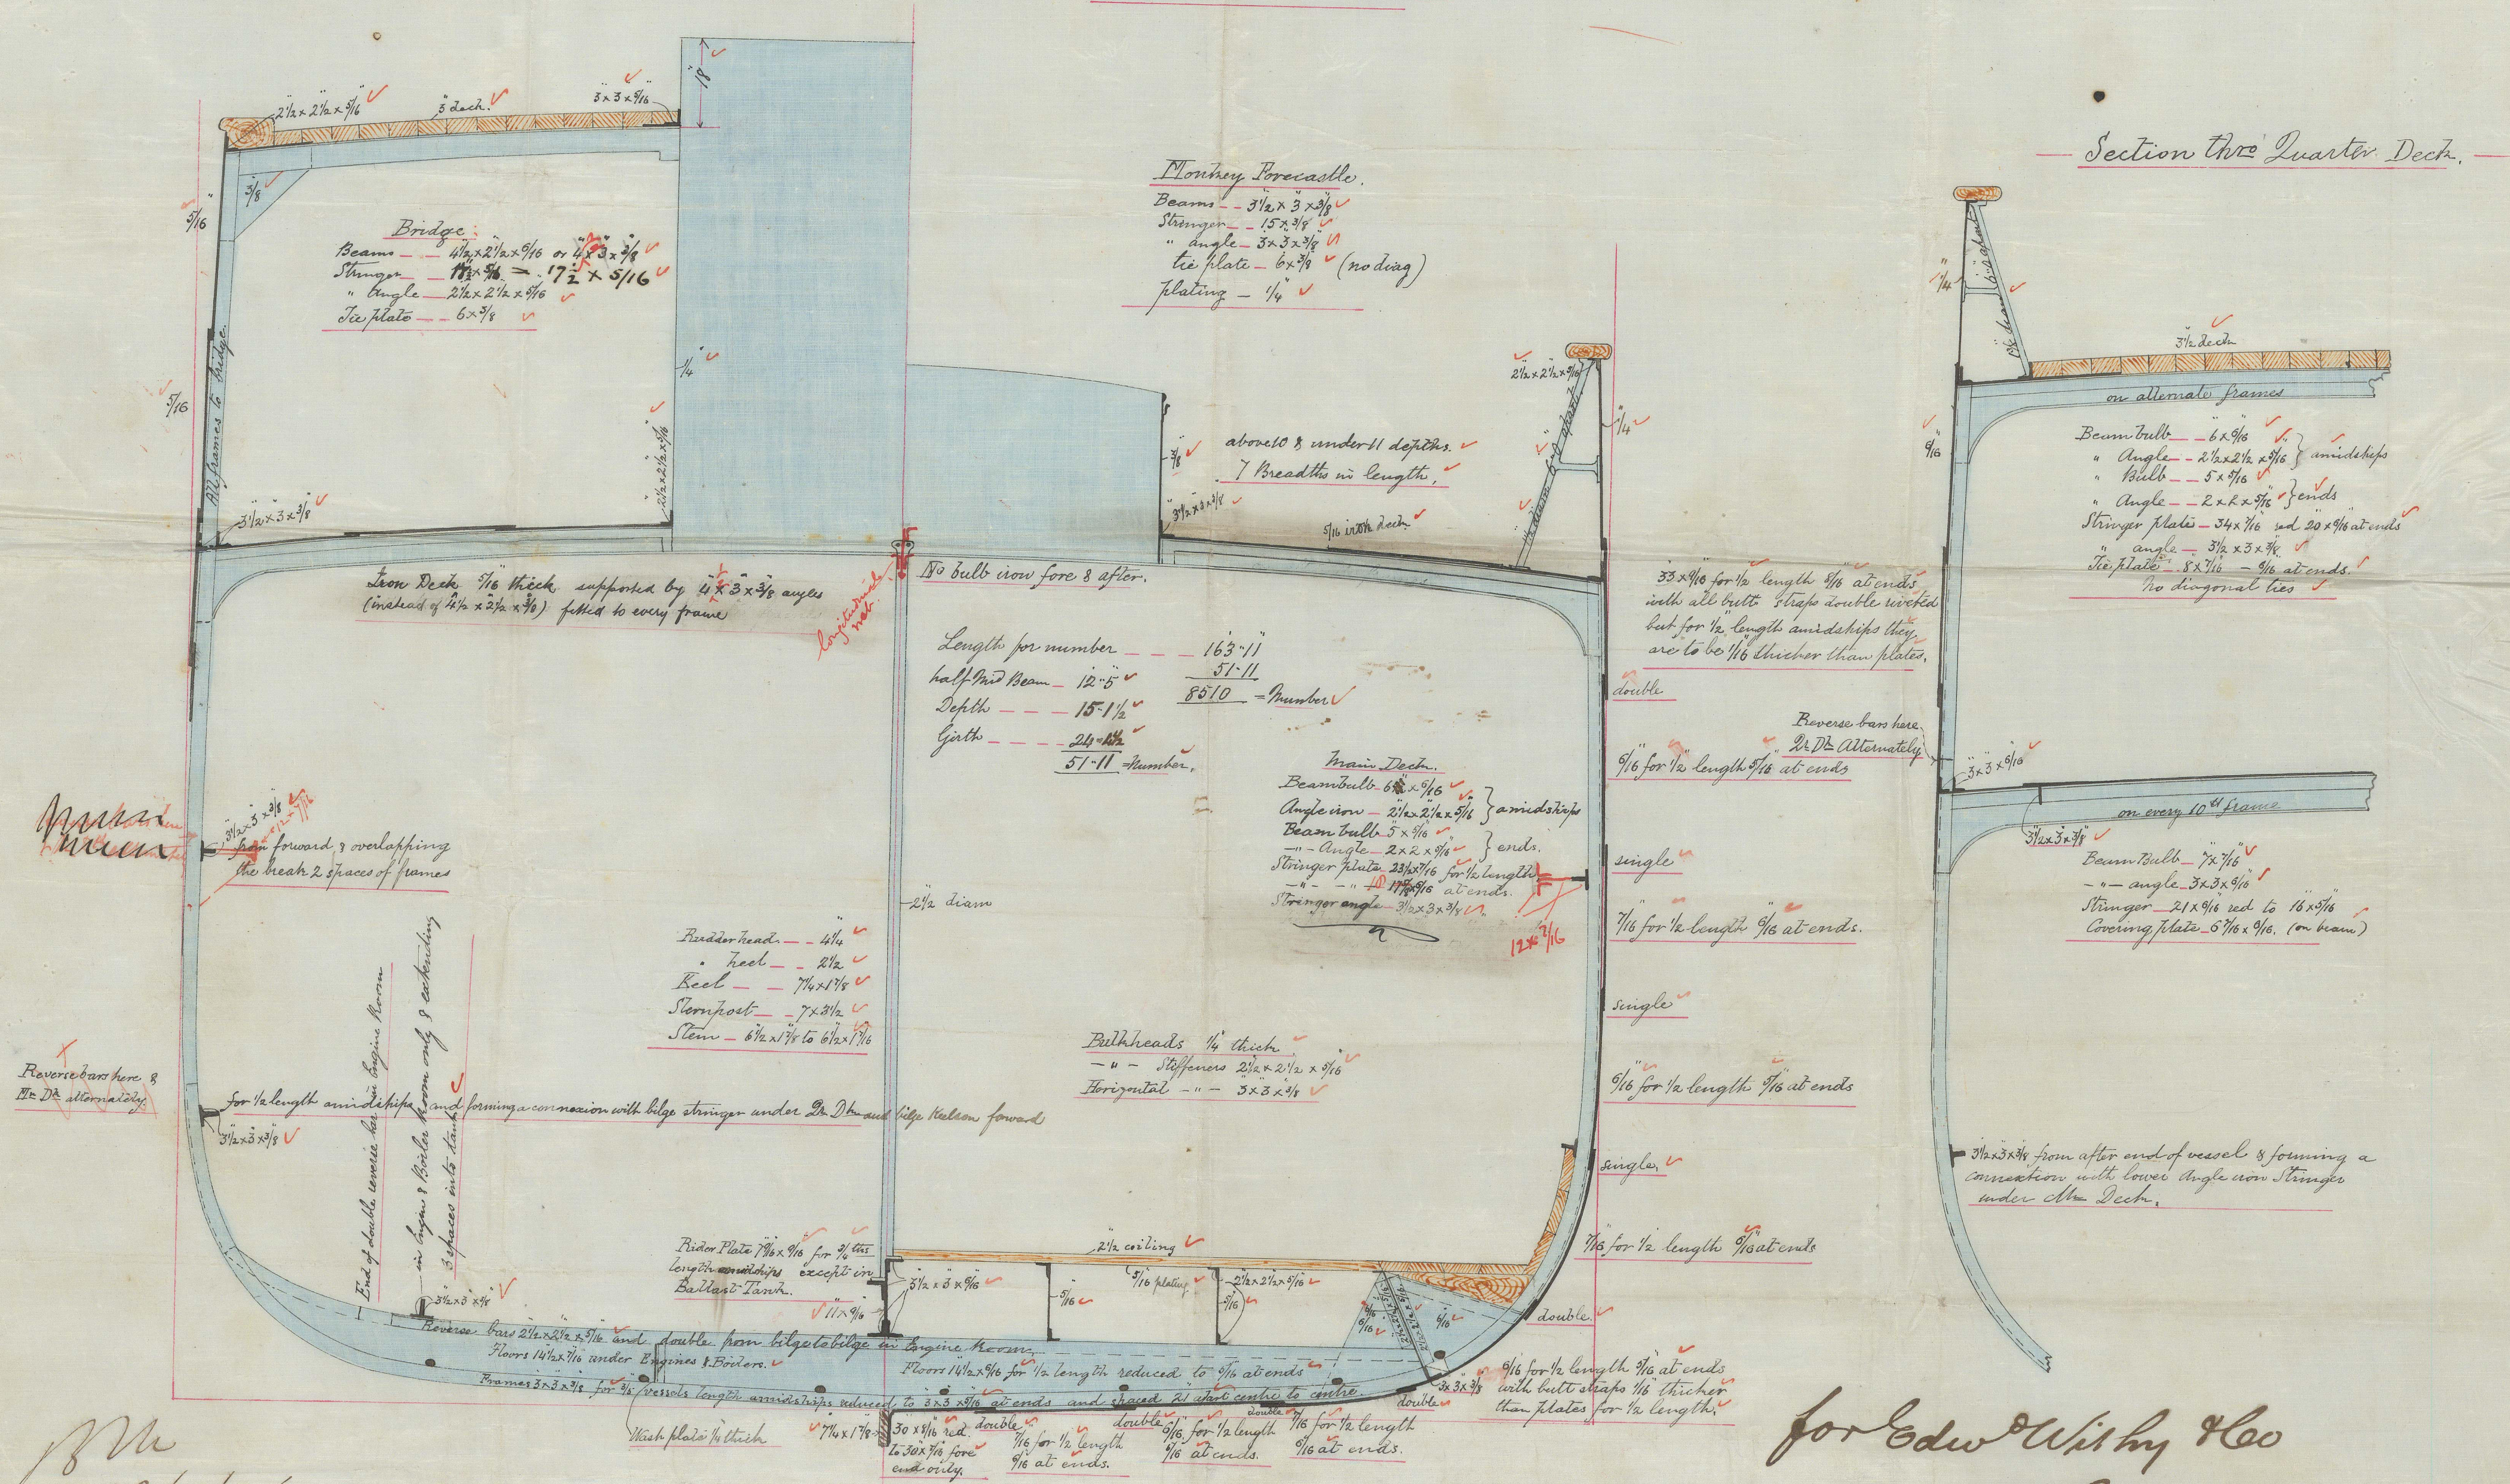

for Edw Whitney & Co
Geo. Cooper
— " —