



30/11/76

Midship Section No 14  
Scale 1/2" = One foot

Bk. "Gipsy Queen" of Glasgow  
Greenock Report

Rev 30/11/76 No 4062.

AS

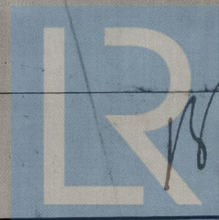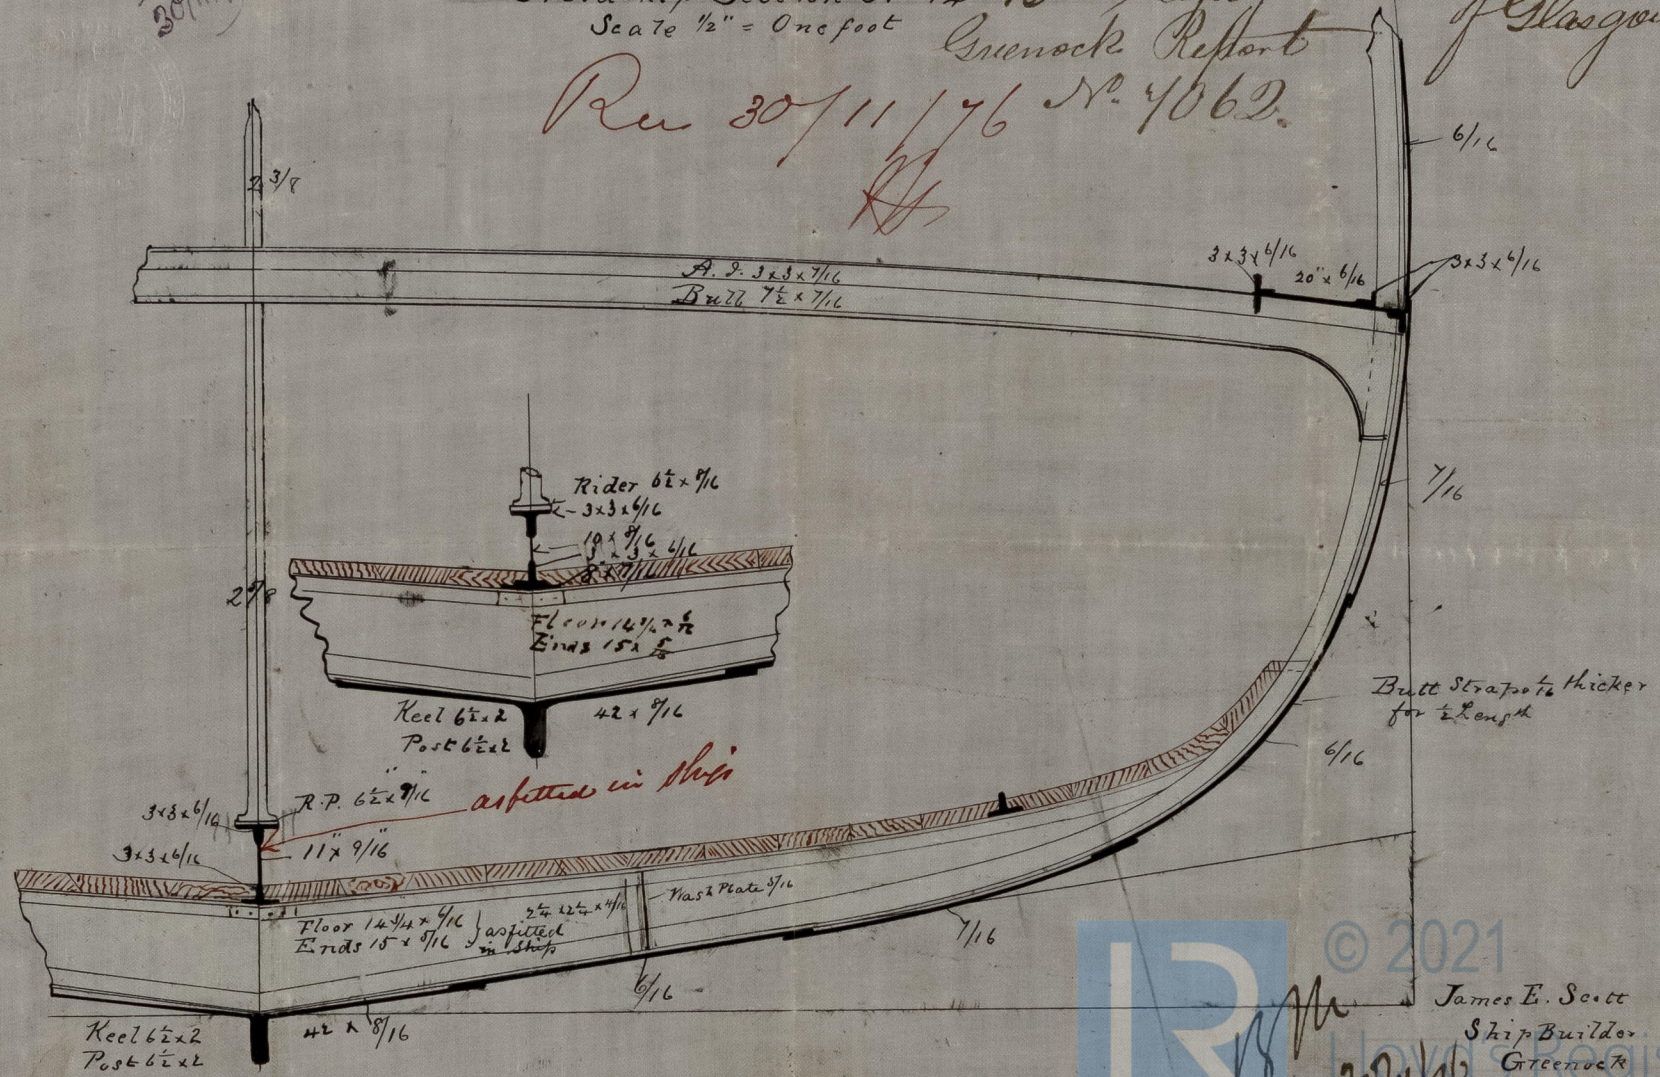

© 2021

James E. Scott  
Ship Builder  
Greenock

30/11/76

IRON 519-0184