14/11/76

B^kn "Gipsy Queen" of Glasgow
Greenock Report No. 4062

Midship Section New Vessel No. 14

Scale ½ = One foot

To Class 100 A at Lloyds

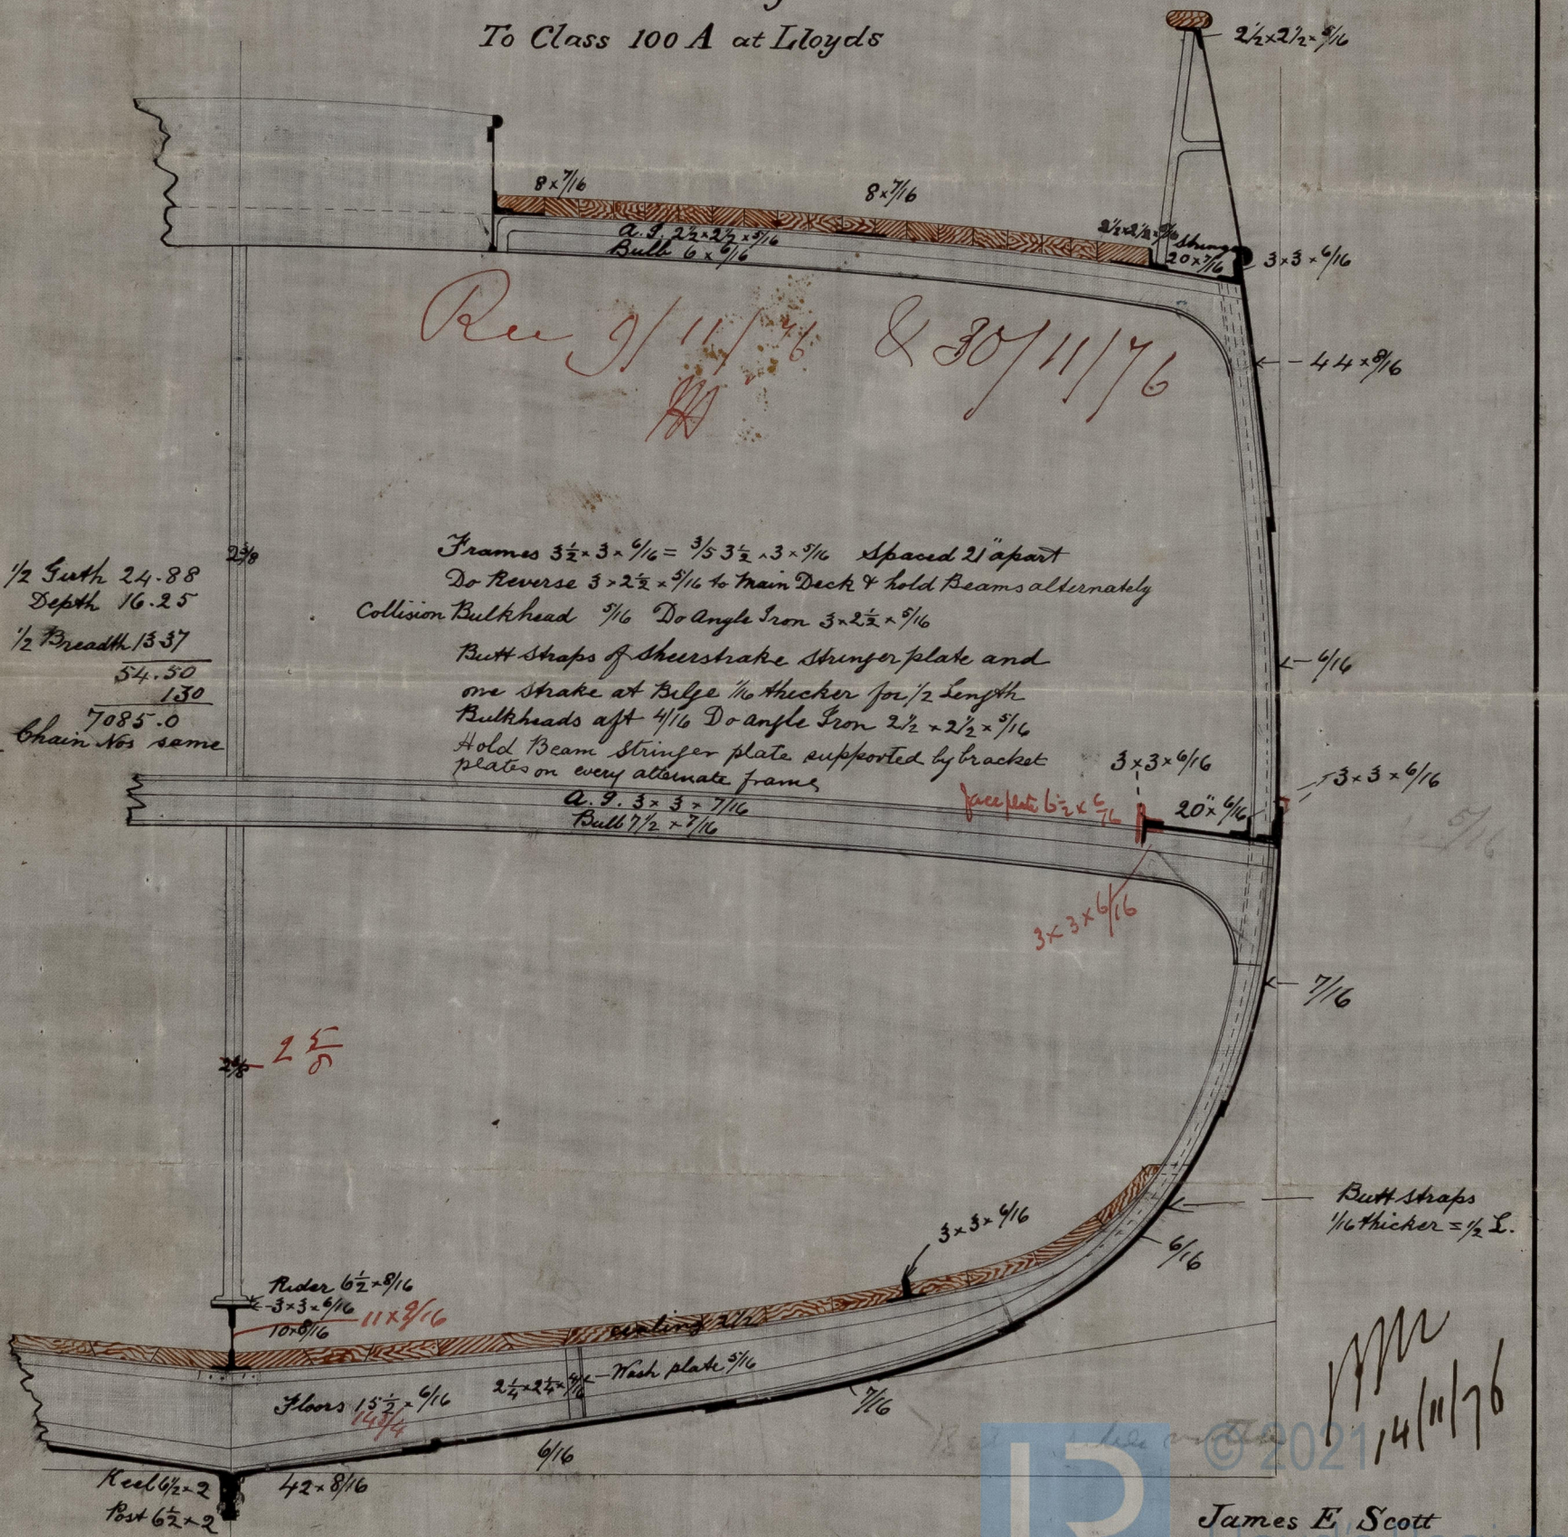

14/11/76

James E. Scott
Ship Builder
Greenock

© 2021 Lloyd's Register Foundation

IRON 519-0185