


14/11/76

B. R. "Gipsy Queen" of Glasgow  
Greenock Report N° 406 B.

Per 9/11/76

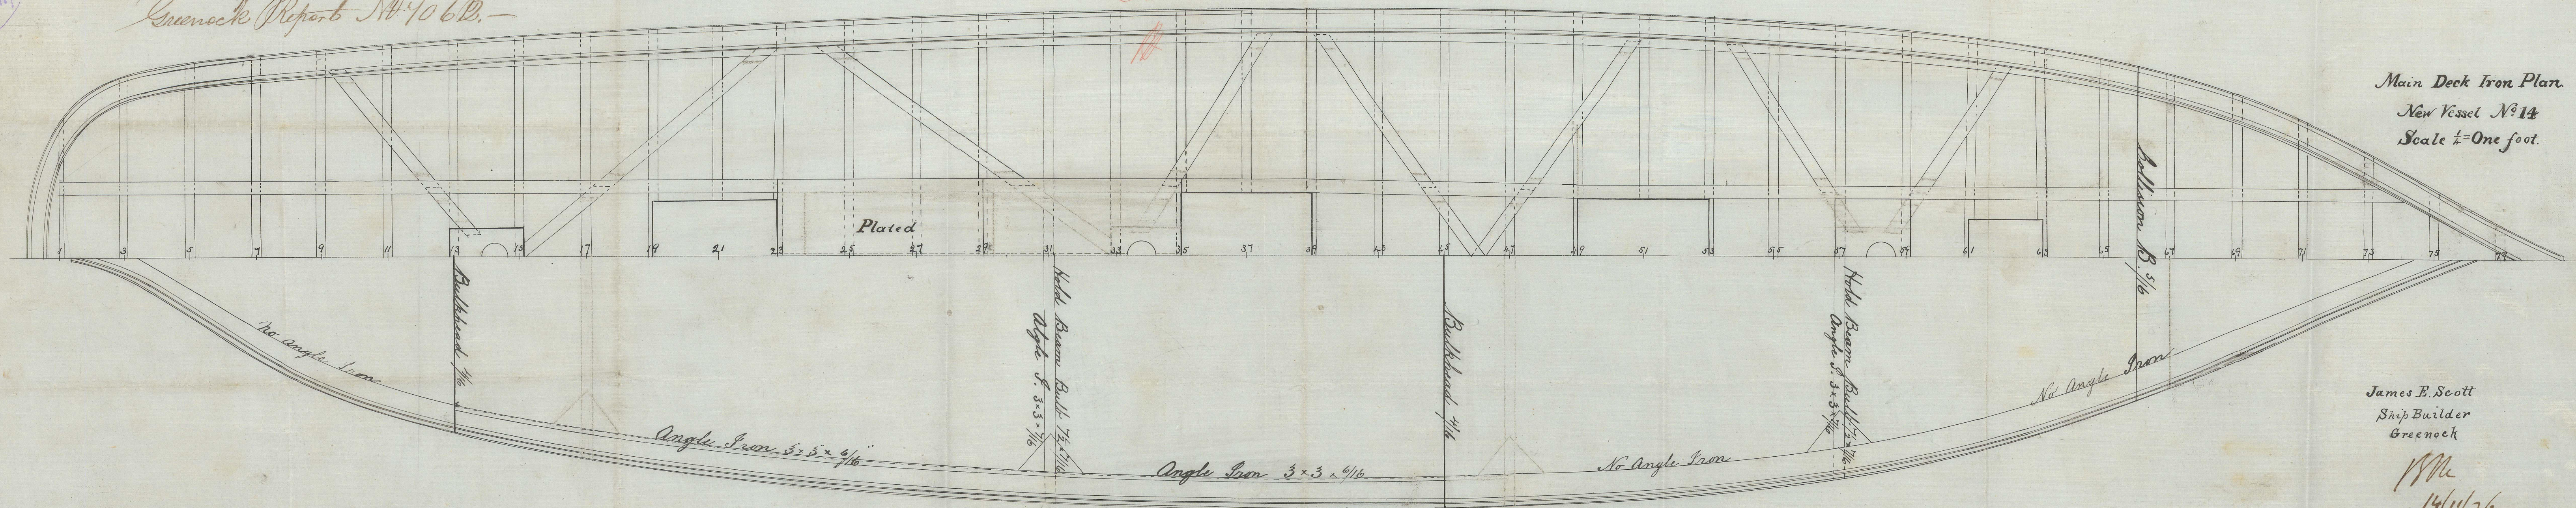

Main Deck Iron Plan.  
New Vessel N° 14  
Scale 1/4" = One foot.

James E. Scott  
Ship Builder  
Greenock

14/11/76

IRON 519-0186

© 2021

Lloyd's Register  
Foundation