


14/11/76

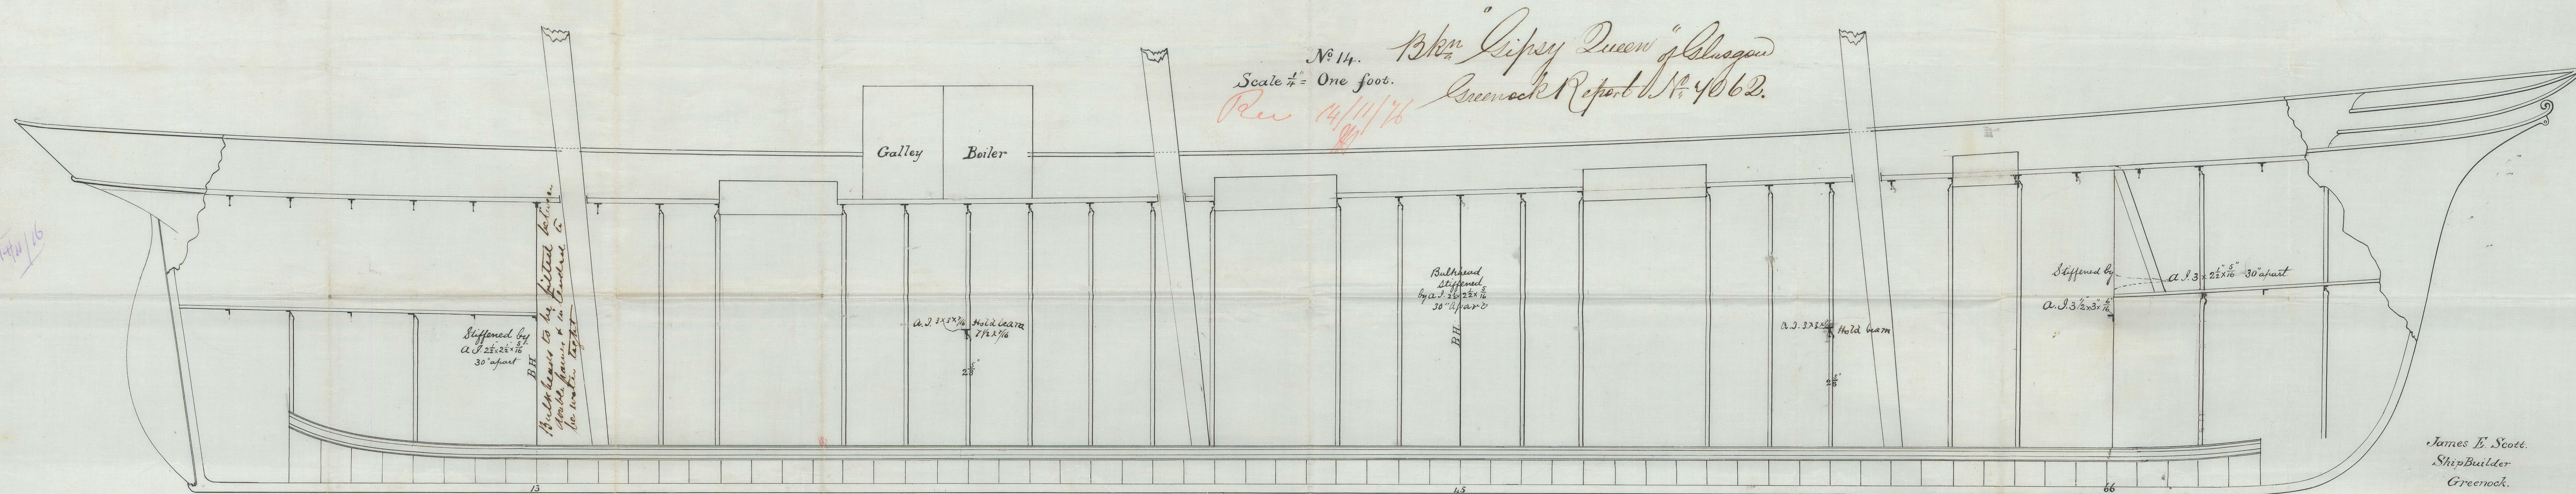

No 14.
Scale $\frac{1}{4}$ " = One foot.
Rev 14/11/76
"Gipsy Queen" Glasgow
Greenock Report No 4062.

James E. Scott.
Ship Builder
Greenock.

14/11/76

1200519-0184