

10/10/10


## Dimensions

$\frac{1}{2}$  Breadth ——— 19.  $1\frac{1}{2}$  Length 225.0  
Depth ——— 25.  $6\frac{1}{2}$  1.6  
Girth ——— 38.6 223.6

Breadths in Length — 5 & under 6 v  
 Depths in do — 8 & " 9 v

Class  
100 A at Lloyds


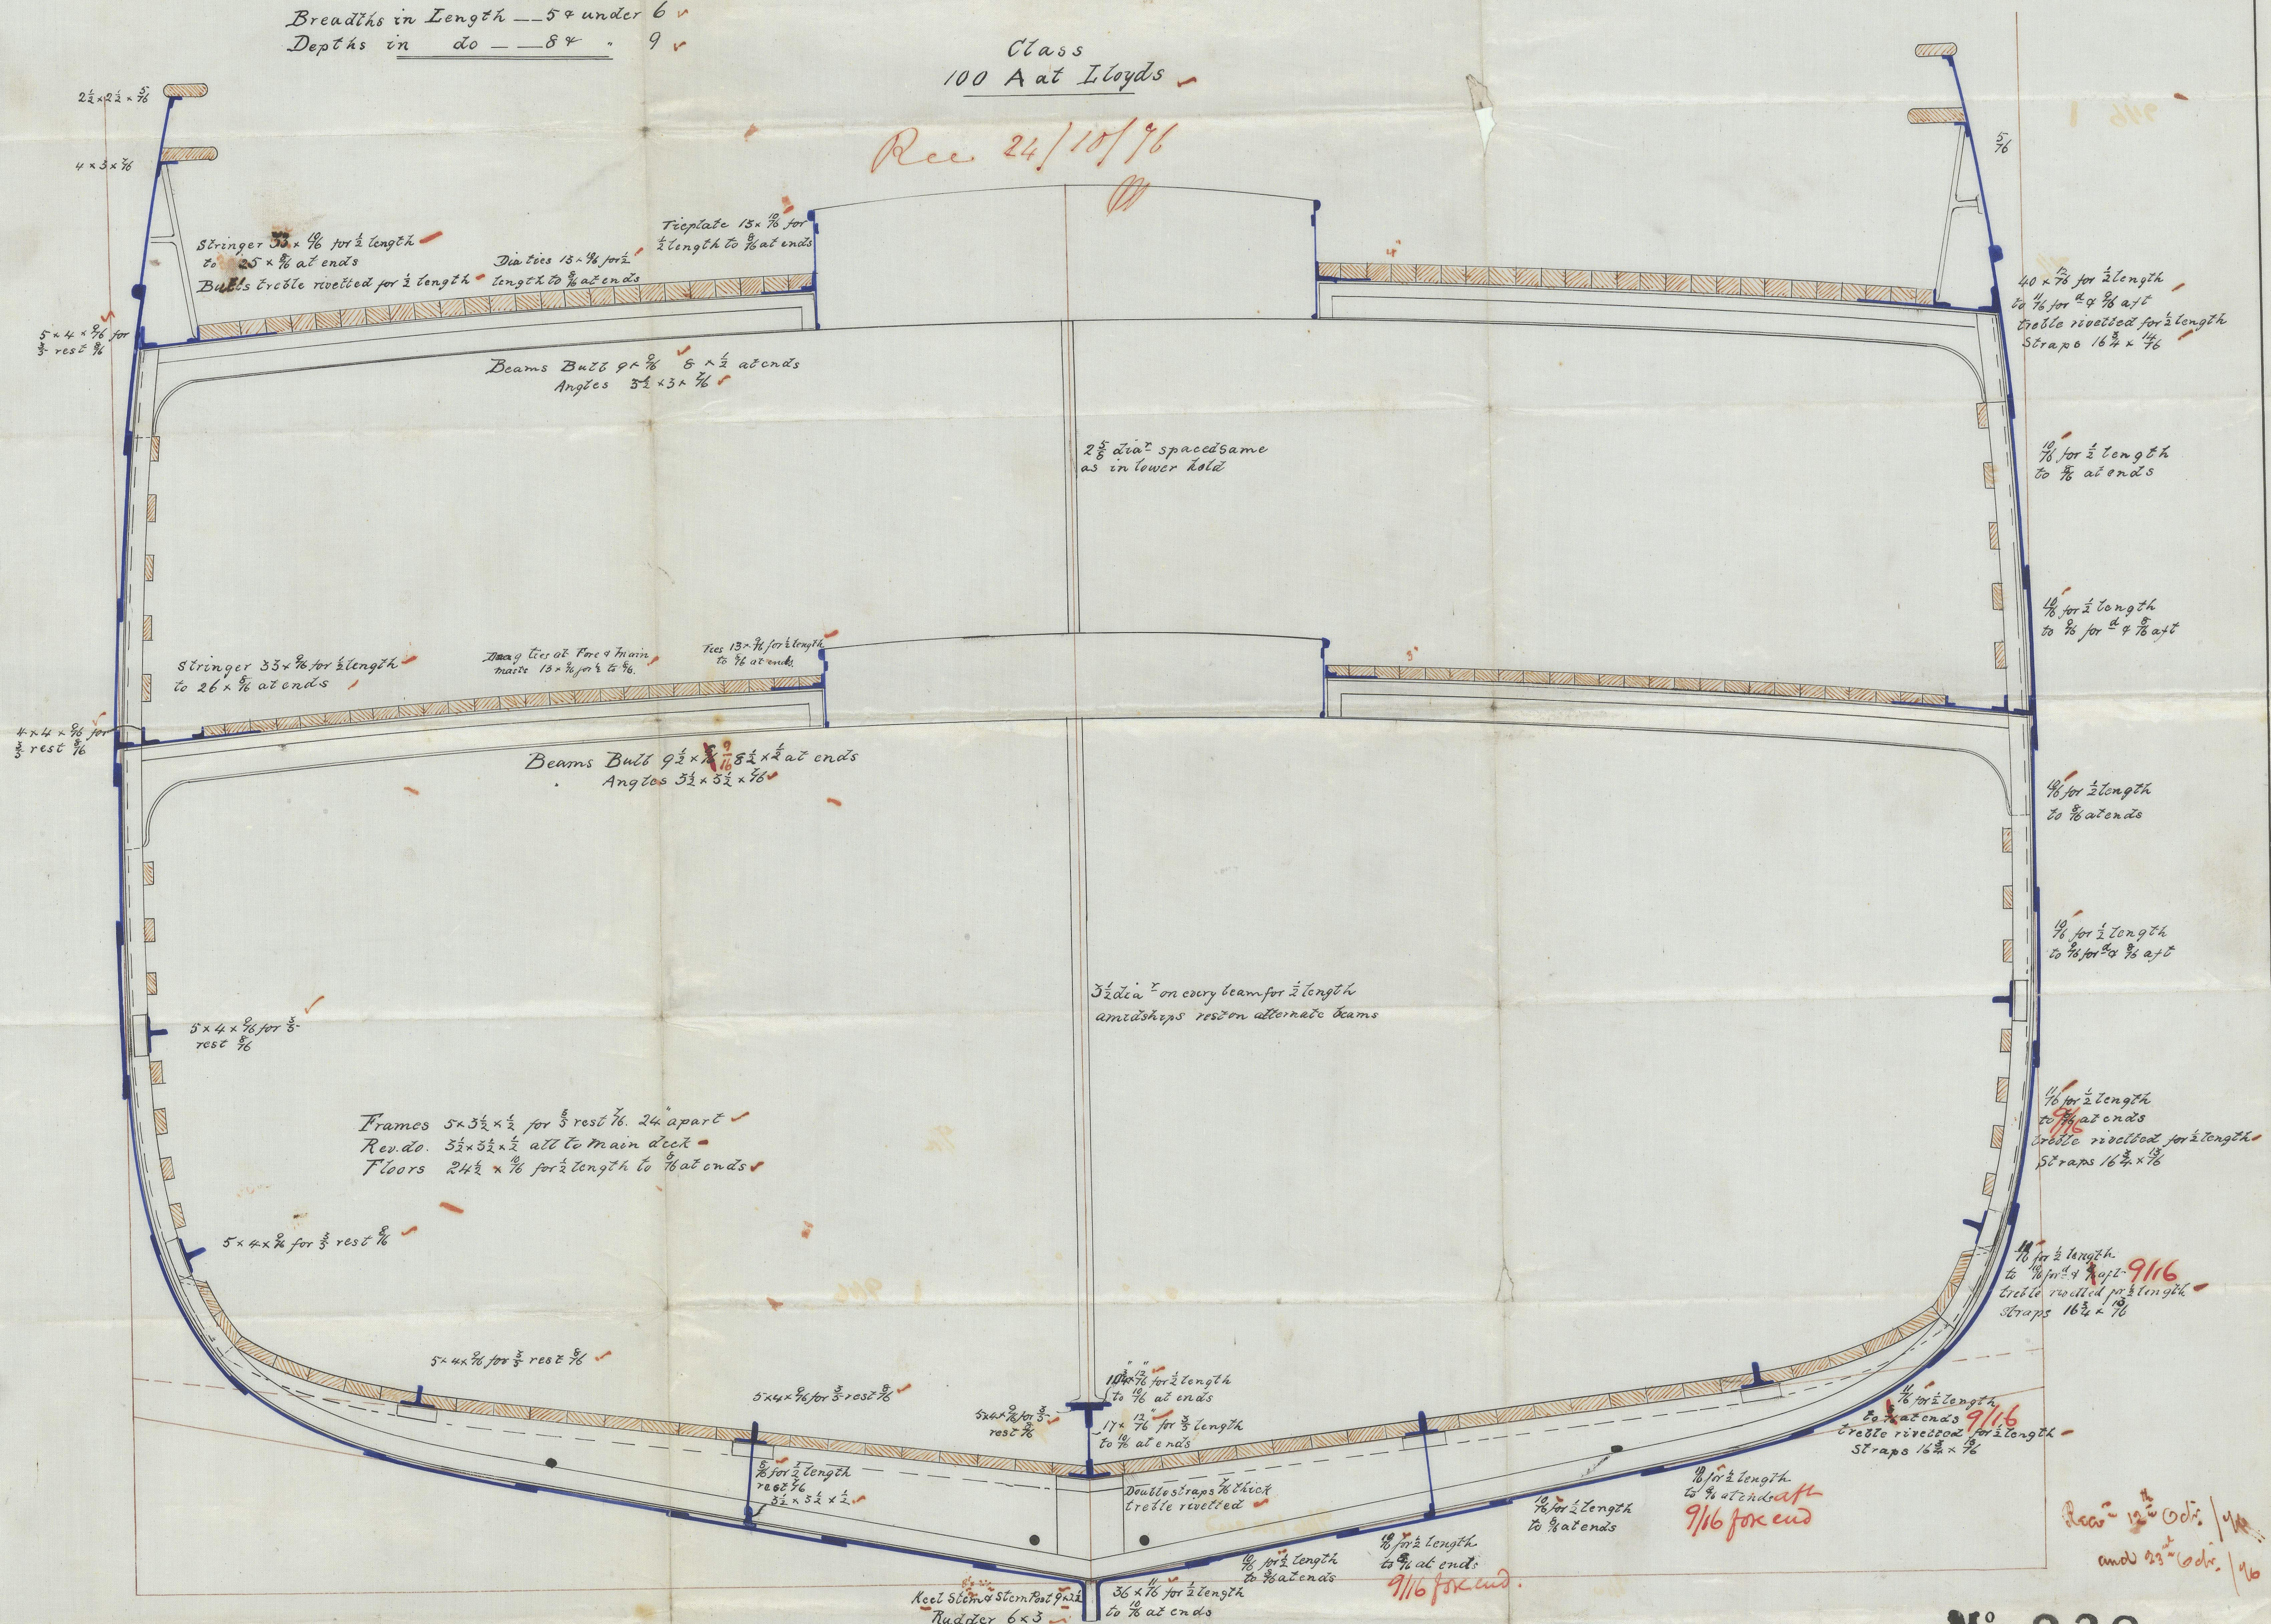

N<sup>o</sup> 230

STOCKTON-CN-TEES.© 2021

Oct 9<sup>th</sup> - 1846

Lloyd's Register  
Foundation

IRONSD-0034