

**Nº 32**


Half Breadth 18-6  
Depth 24-9

✓  $\frac{24-9}{81-10} \times \text{Length per Rule } 214 = 17\frac{1}{2}$

W. B. 16/2/76.

13.3.77.


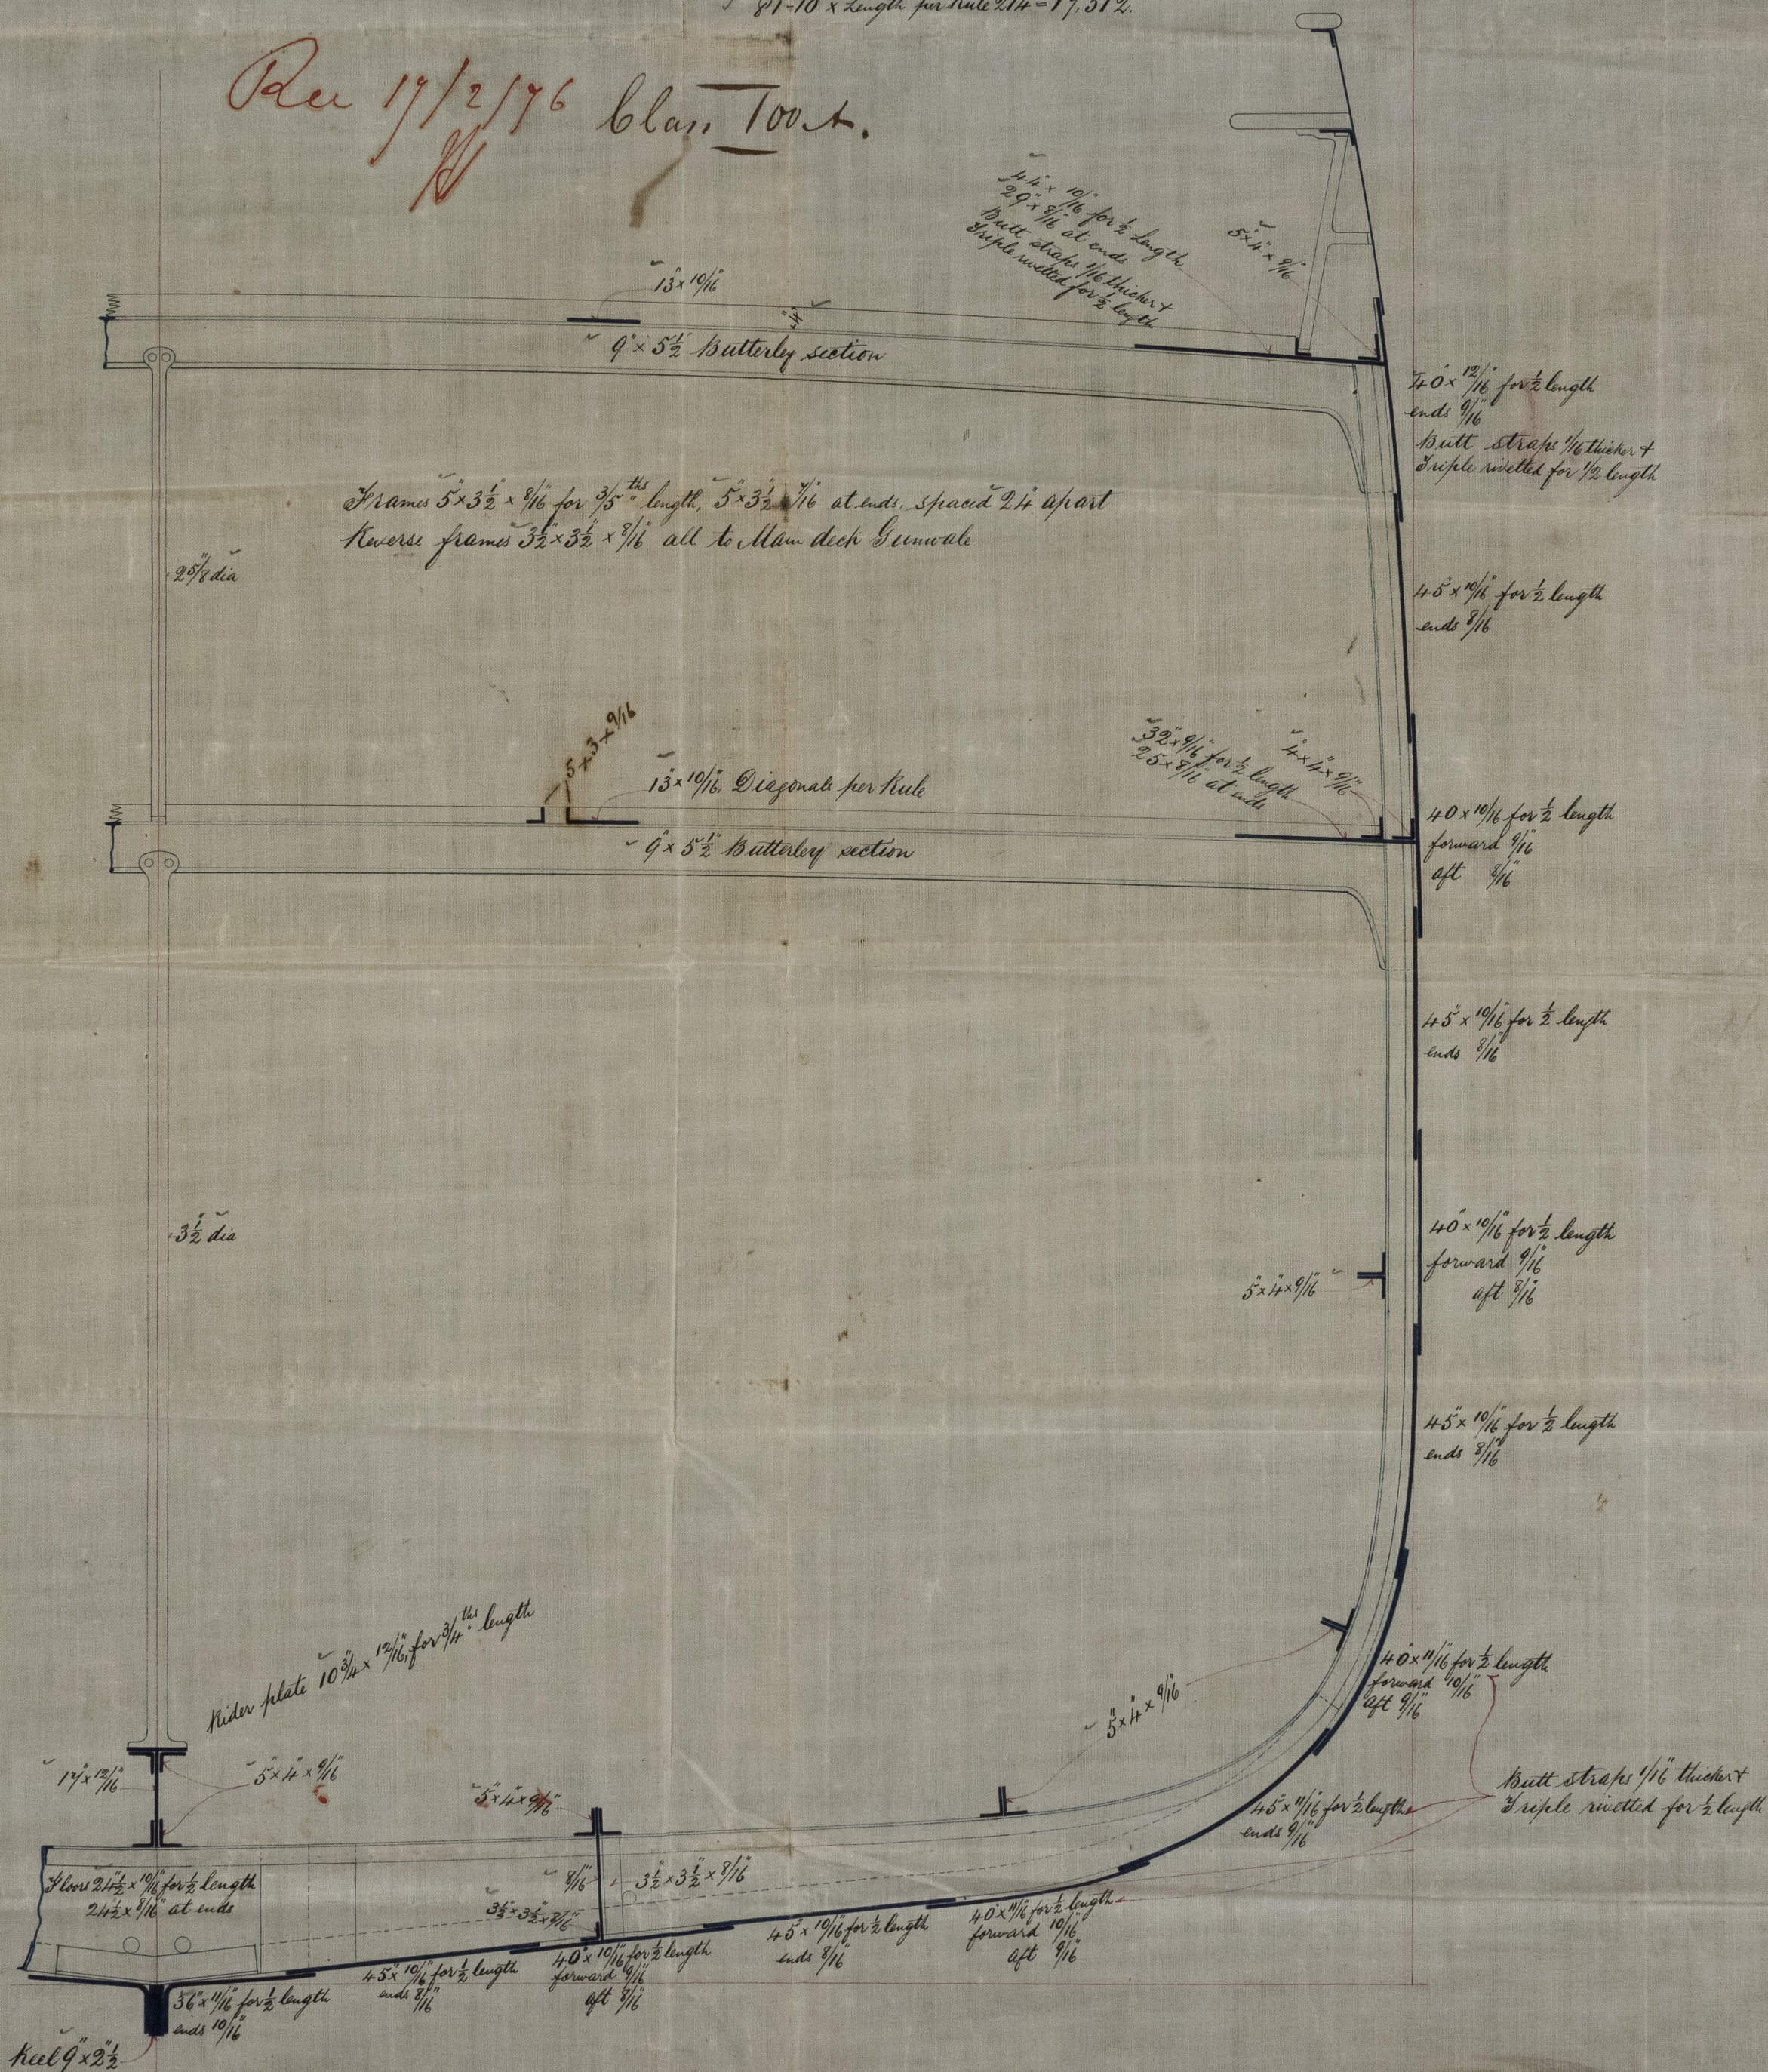

18/276