



SS N° 80.

SCALE  $\frac{1}{4}$  IN = 1 FOOT.

Rec 30/9/76

Sept: 28<sup>th</sup> 1876

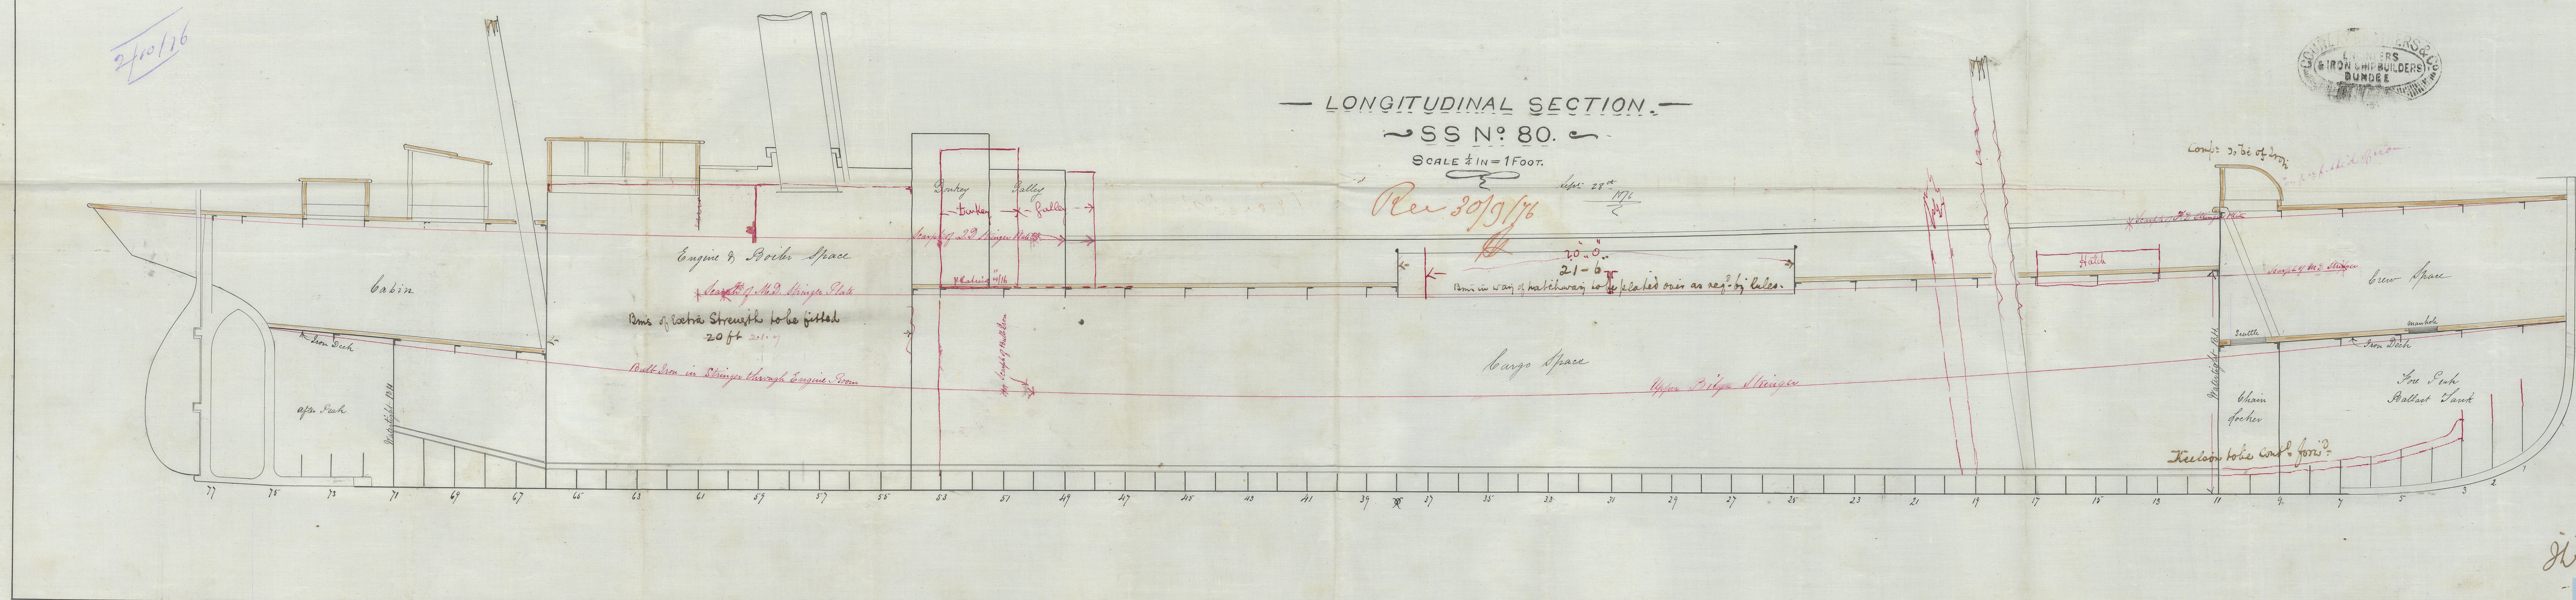

21-23-77

1R0X520-0056