

1/2 Girth 33.6

$\frac{1}{2}$ Breadths 16.65

Depth 22.25

42.50 $\frac{1}{2}$ = Numerical

200.25

36250
4500

1450000

14518.1250 2nd Annual

Dimensions 201' 6" x 33' 6" x 20' 2" hold.

do per rules $200.25 \times 33.3 \times 22.25$

SCALE $\frac{1}{4}$ INCH TO A FOOT

The Butt Straps of Main Deck Stringers plates skew strakes and three Gidge Strakes for half long the connections to be $\frac{1}{16}$ thickened from the plates they connect and bevel rivetted the Butts of centre Keelson Strapped and bevel rivetted per Rules


Thickness of B.H.^d Plates $\frac{1}{16}$ & $\frac{5}{16}$

Size of Stern & Sternpost $7\frac{1}{2} \times 2\frac{3}{8}$

Length of poop: 36 ft.

Length of S. G. Forecastle $3\frac{1}{4}$ W

Rec 19/10/26

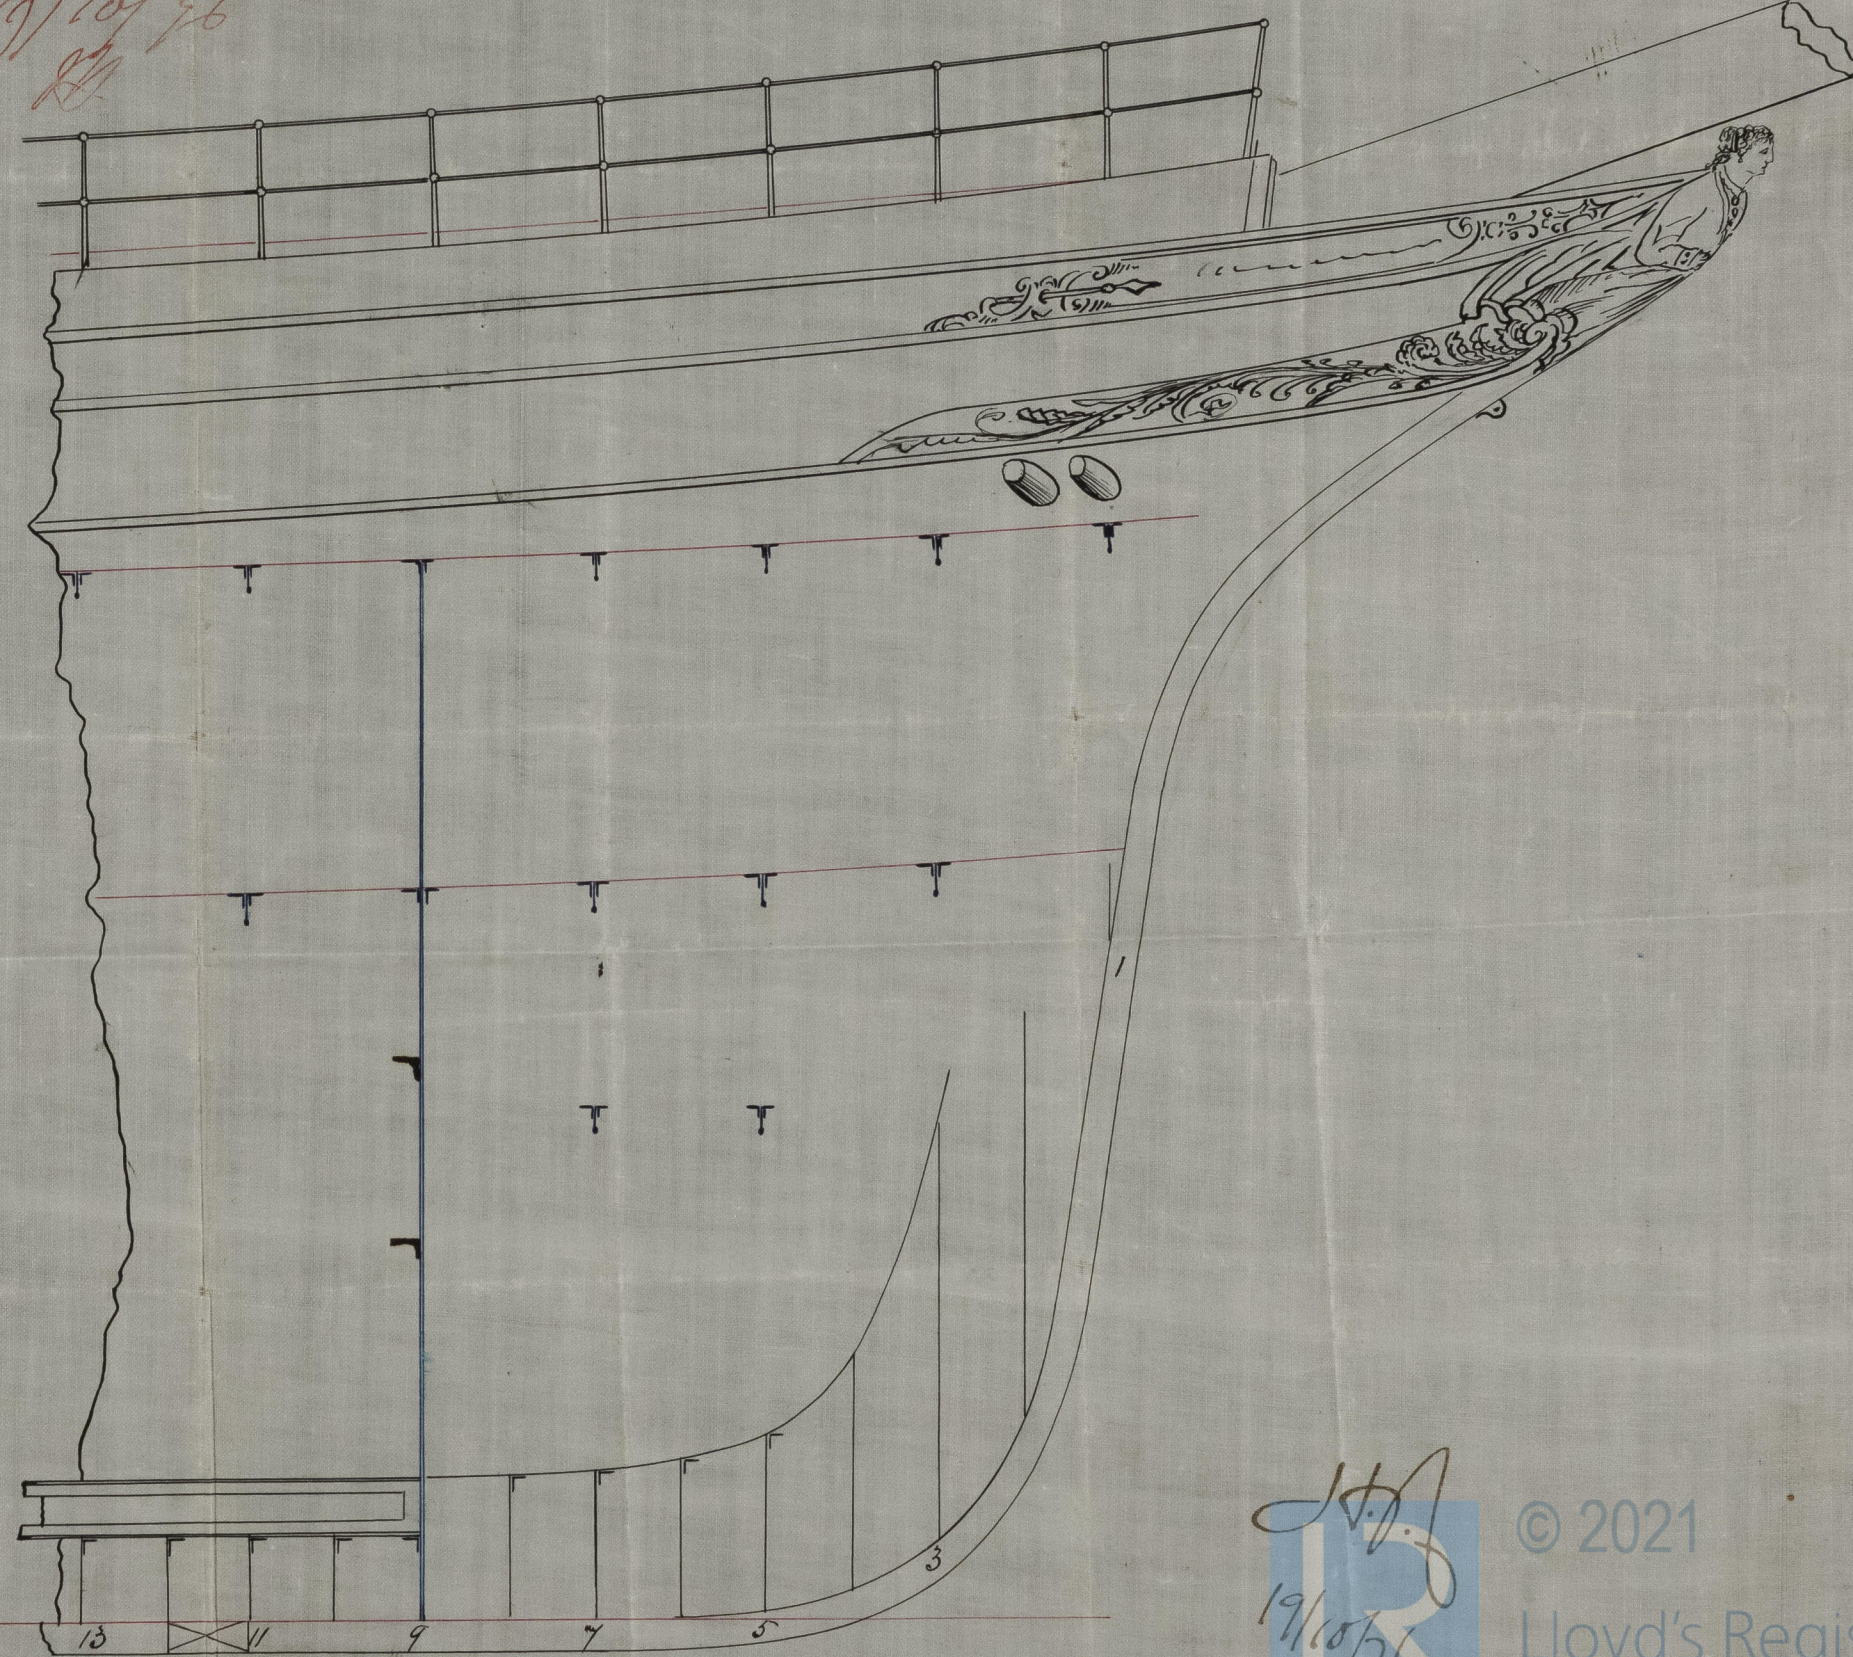

19/10/76

Lloyd's Register
Foundation

IRON 520-0068