


Rec 20/6/76
Rec 16/6/76

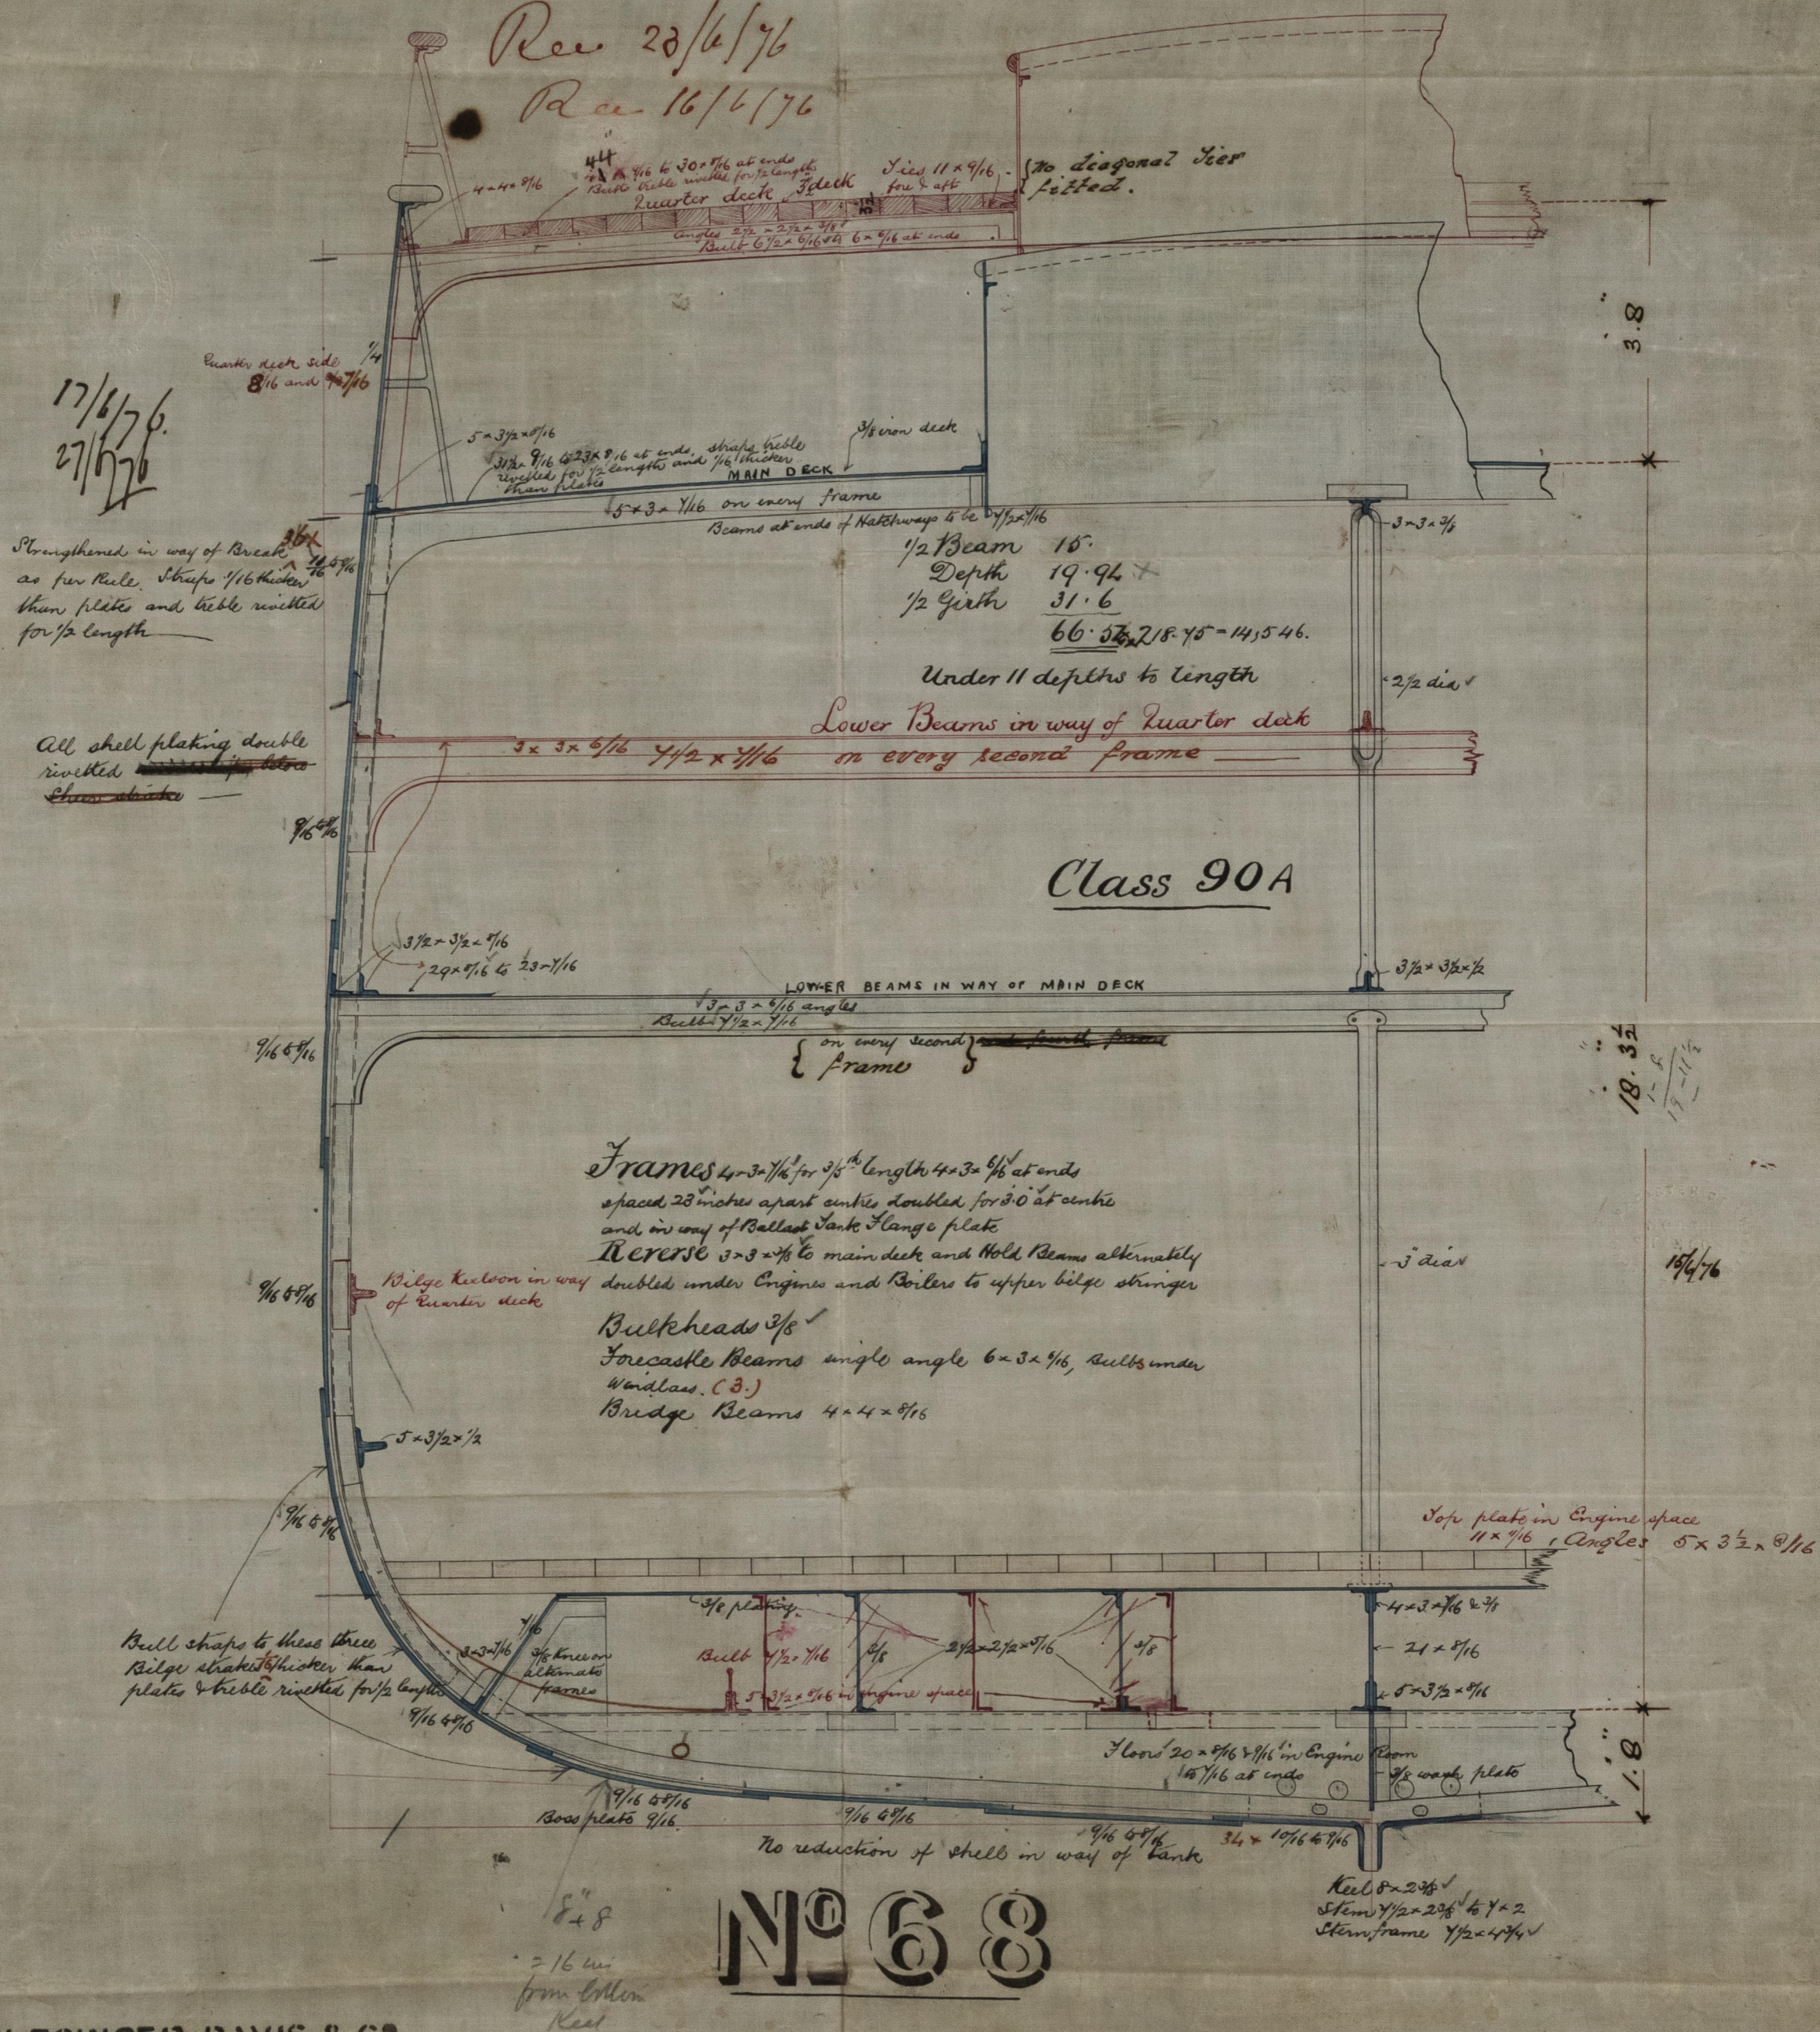

SCHLESINGER, DAVIS & CO.
IRON SHIP BUILDERS,
WALLSEND,
NEWCASTLE-ON-TYNE.

13./6./46.

SCALE $\frac{1}{2}$ INCH TO THE FOOT

IRON 520 - 0083