


100 A Arwing, Decked.

ENGINE AND BOILER CASING PLAN No 113

SCALE $\frac{1}{2}$ INCH = 1 FOOT

Iron S. S. Sylph's problem. Report No. 11.444

Recd 24-9-75
11

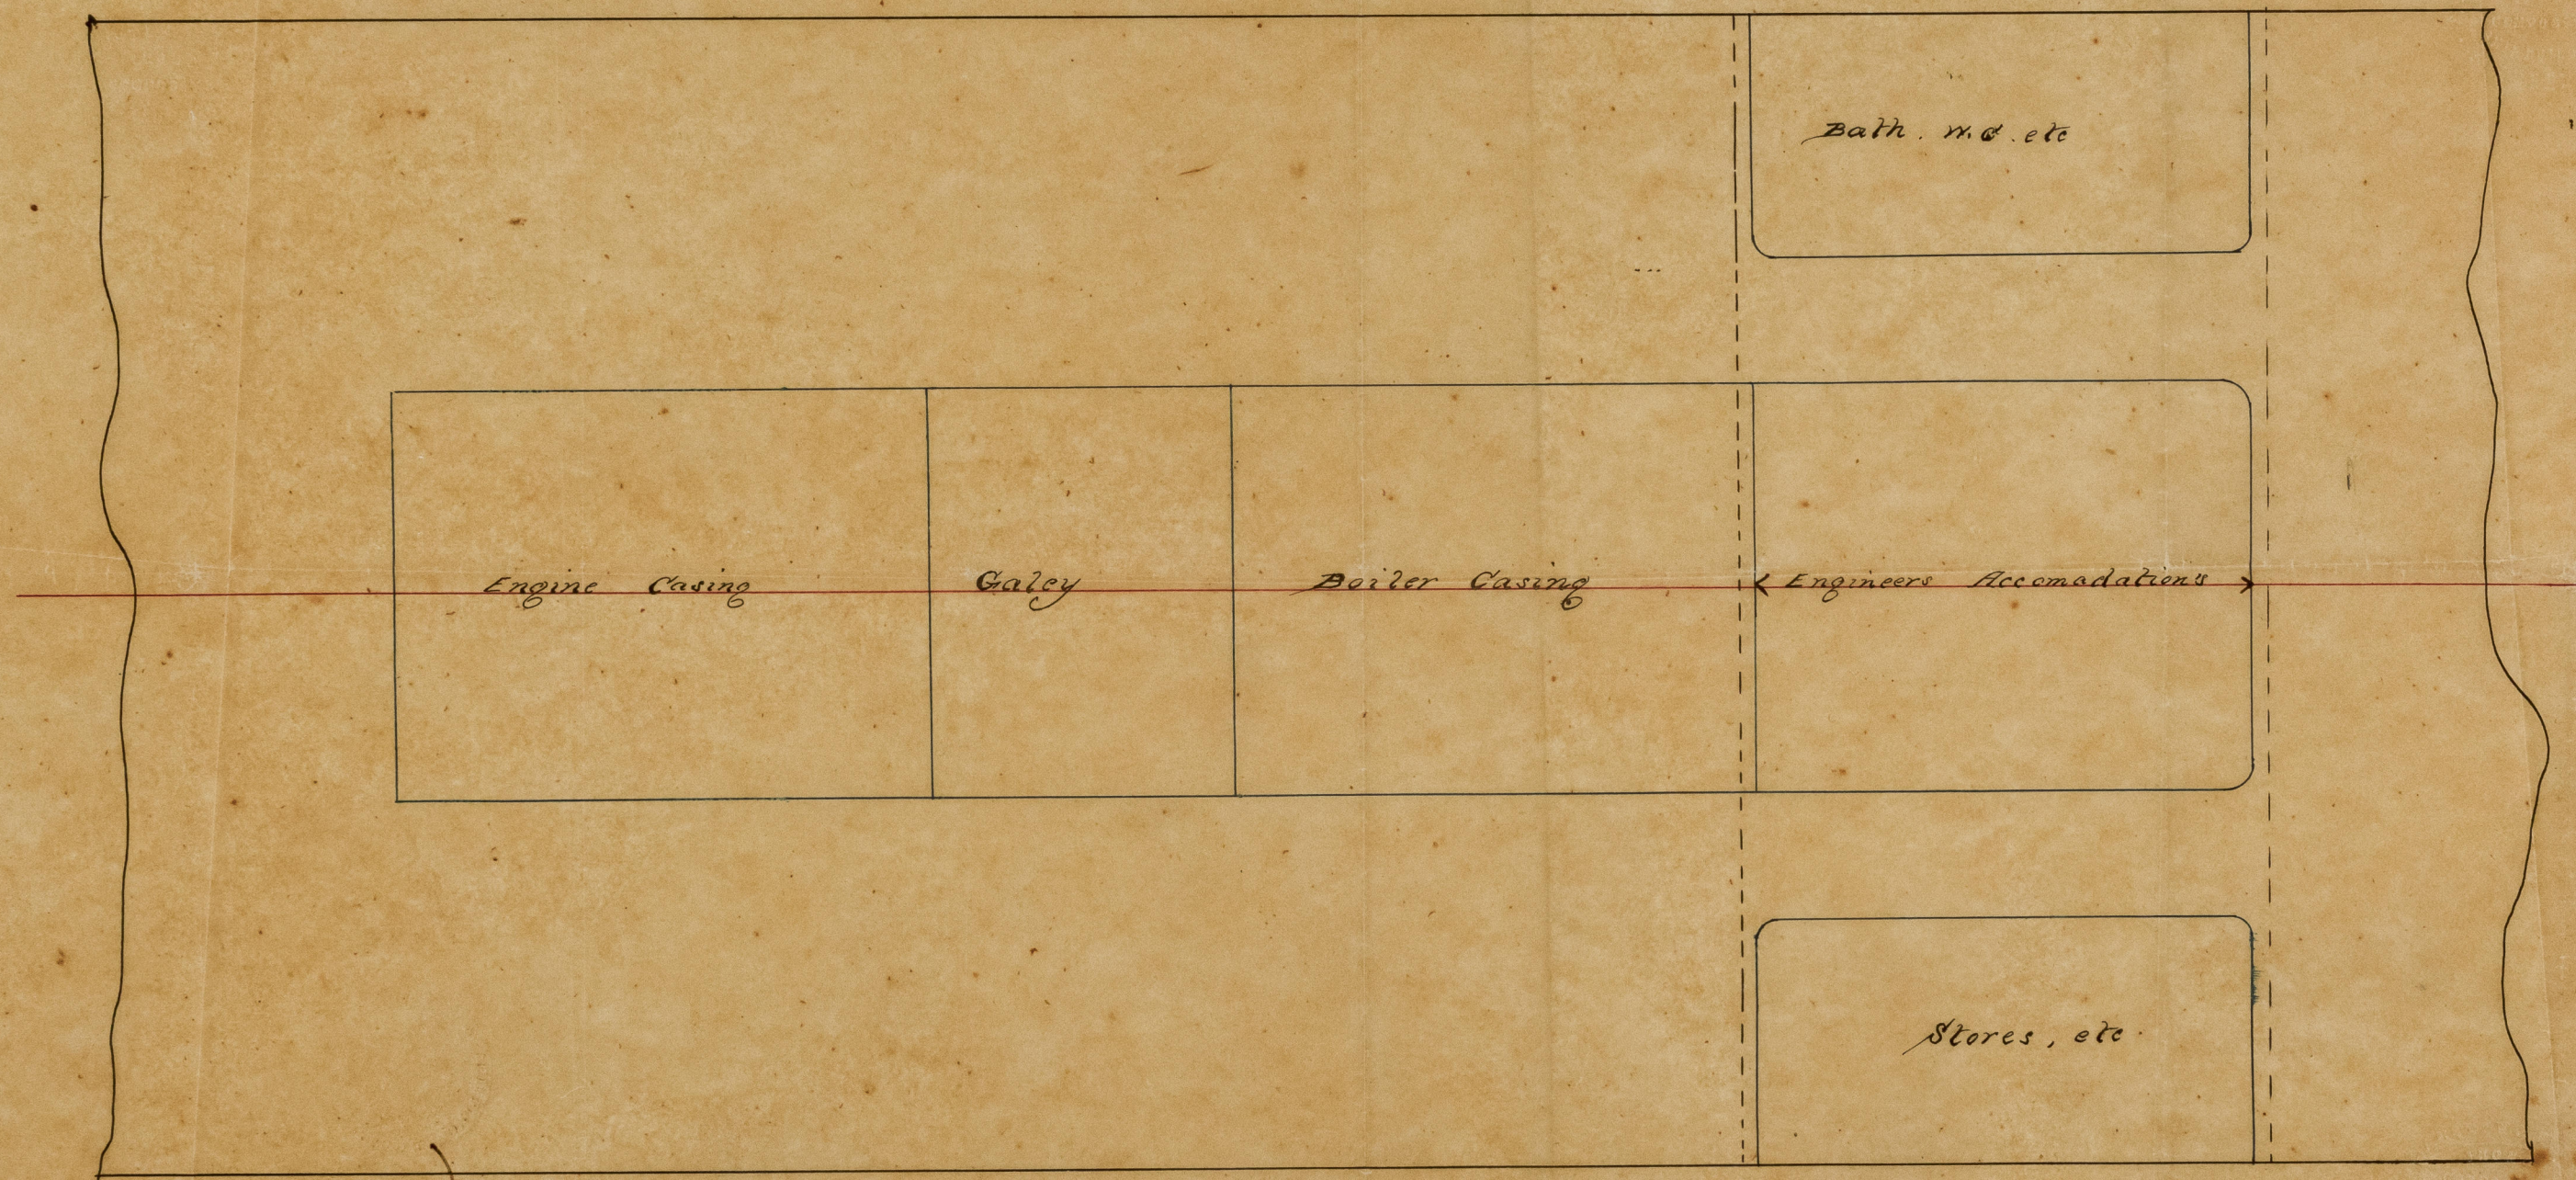

Re 27/9/75



© 2021

Lloyd's Register
Foundation

IRON 520 - 0100