


See Sunderland Surveyors'  
letter 12/2/77.

S.L. Thompson's 132 and 134

see L: 13/4/77


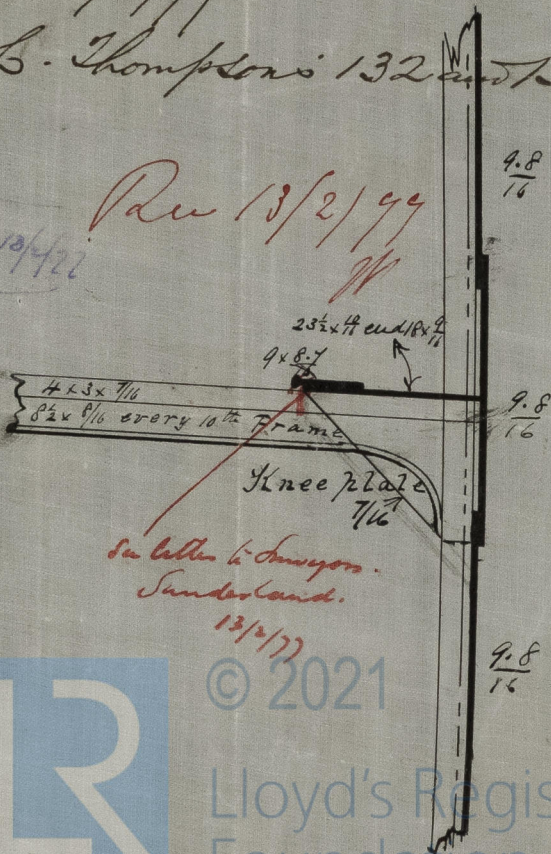

See letter to Surveyors.  
Sunderland.

13/2/77

SL

12/2/77

© 2021

Lloyd's Register  
Foundation

IRON 520-0127