


Dec 11/12/76 & 13/2/77 & 1/3/77
H

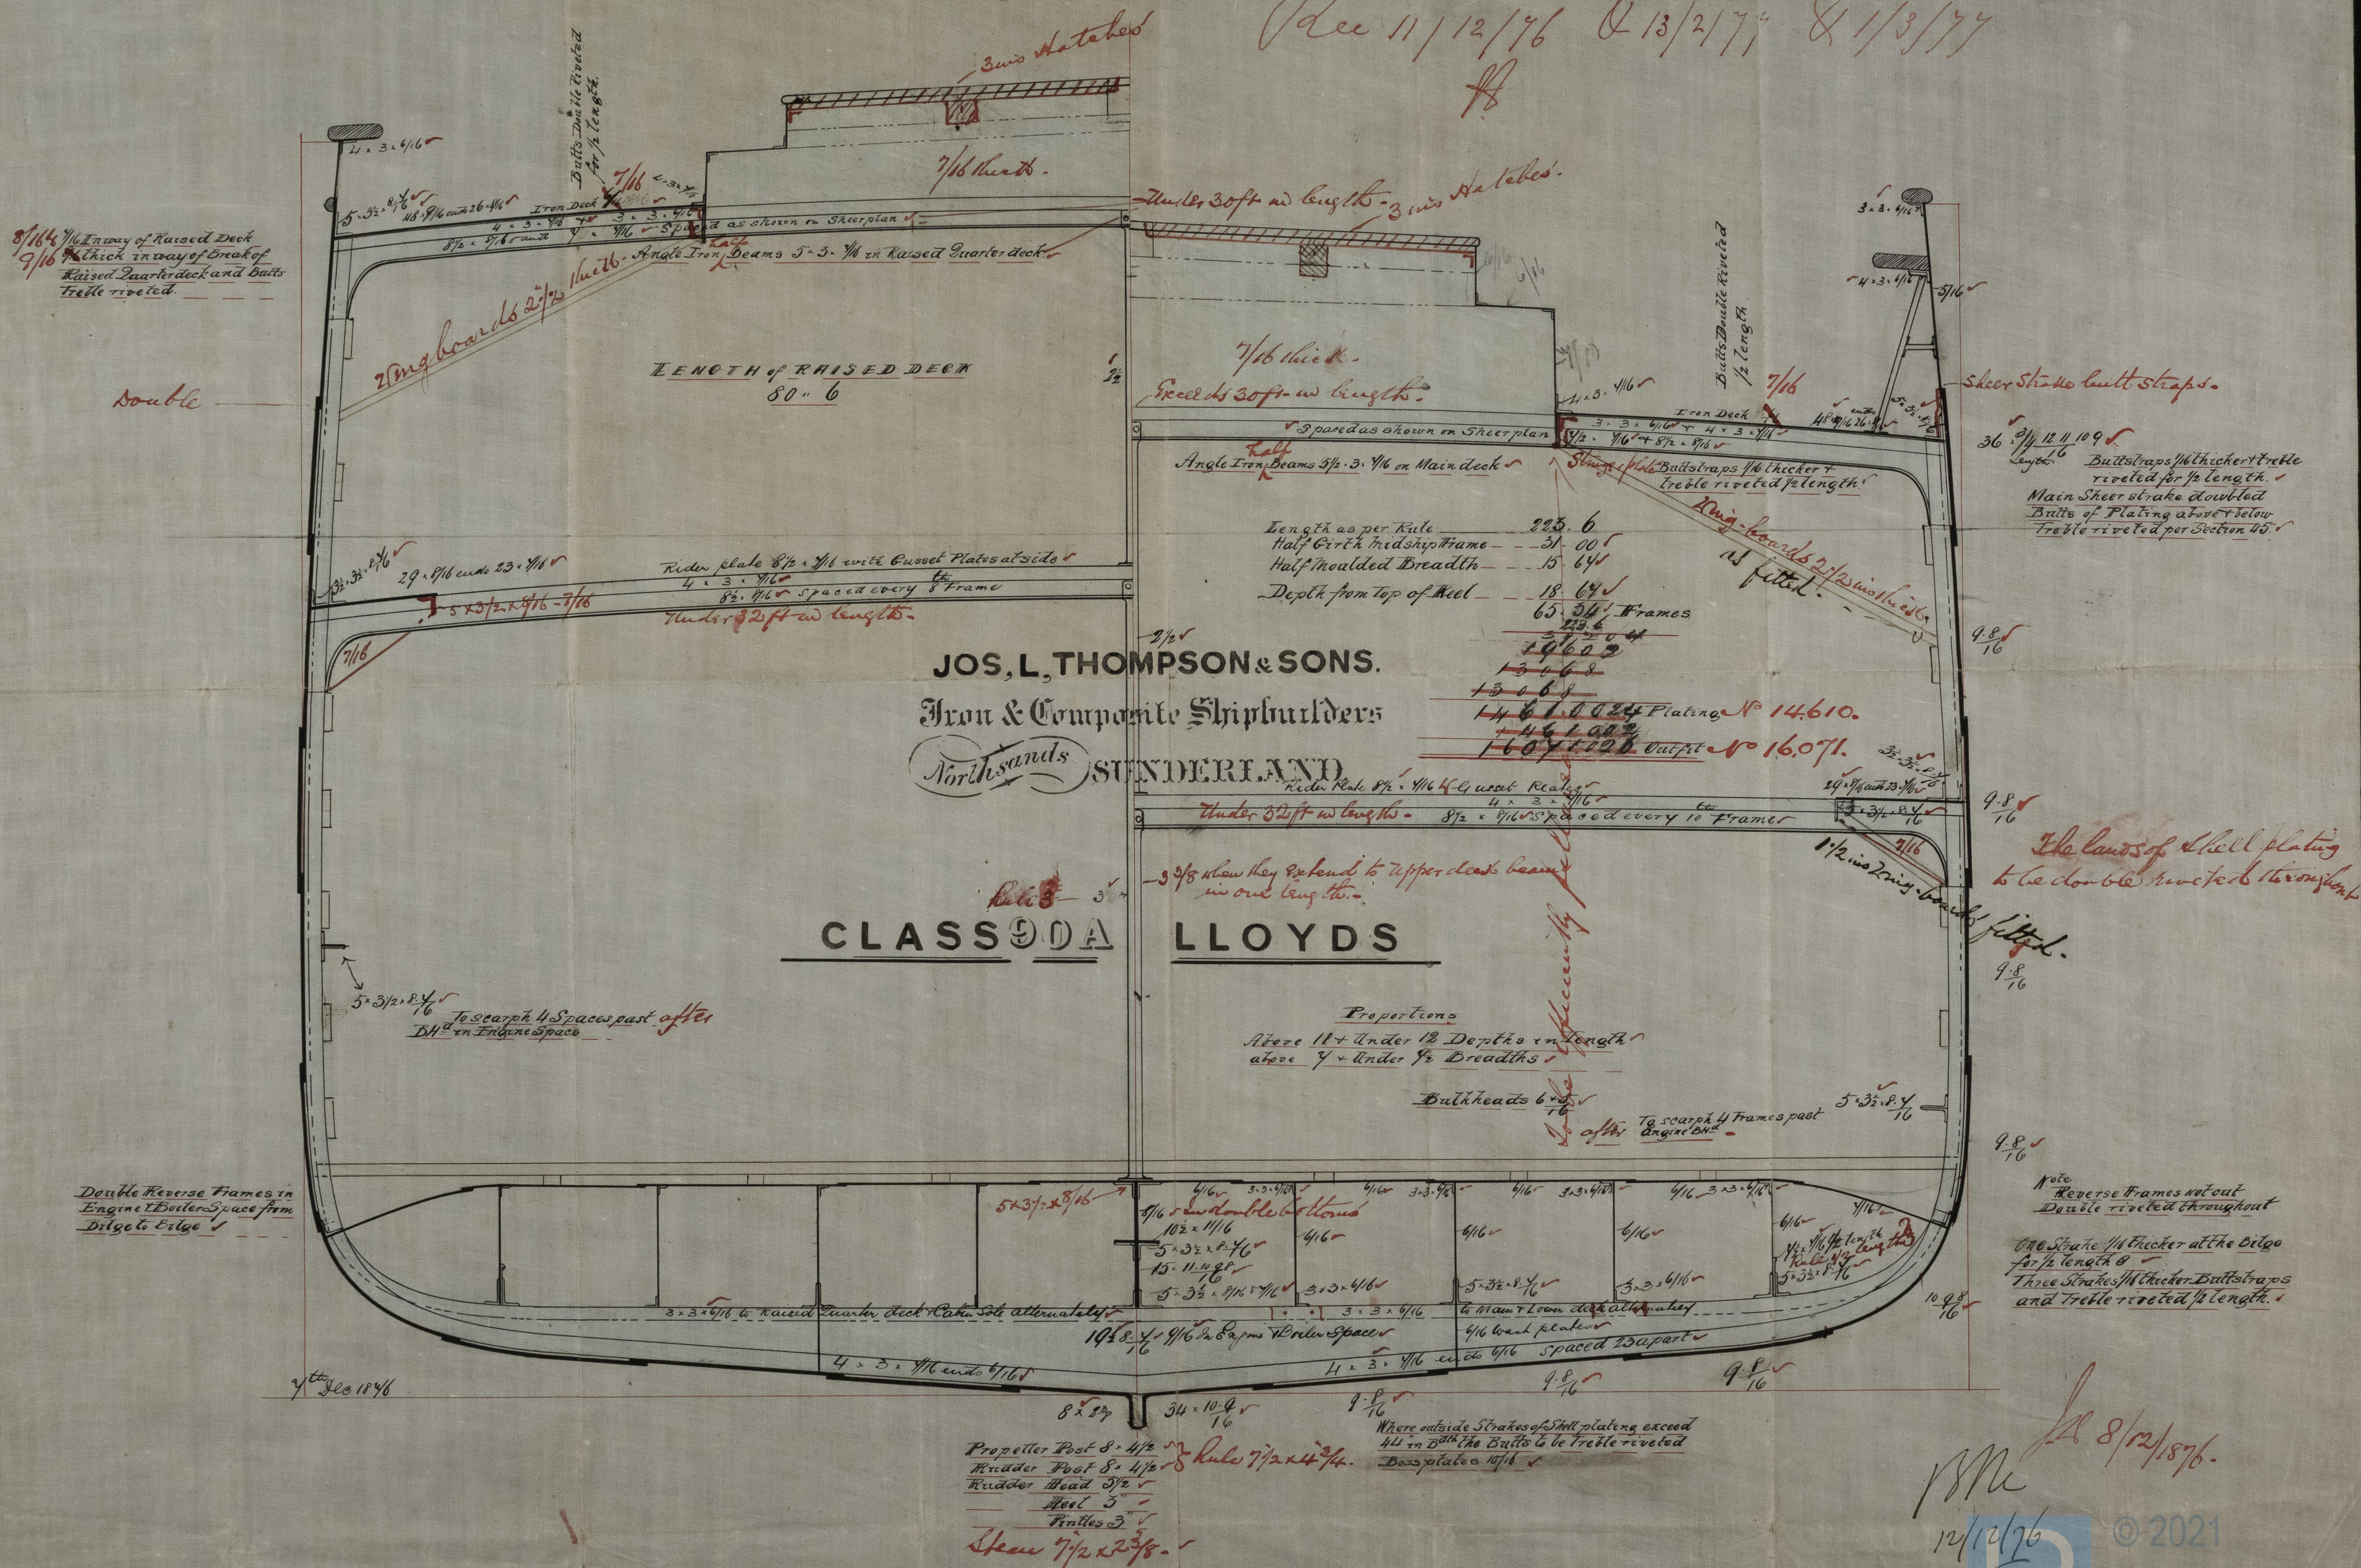

Scale $\frac{1}{2}$ of an Inch to a Foot

IRON 520-0128