SCREW STEAMER

No 132.

JOS. L. THOMPSON & SONS.

Iron & Composite Shipbuilders

SUNDERLAND.

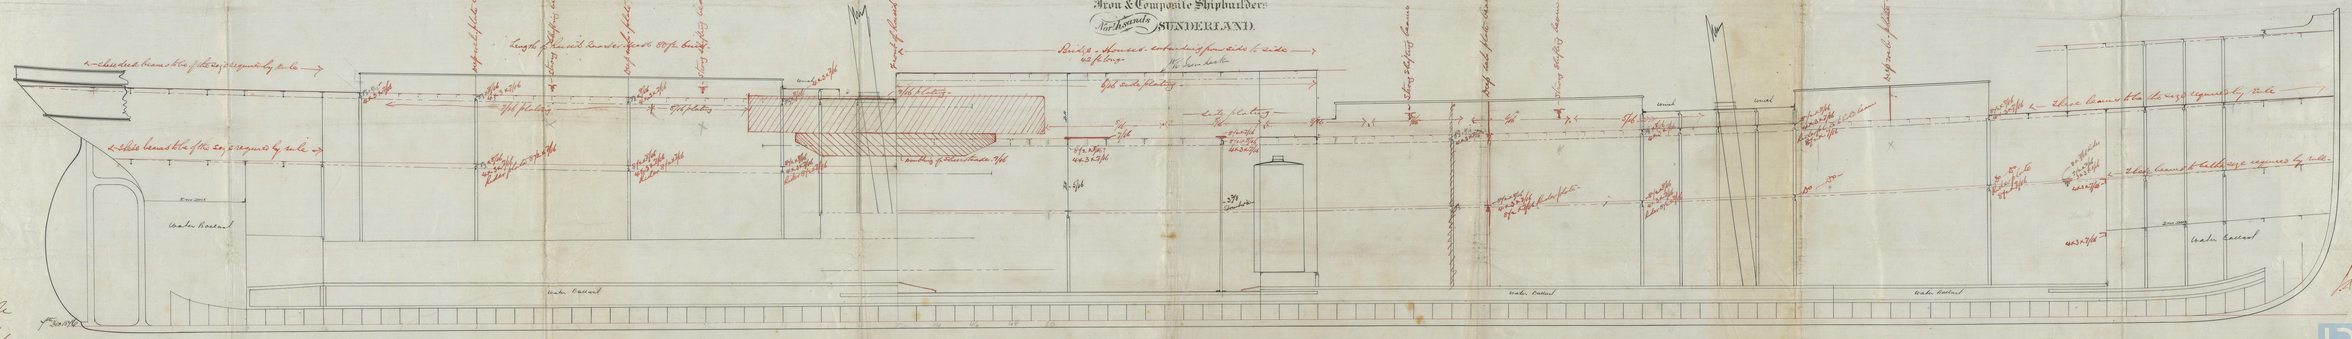

Scale 1/4 of an Inch to a Foot