

Midship Section of SS No 1 "LOCH NELL"


Scale $\frac{3}{4}" = 1 \text{ foot}$

To be built by H. Macintyre & Co. — Paisley.

90. A

Glasgow Report No 4433

See 7/11/96

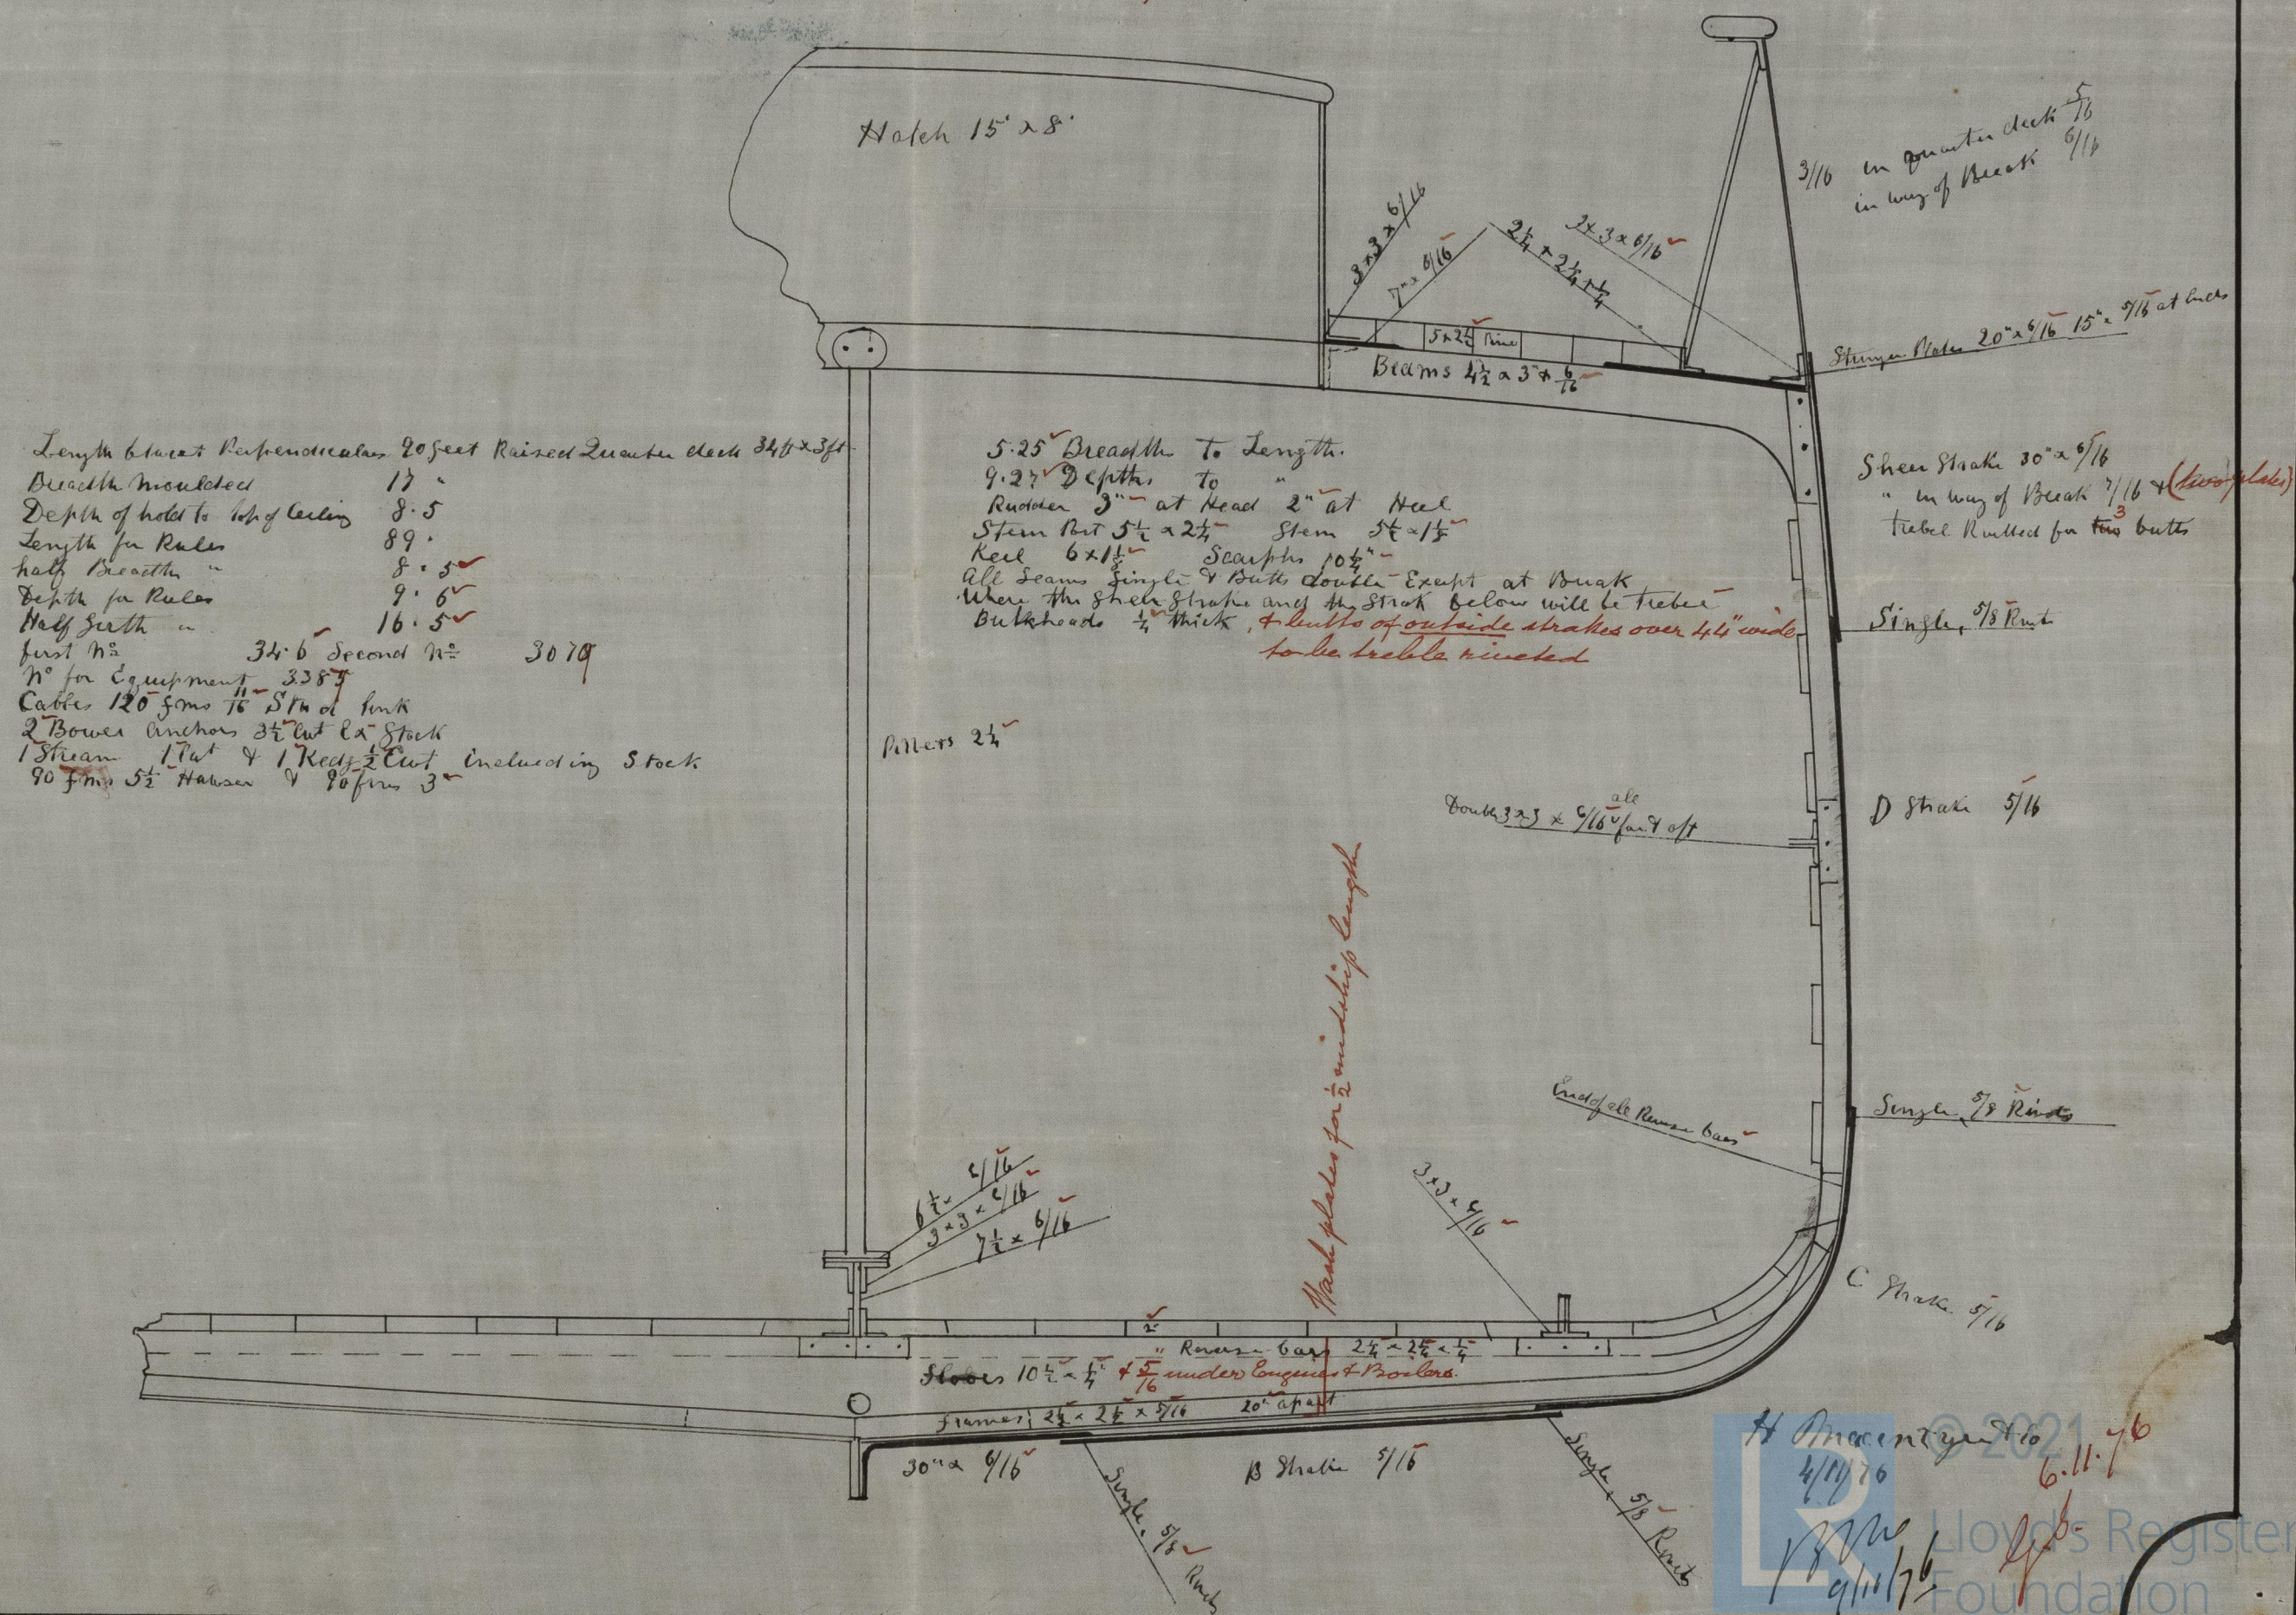

IRON 520 - 0135